

川向町南耕地地区土地区画整理事業

町名	地番	ページ
地区全体図		2
東方町	162 1	3
	162 2	3
	162 3	3
川向町	2000 1	3
	2000 2	3
	2000 3	3
	2000 4	3
	2001 1	4
	2001 2	4
	2001 3	4
	2001 4	4
	2001 5	4
	2001 6	4
	2001 7	4
	2001 8	4
	2001 9	4
	2001 10	4
	2001 11	4
	2001 12	4
	2001 13	4
	2001 14	4
	2001 15	4
	2001 16	4
	2001 17	4
	2001 18	4
	2001 19	4
	2001 20	4
2001 21	4	
2001 22	4	
2001 23	4	
2001 24	4	

町名	地番	ページ
川向町	2001 25	4
	2001 26	4
	2001 27	4
	2001 28	4
	2001 29	4
	2001 30	4
	2001 31	4
	2001 32	4
	2001 33	4
	2001 34	4
	2001 35	4
	2001 36	4
	2001 37	4
	2001 38	4
	2001 39	4
	2001 40	4
	2001 41	4
	2001 42	4
	2001 43	4
	2001 44	4
	2001 45	4
	2001 46	4
	2001 47	4
	2001 48	4
	2002 1	6
	2002 2	6
	2002 3	6
	2002 4	6
	2002 5	6
	2002 6	6
	2002 7	6
	2002 8	6

町名	地番	ページ
川向町	2002 9	6
	2003 1	7
	2003 2	7
	2003 3	7
	2003 4	7
	2003 5	7
	2003 6	7
	2003 7	7
	2003 8	7
	2003 9	7
	2003 10	7
	2003 11	7
	2003 12	7
	2003 13	7
	2003 14	7
	2003 15	7
	2003 16	7
	2003 17	7
	2003 18	7
	2003 19	7
	2004 1	11
	2004 2	11
	2005 1	8
	2005 2	8
2005 3	8	
2005 4	8	
2005 5	8	
2005 6	8	
2005 7	8	
2005 8	8	
2005 9	8	
2005 10	8	

川向町南耕地地区土地区画整理事業



町名	地番	ページ
川向町	2005 11	8
	2005 12	8
	2005 13	8
	2005 14	8
	2005 15	8
	2005 16	8
	2005 17	8
	2005 18	8
	2005 19	8
	2005 20	8
	2005 21	8
	2005 22	8
	2005 23	8
	2006 1	9
	2006 2	9
	2006 3	9
	2006 4	9
	2006 5	9
	2006 6	9
	2006 7	9
	2006 8	9
	2006 9	9
	2006 10	9
	2006 11	9
	2007 1	9
	2007 2	9
	2007 3	9
	2007 4	9
	2008 1	9
	2008 2	9
	2008 3	9
	2008 4	9

町名	地番	ページ
川向町	2009 1	5
	2009 2	5
	2009 3	5
	2010 1	5
	2010 2	5
	2010 3	5
	2010 4	5
	2011 1	5
	2011 2	5
	2011 3	5
	2011 4	5
	2011 5	5
	2011 6	5
	2011 7	5
	2012 1	3
	2012 2	3
	2013 1	3
	2013 2	3
	2013 3	3
	2014	4
	2015	6
	2016	6
	2017	10
	2018	10
	2019	8
	2020	9
	2022	5
2023	5	
2024	4	

川向町南耕地地区土地区画整理事業
画地出来形確認測量図

世界測地系(測地成果2011)

縮尺 五百分之一

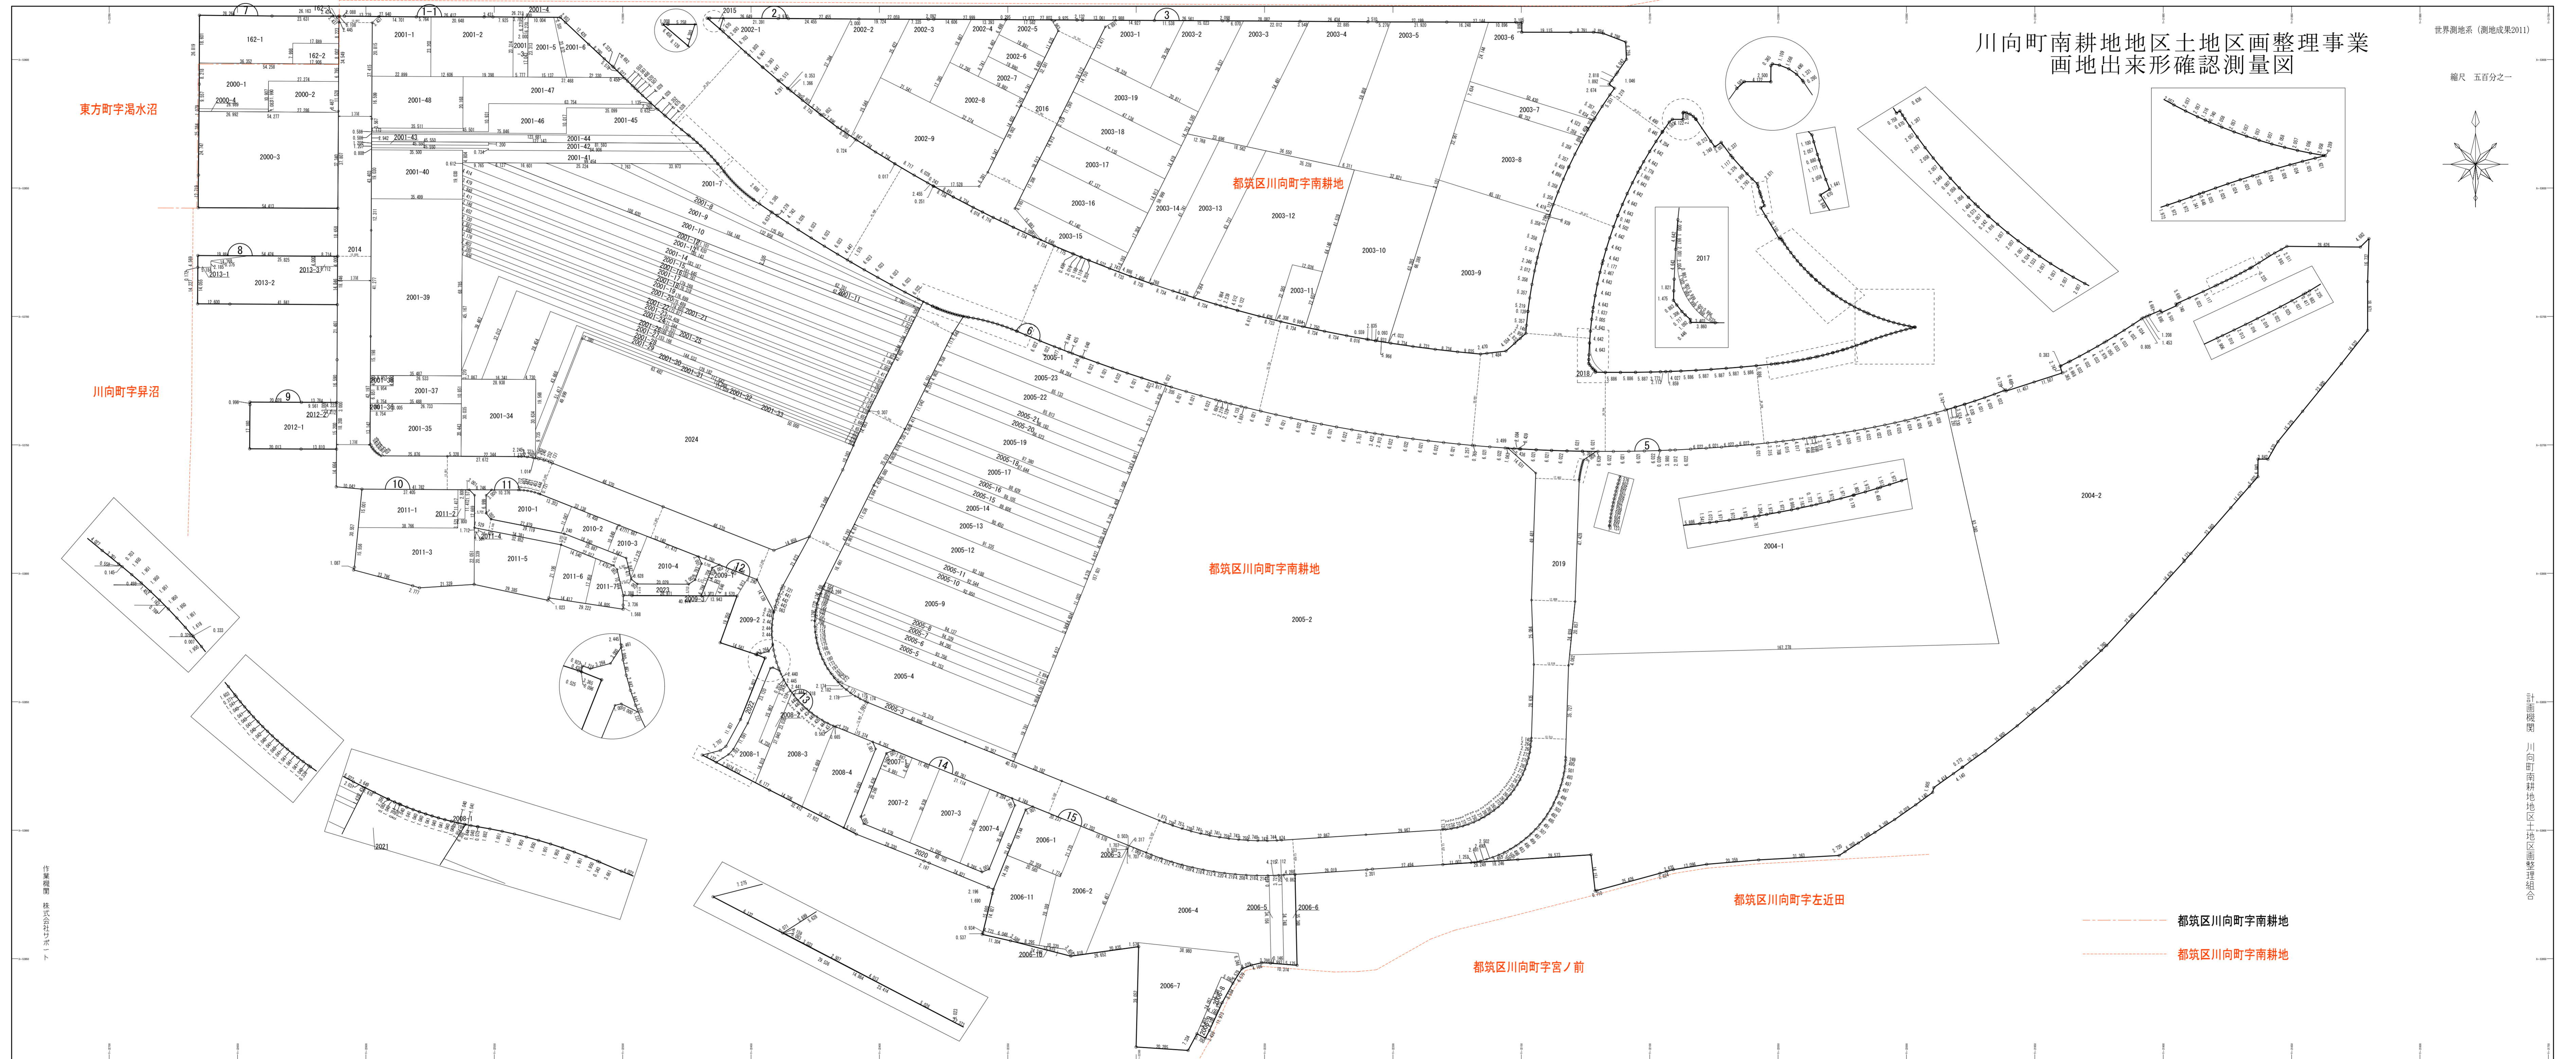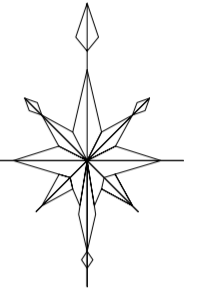

都筑区川向町字北耕地

都筑区川向町字南耕地

都筑区川向町字南耕地

都筑区川向町字左近田

都筑区川向町字宮ノ前

都筑区川向町字南耕地


都筑区川向町字南耕地

東方町字湯水沼


川向町字昇沼


Y=2100

東方町字渴水沼

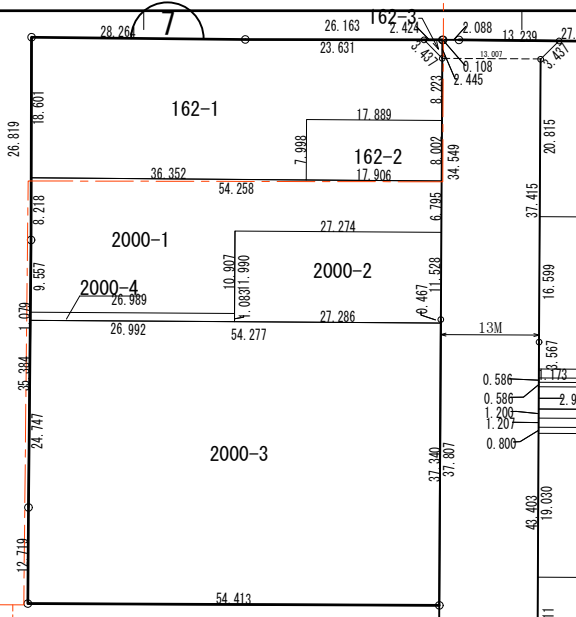


川向町字昇沼

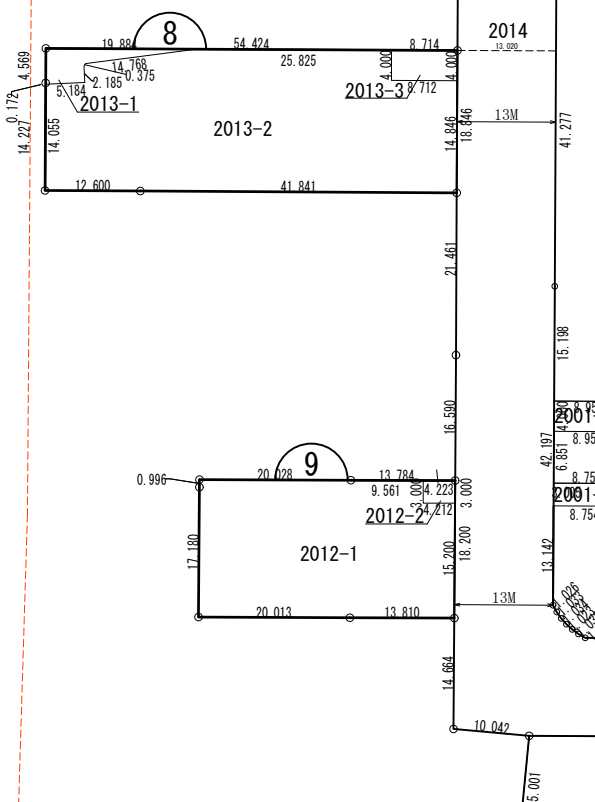


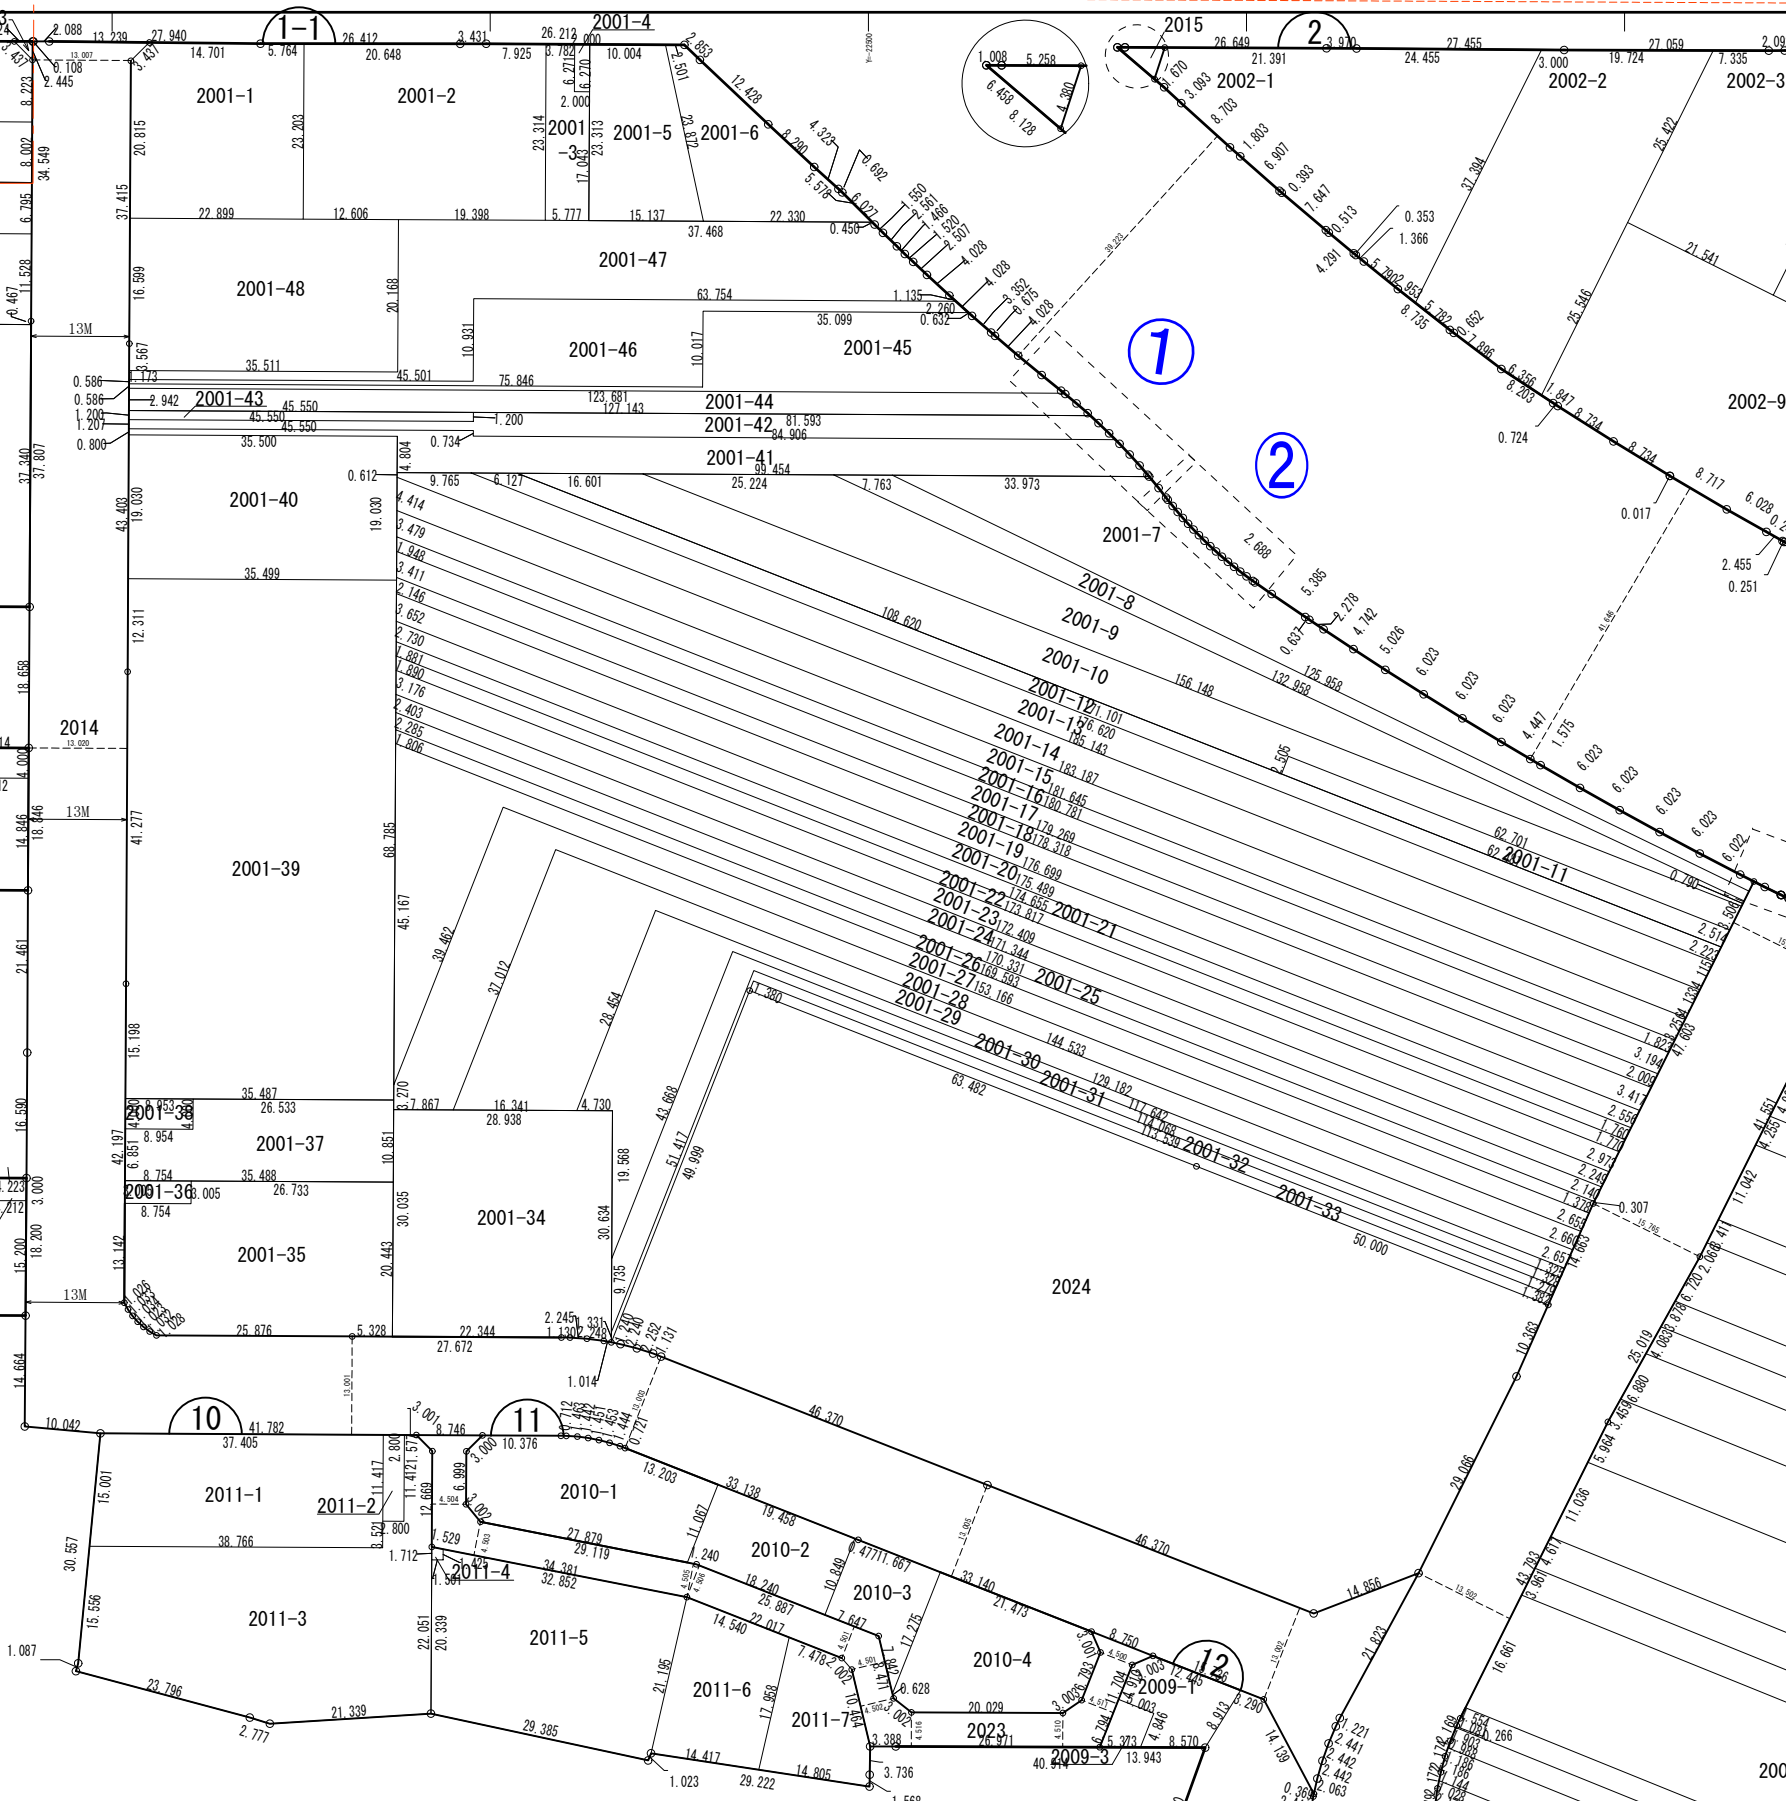

①

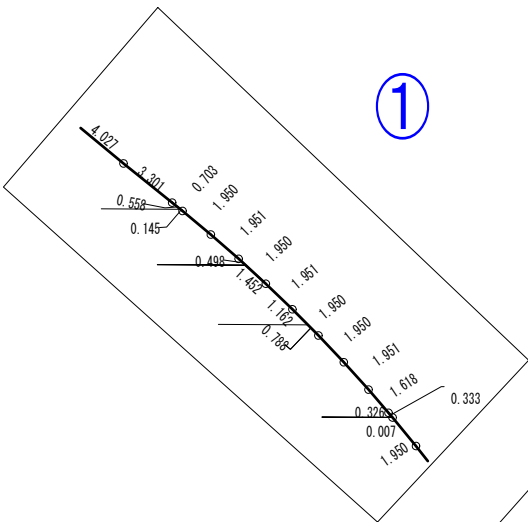


②

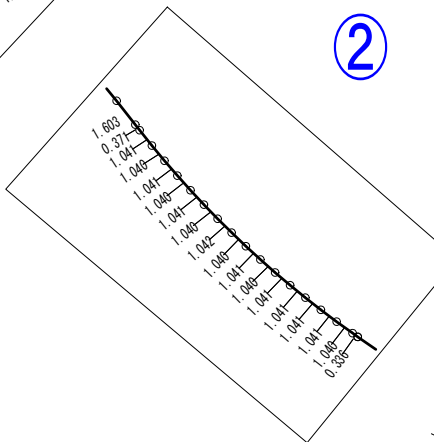

拡大図

都筑区川向町字北耕地

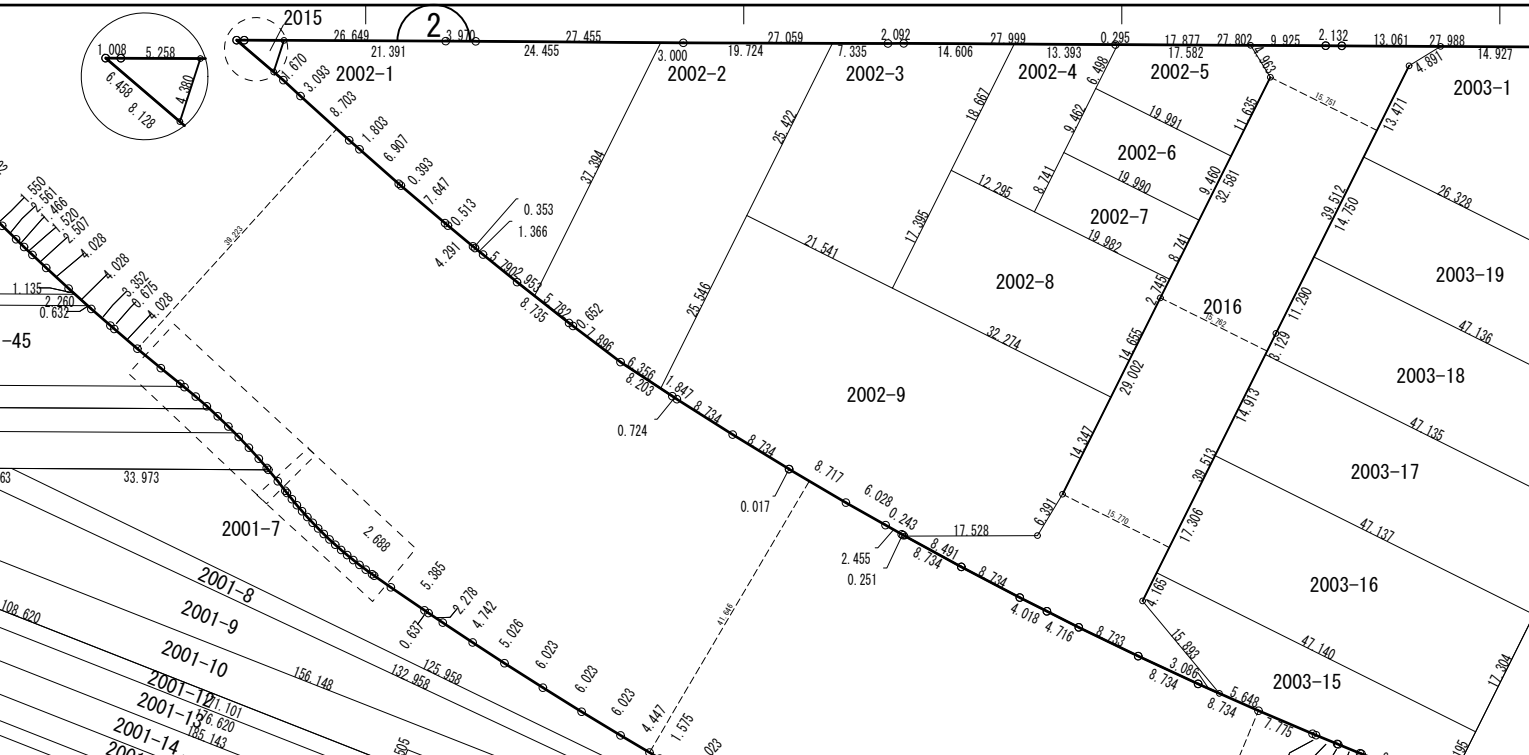



都筑区川向町字南耕地

3

6

18

2002-5

2003-1

2003-2

2003-3

2003-4

2003-5

2003-6

2003-19

2003-18

2003-17

2003-16

2003-15

2003-14

2003-13

2003-12

2003-11

2003-10


2003-9

2005-23


2005-1

2018

3

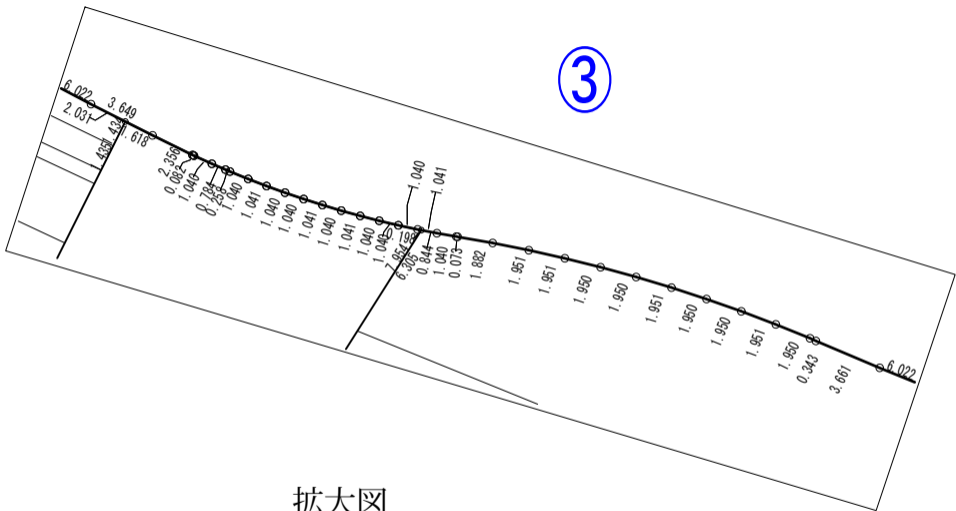

拡大図

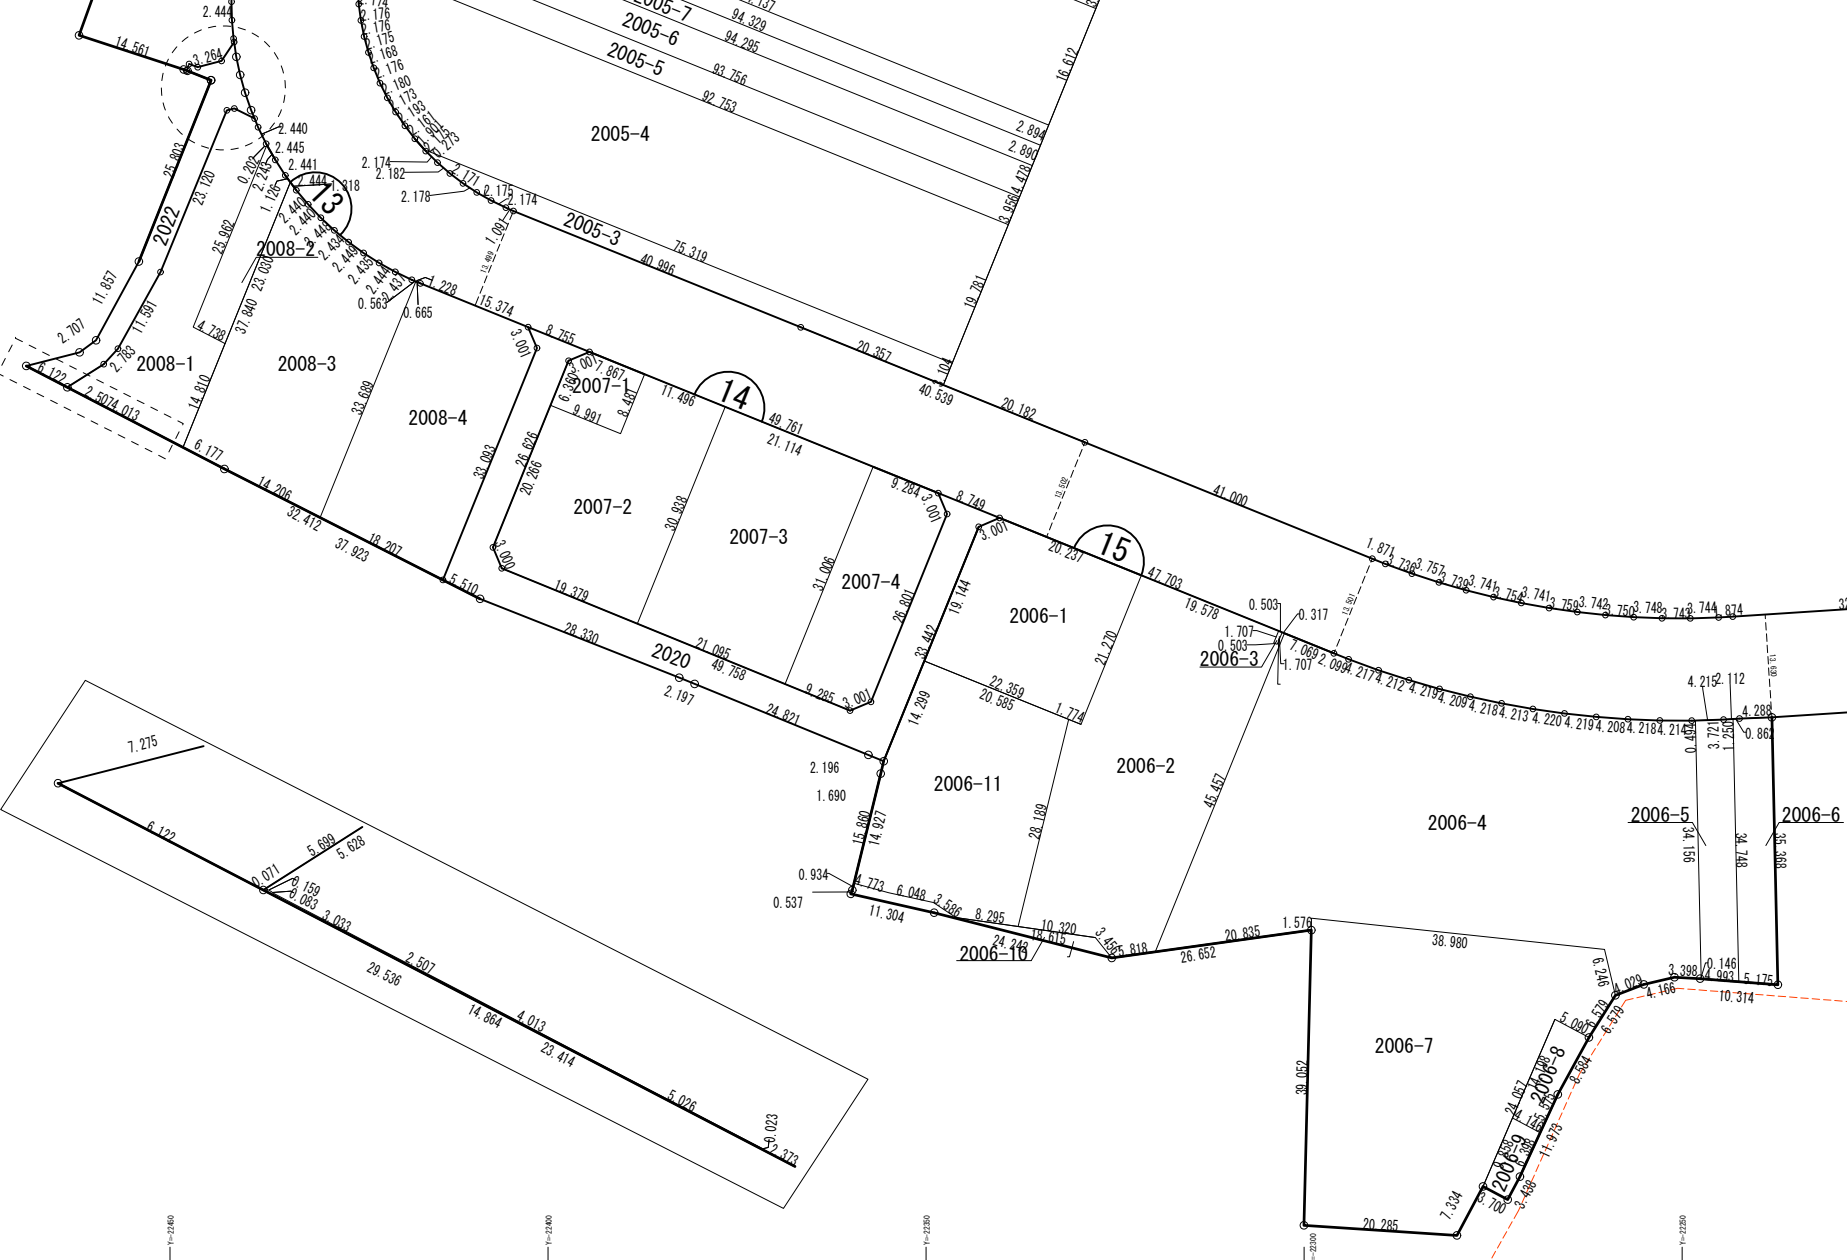

2005-4

2005-5

2005-6

2005-3

2005-7

2008-2

2008-1

2008-3

2008-4

2007-1

2007-2

2007-3

2007-4

2006-1

2020

2006-3

2006-11

2006-2

2006-4

2006-5

2006-6

2006-10

2006-7

2008-8

13

14

15

7.275

6.122

5.071

3.159

3.085

3.032

2.507

29.536

14.864

4.012

23.414

5.026

40.023

7.372

14-2180

14-2180

14.561

2.444

2.284

25.801

23.720

25.982

2.440

2.445

2.441

2.440

2.440

2.174

2.182

2.178

2.177

2.179

2.174

2.174

2.182

2.178

2.177

2.179

2.174

2.174

都筑区川向町字左近田