




赤字は、頁（ページ）
番号になります。

平安地区

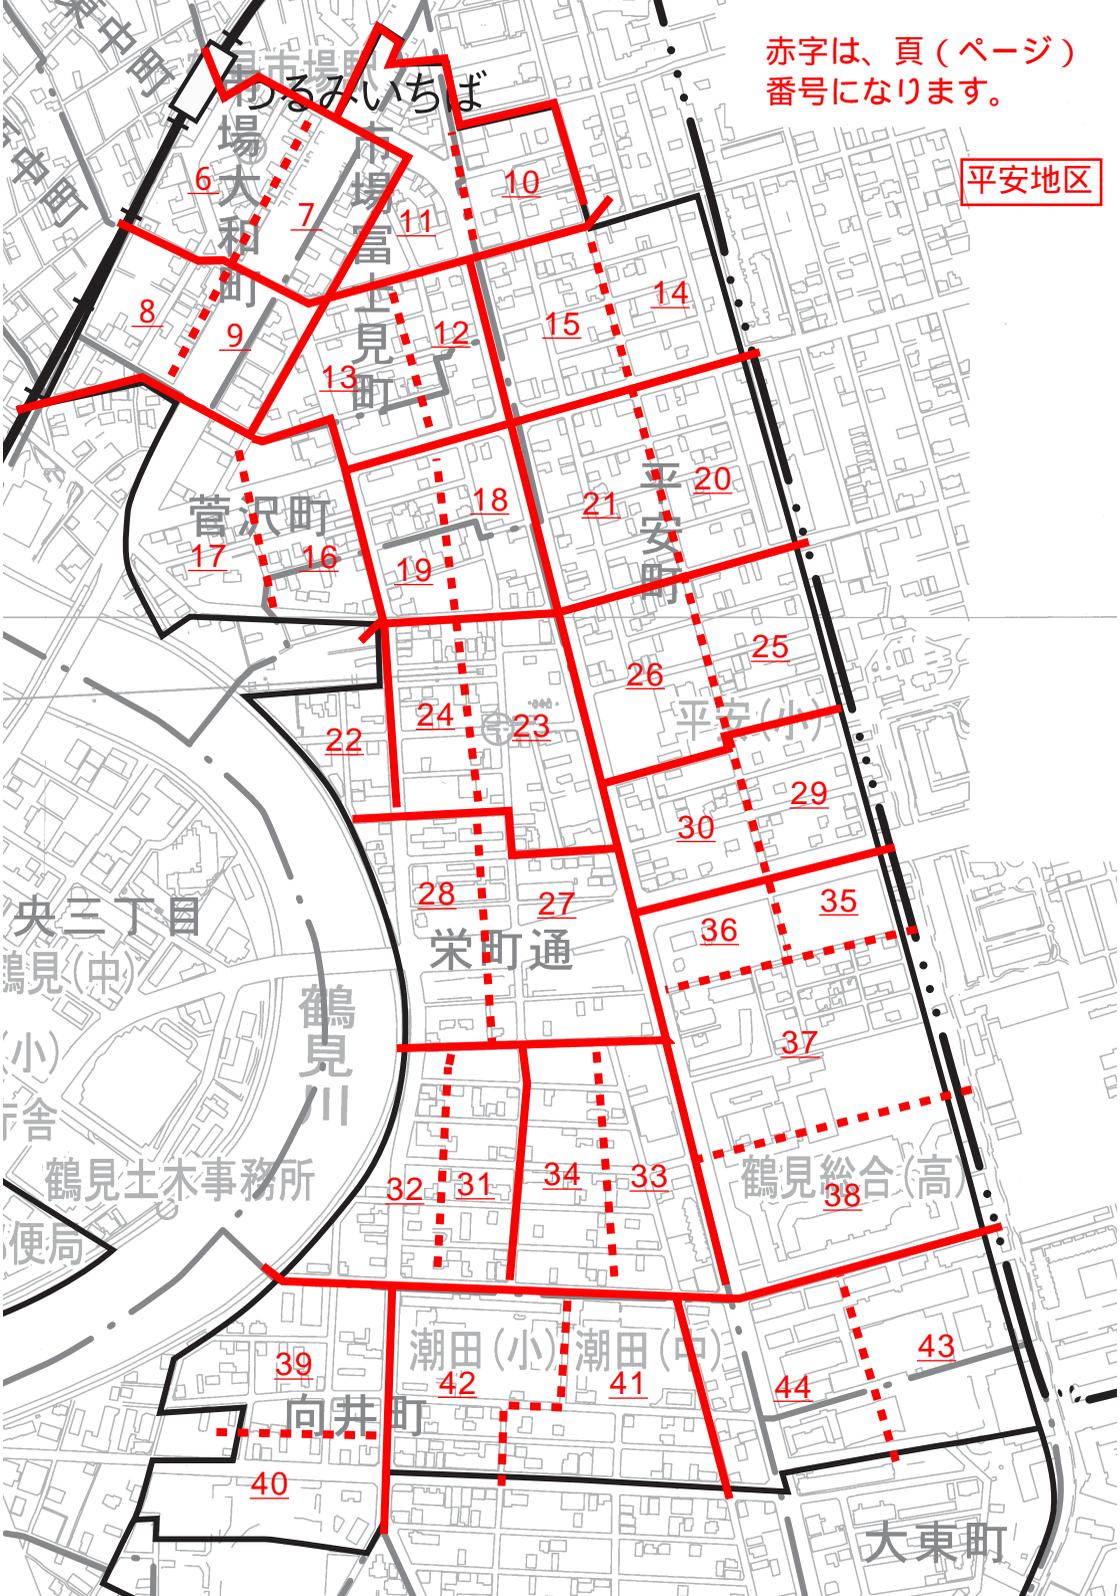

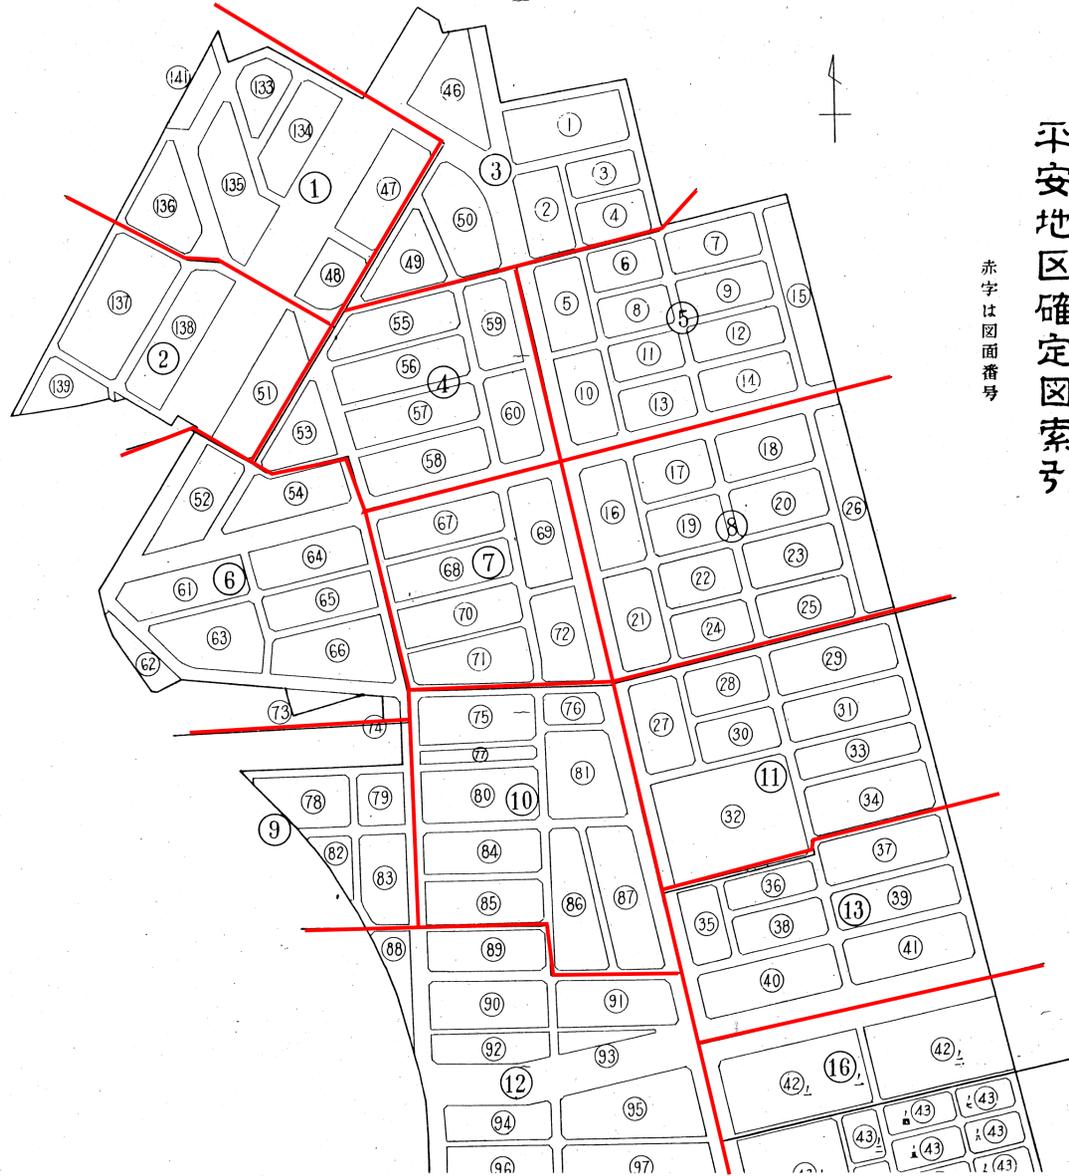


平安地区確定図索引
赤字は図面番号

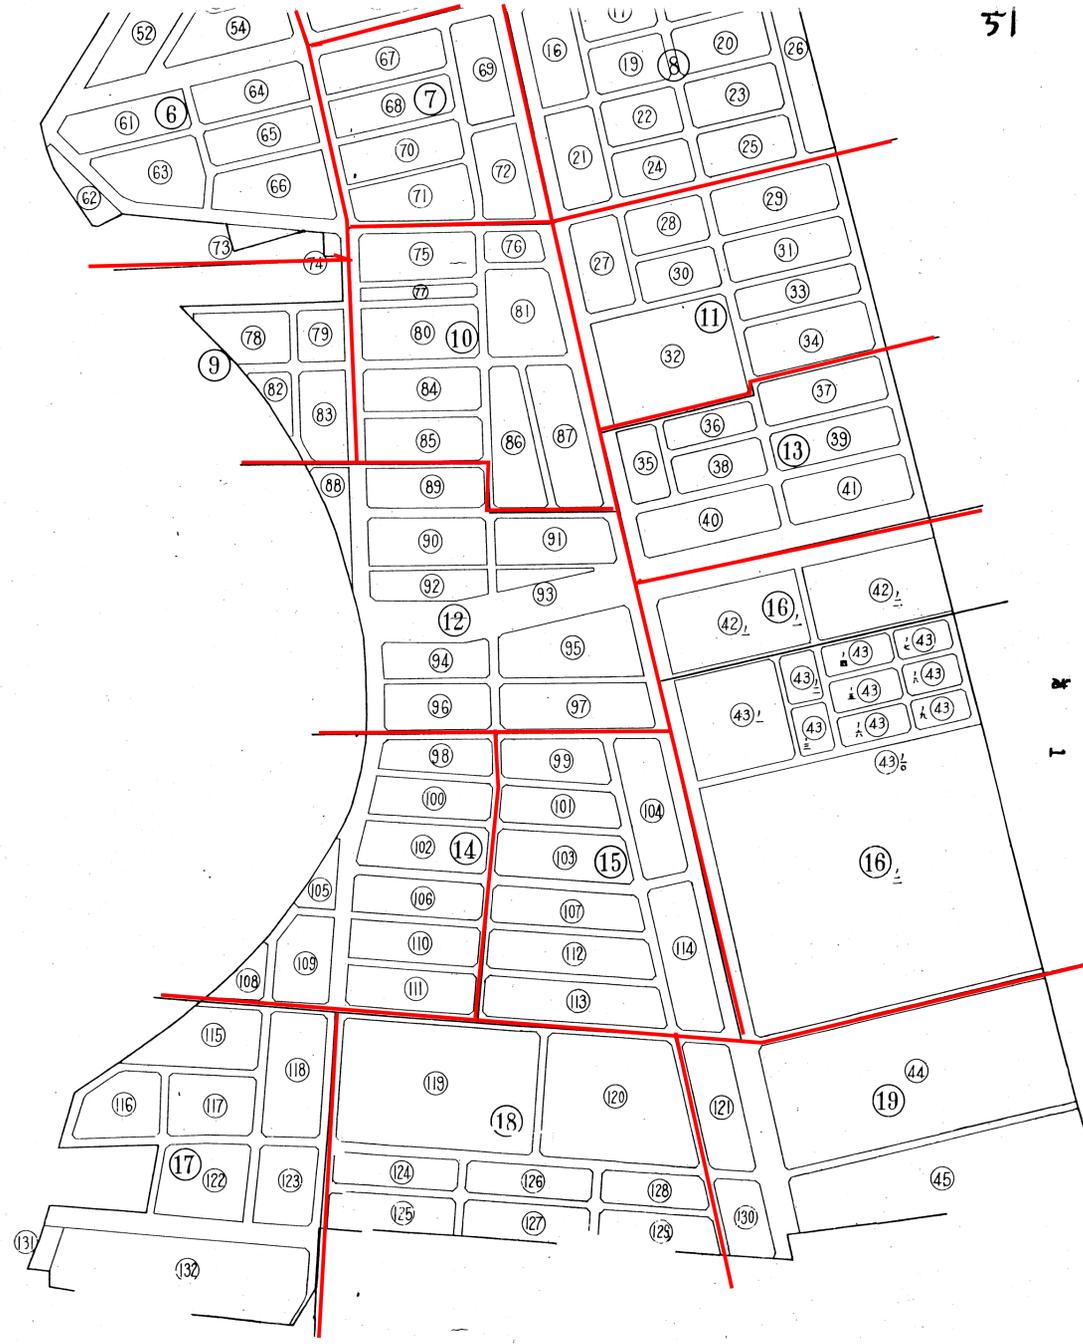


51

6-1

1

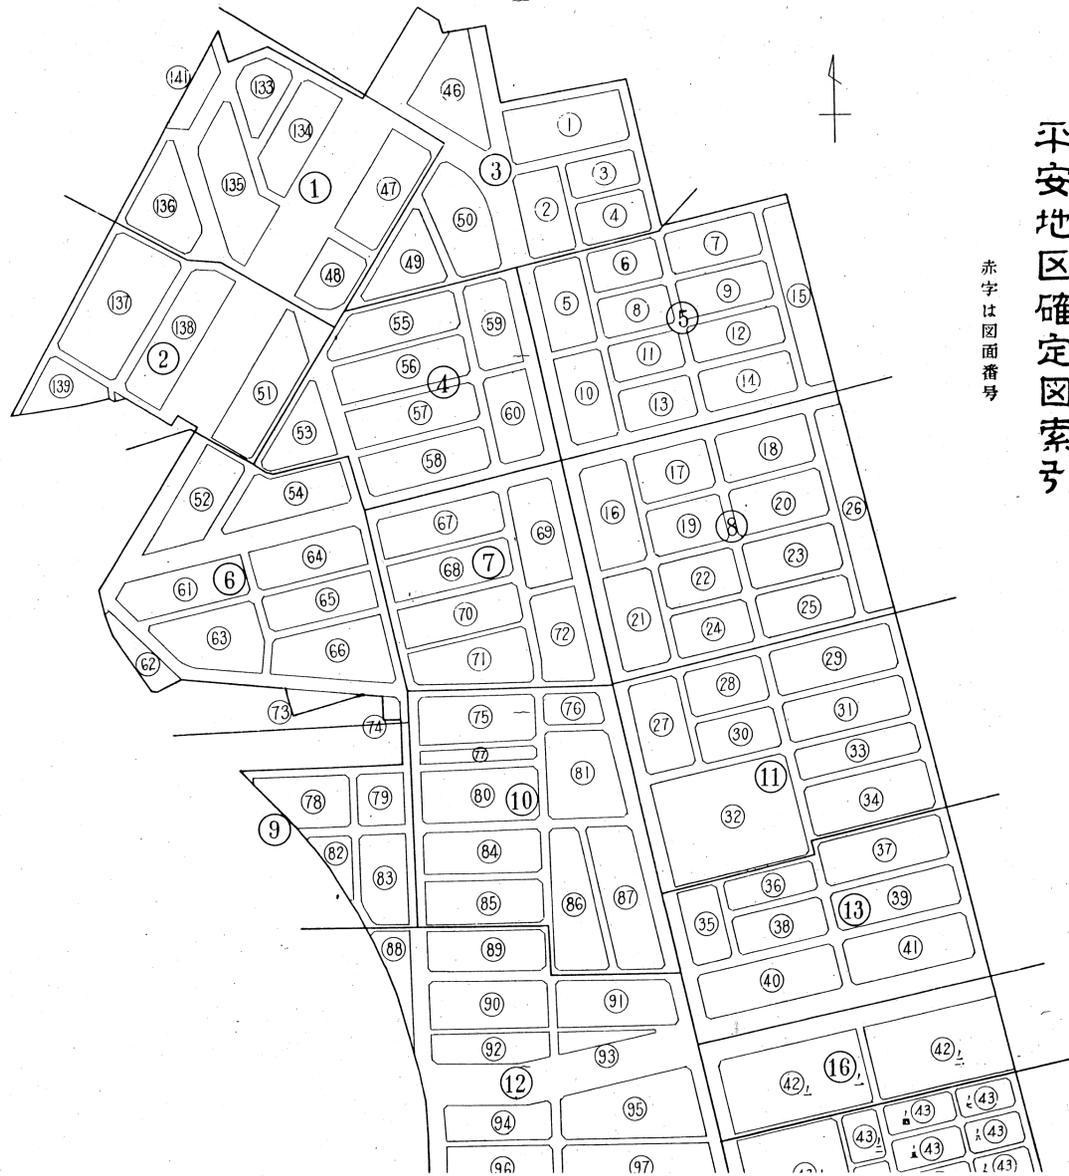

平安地区確定図索引
赤字は図面番号

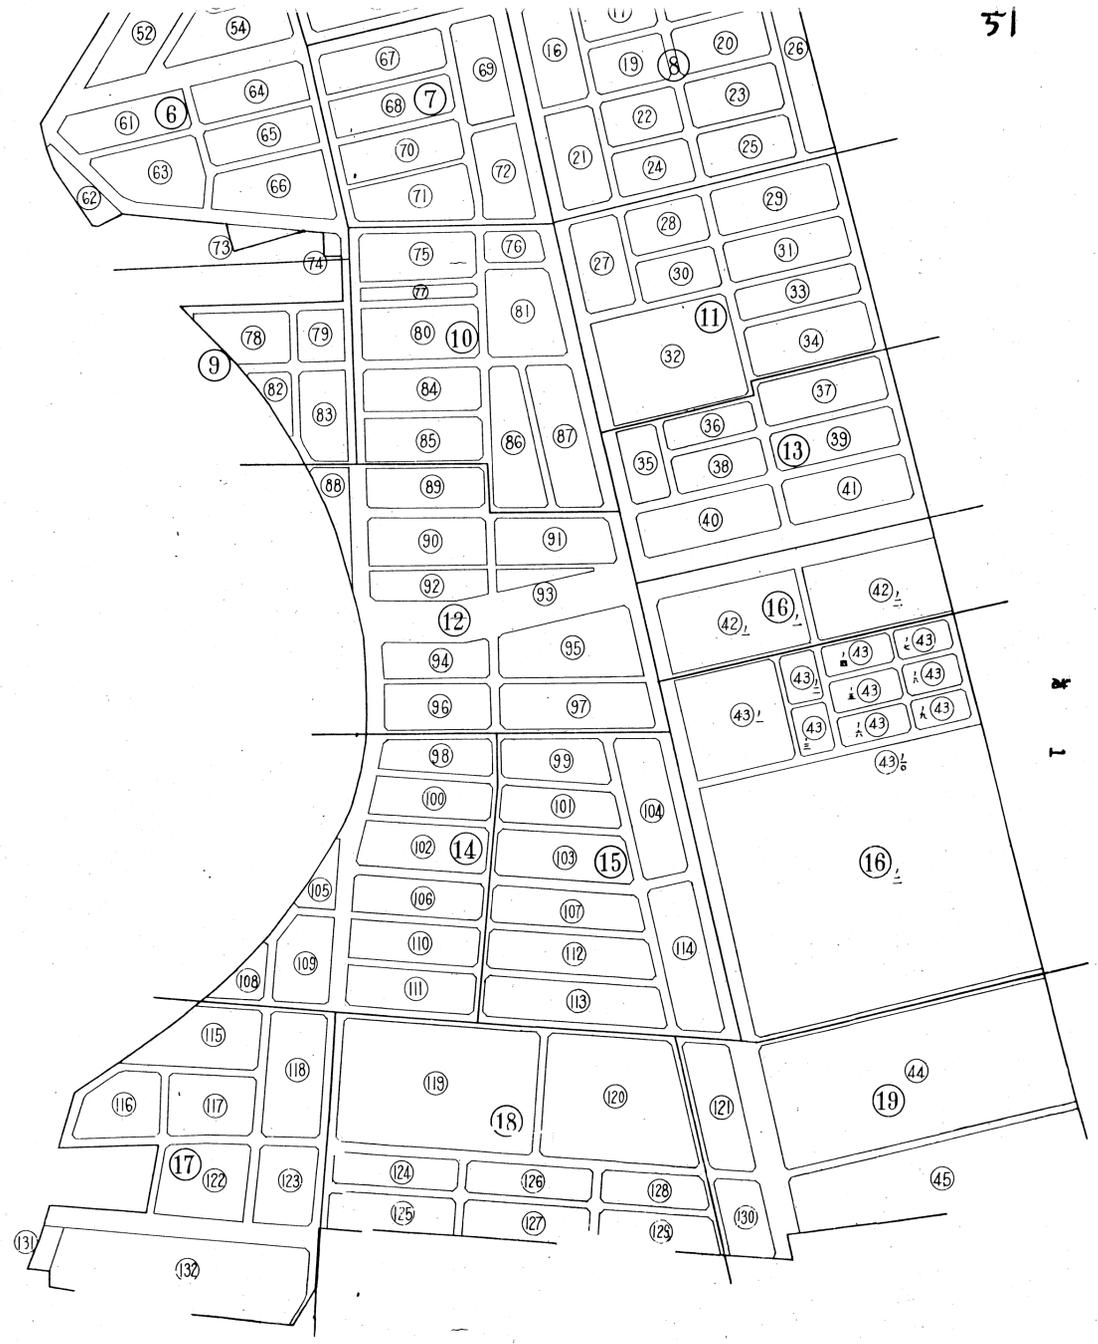

51


6-1

21-2

6-2


324190 +
5720 +

324370 +
35780

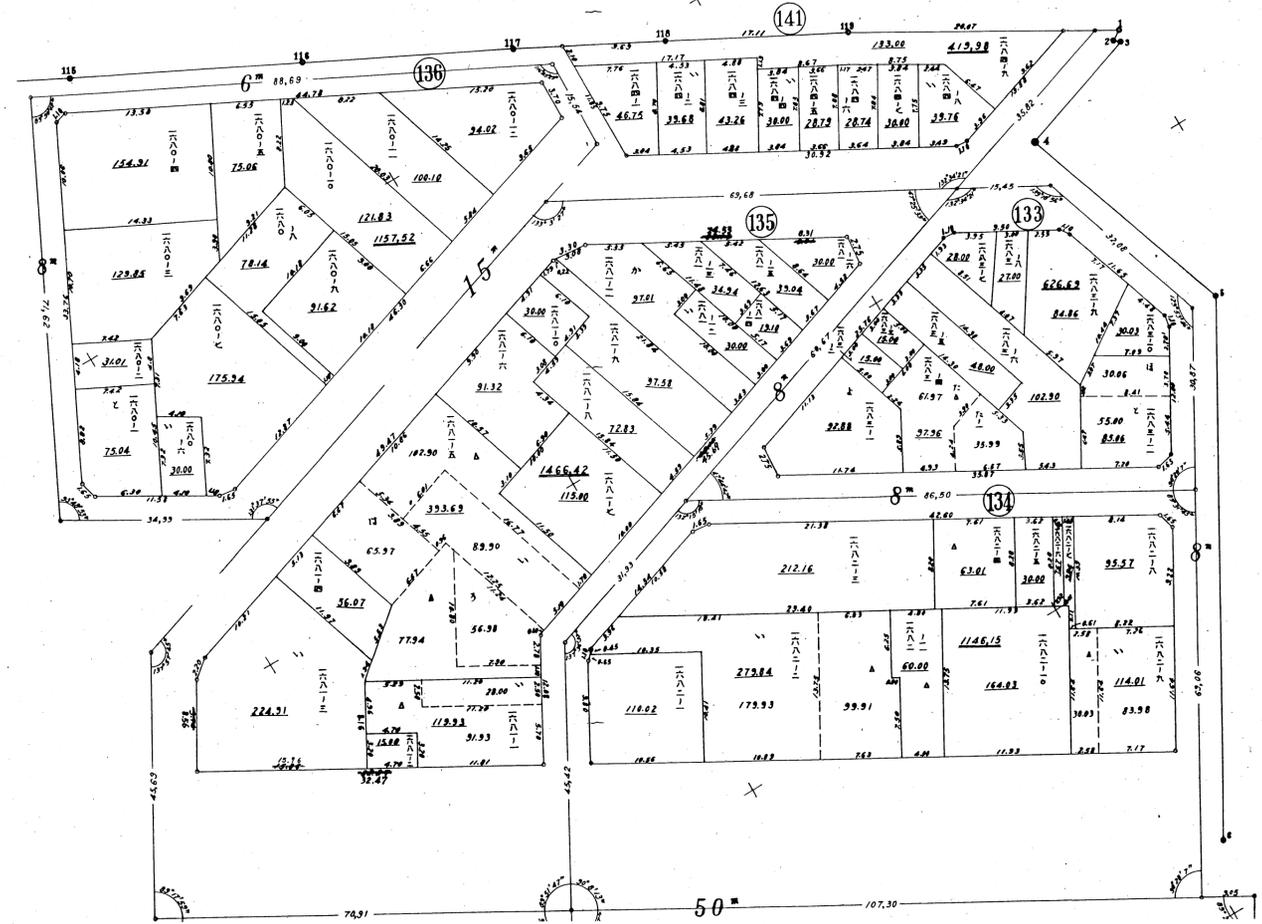

平安地区確定図第一号

135番地籍476訂正22.5.12

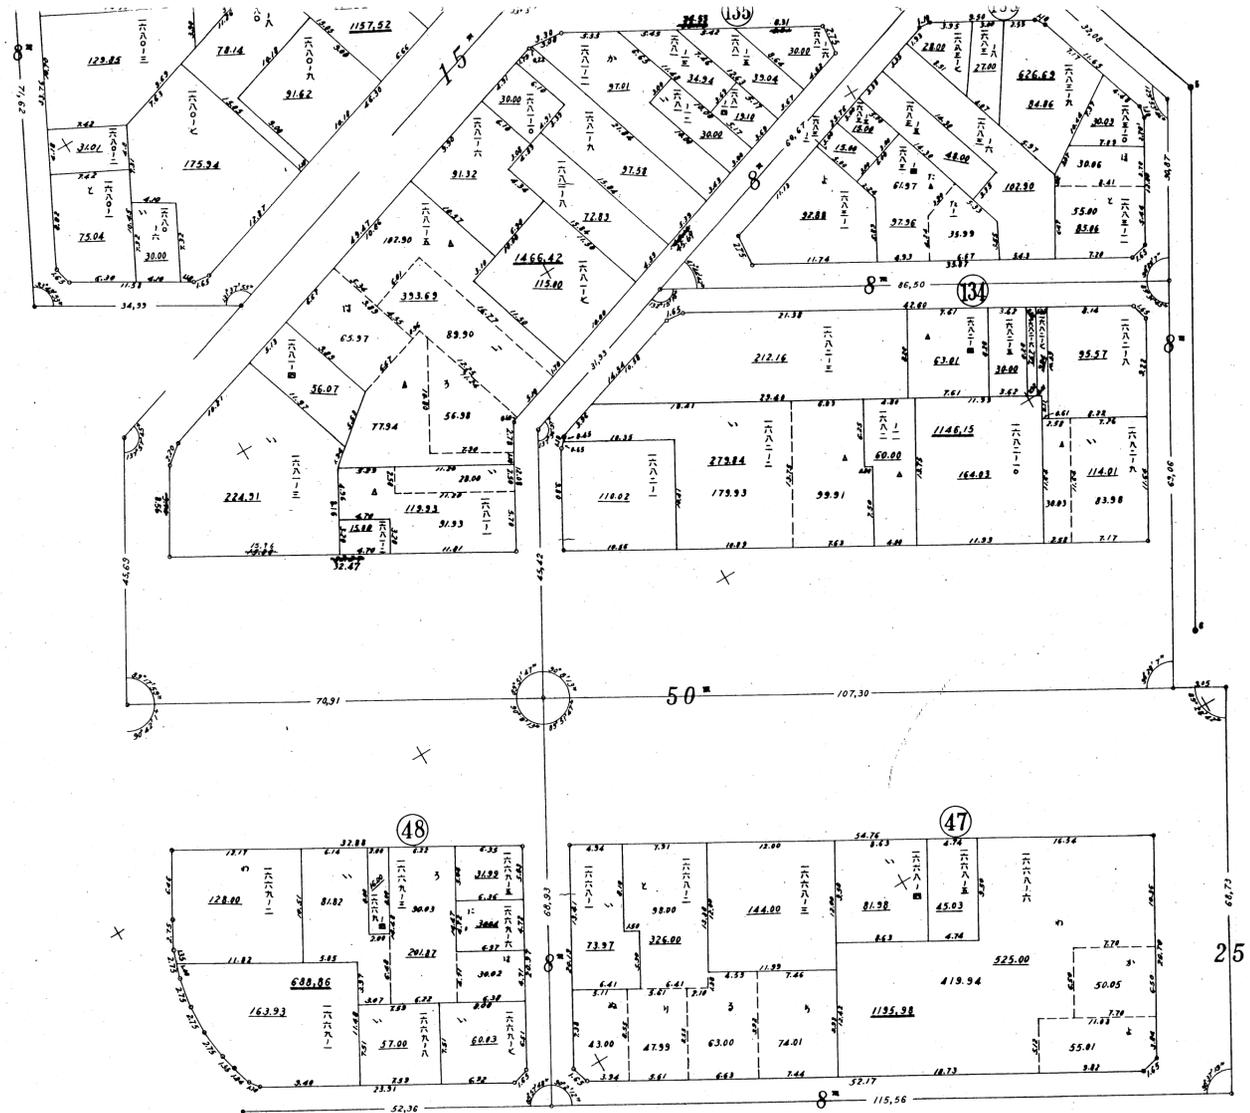


6-2

35960 + 24130

36020 + 35230

6-3

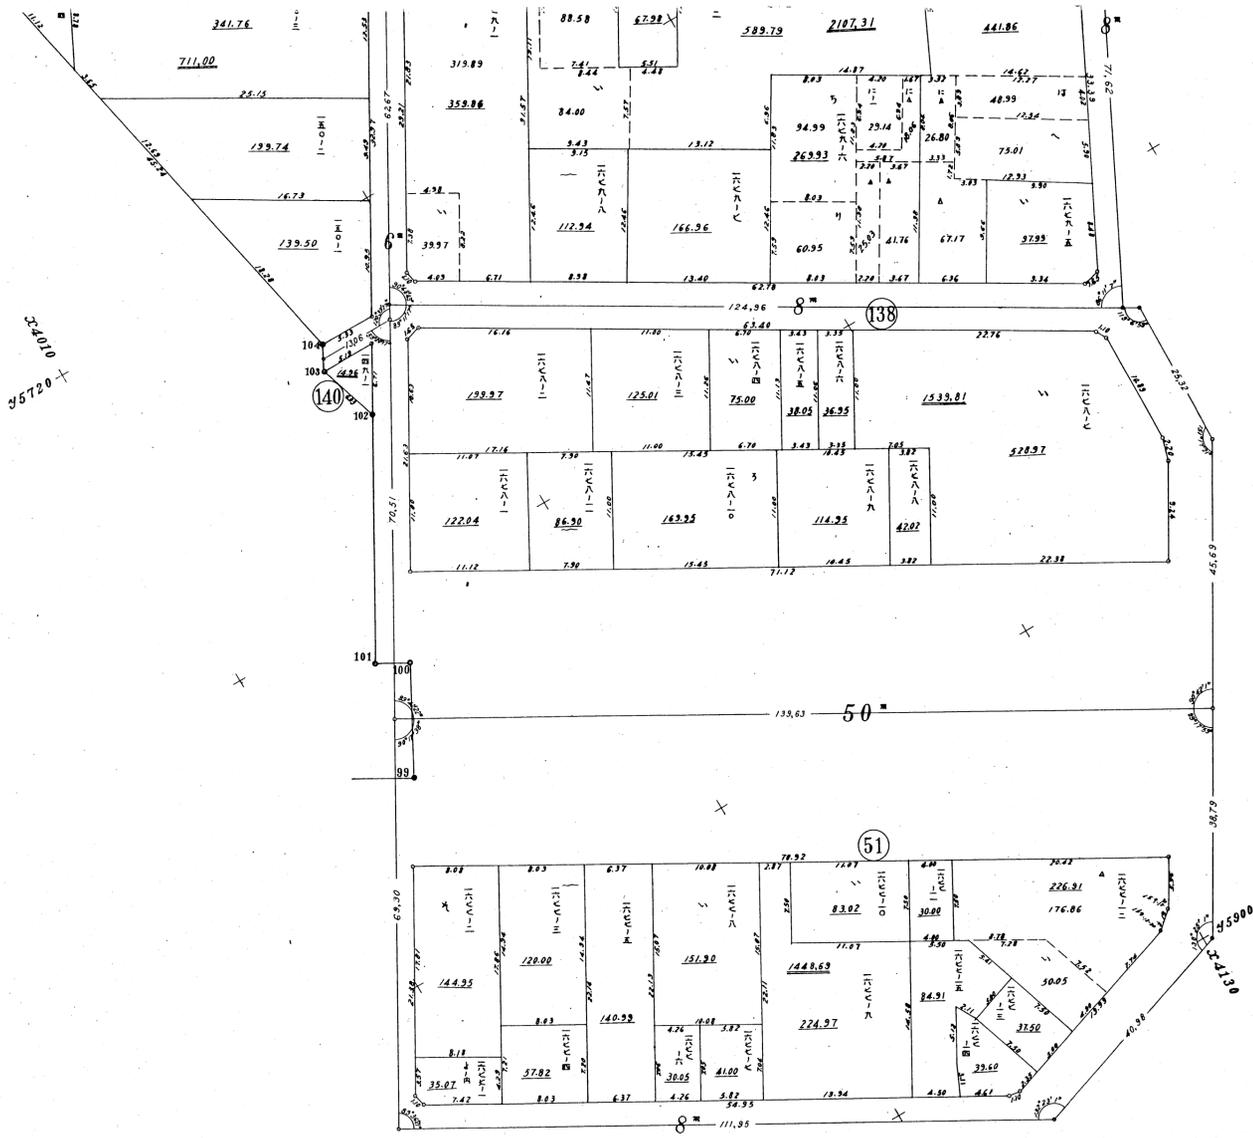


324010 + 02159

324010 + 00652

注 4

平安地区確定図第三号

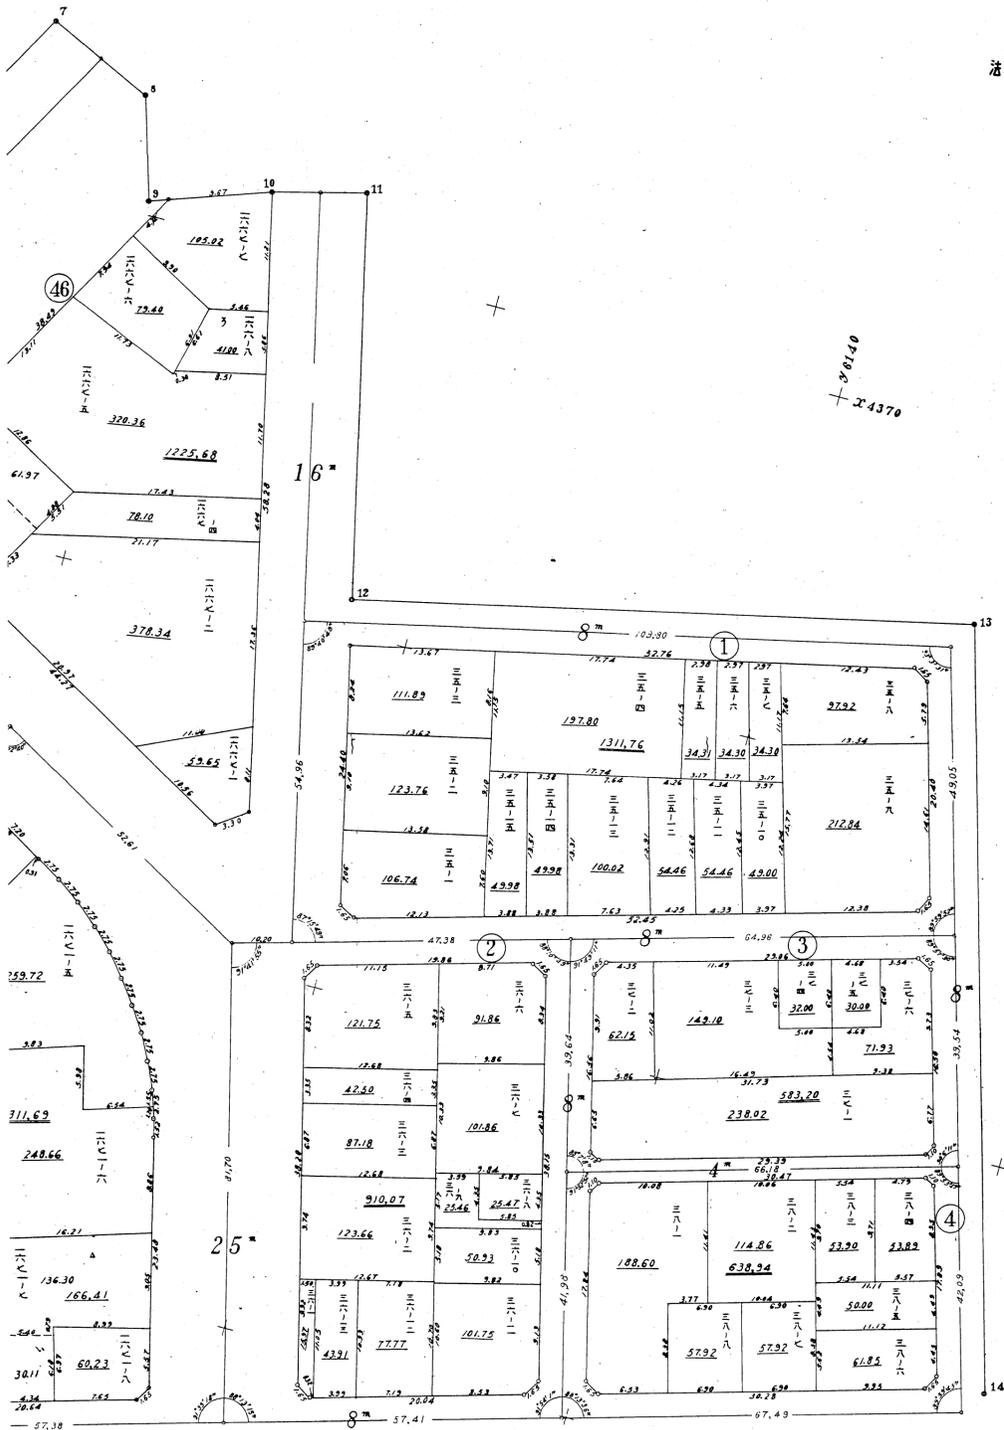


30140
+ 24370


30100
+ 24130

6-4

6-4

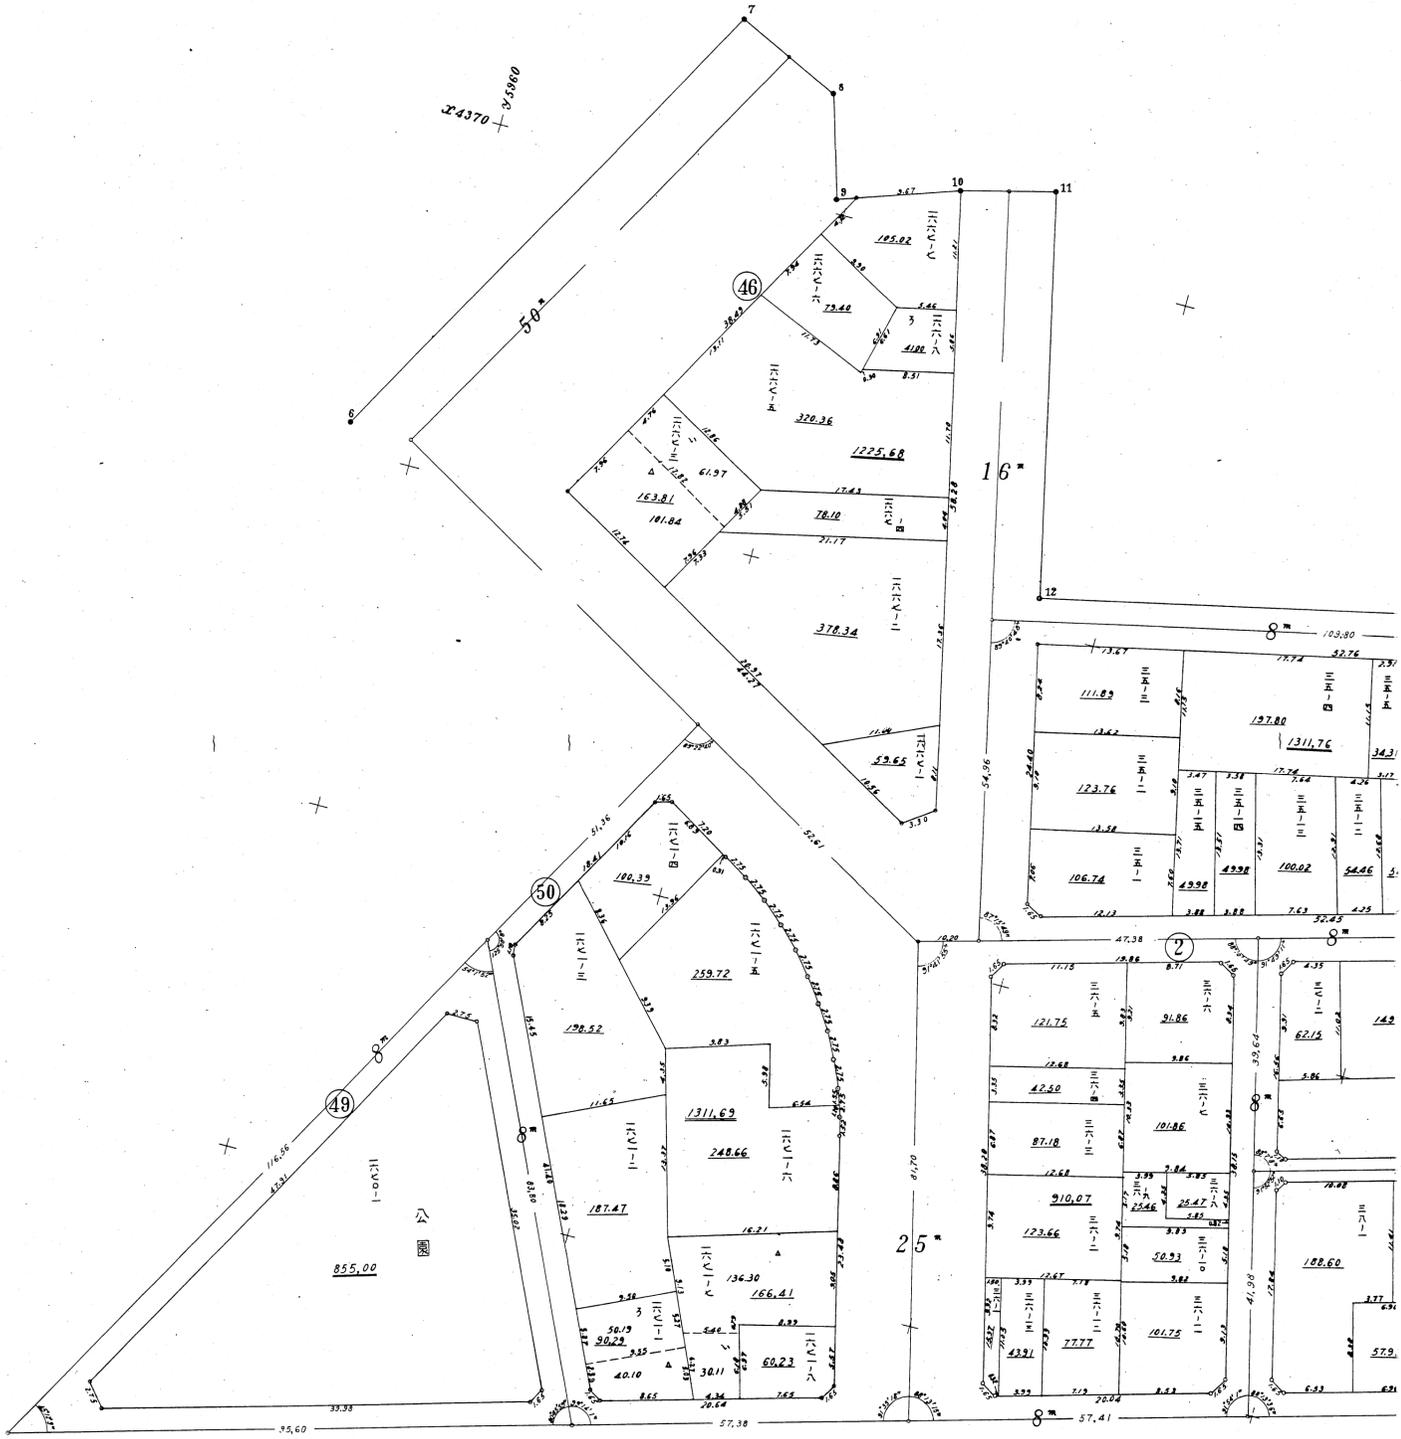

平安地区確定図第四号

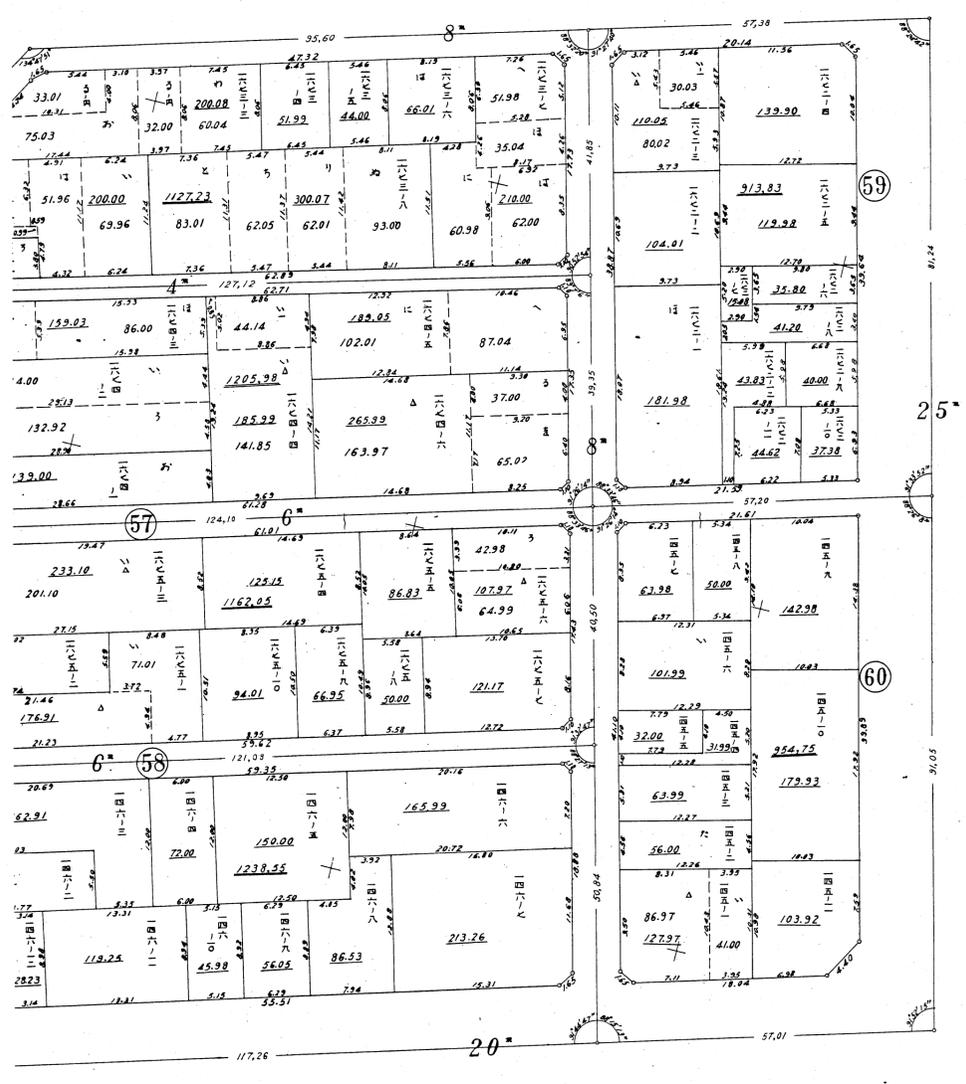


138140
24130

138140
24010

6-5


6-5

24130 +
35800

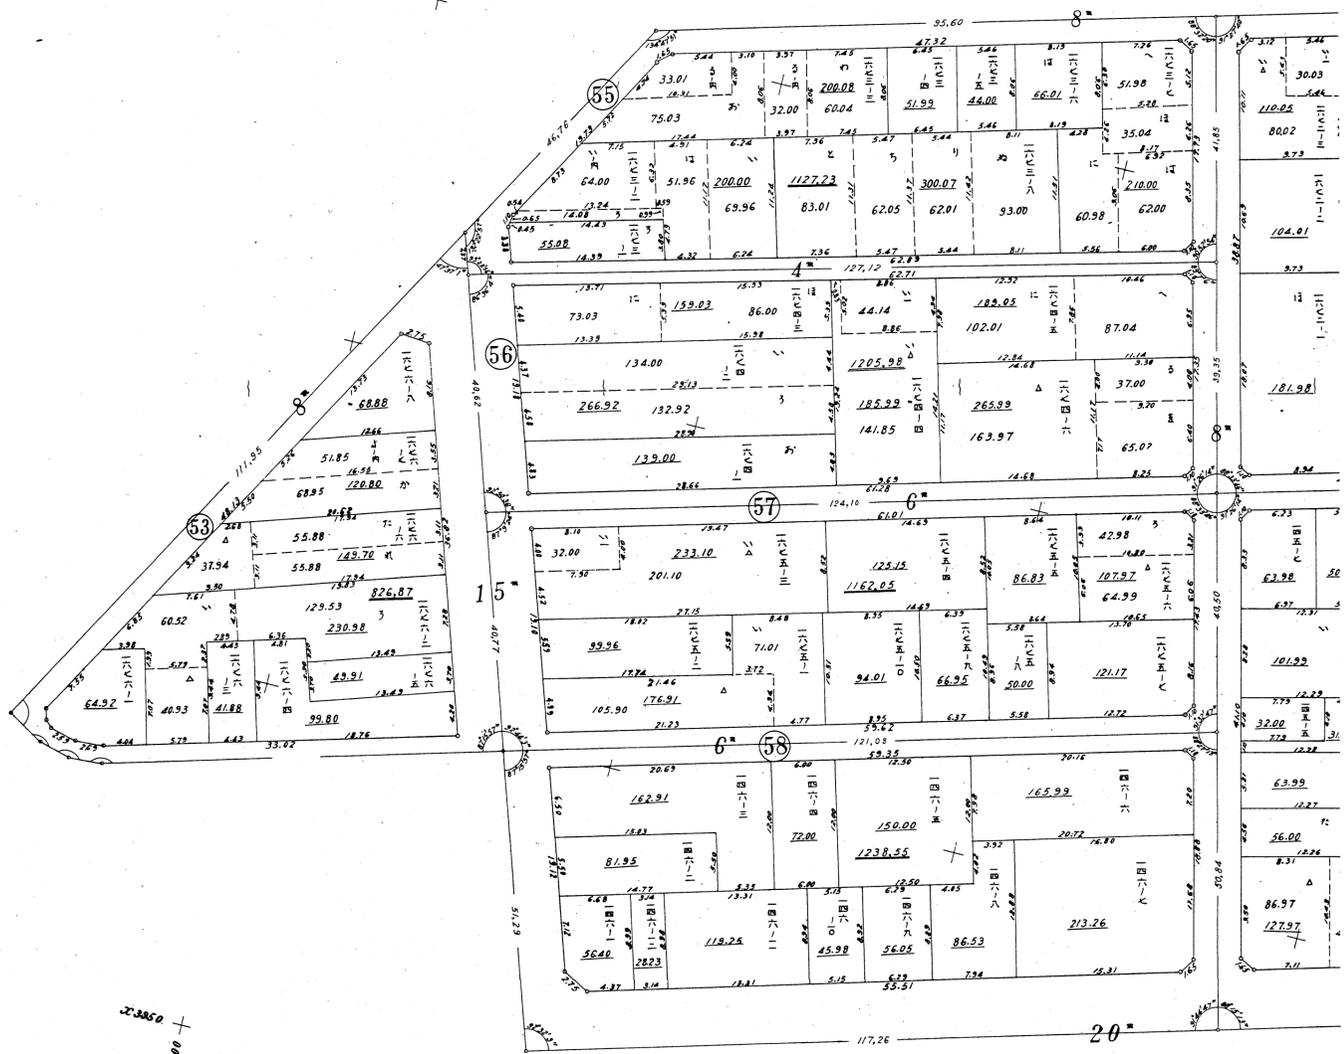

23850 +
00850

平安地区確定図第五号

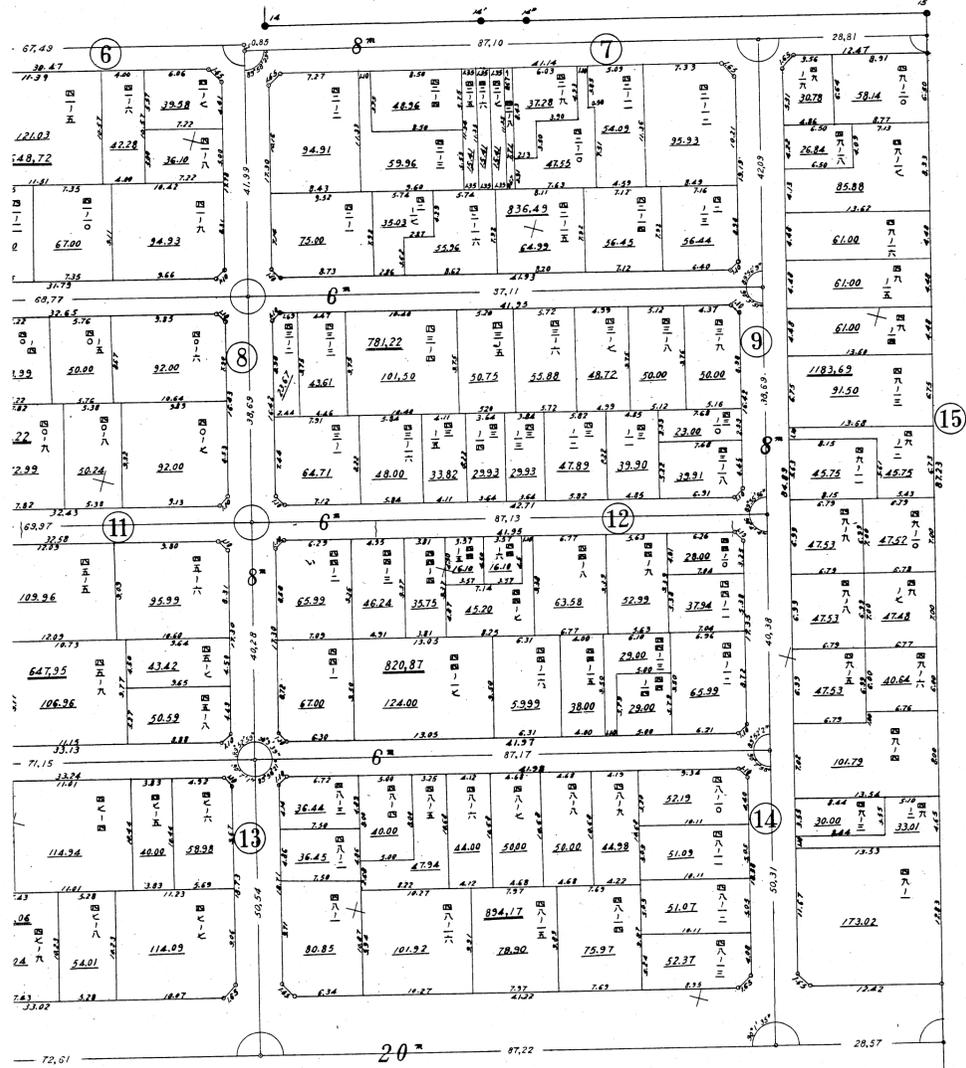

9-9

24190 + 36080




010P.2

36140

9-9


港 7

35380
+ X4010

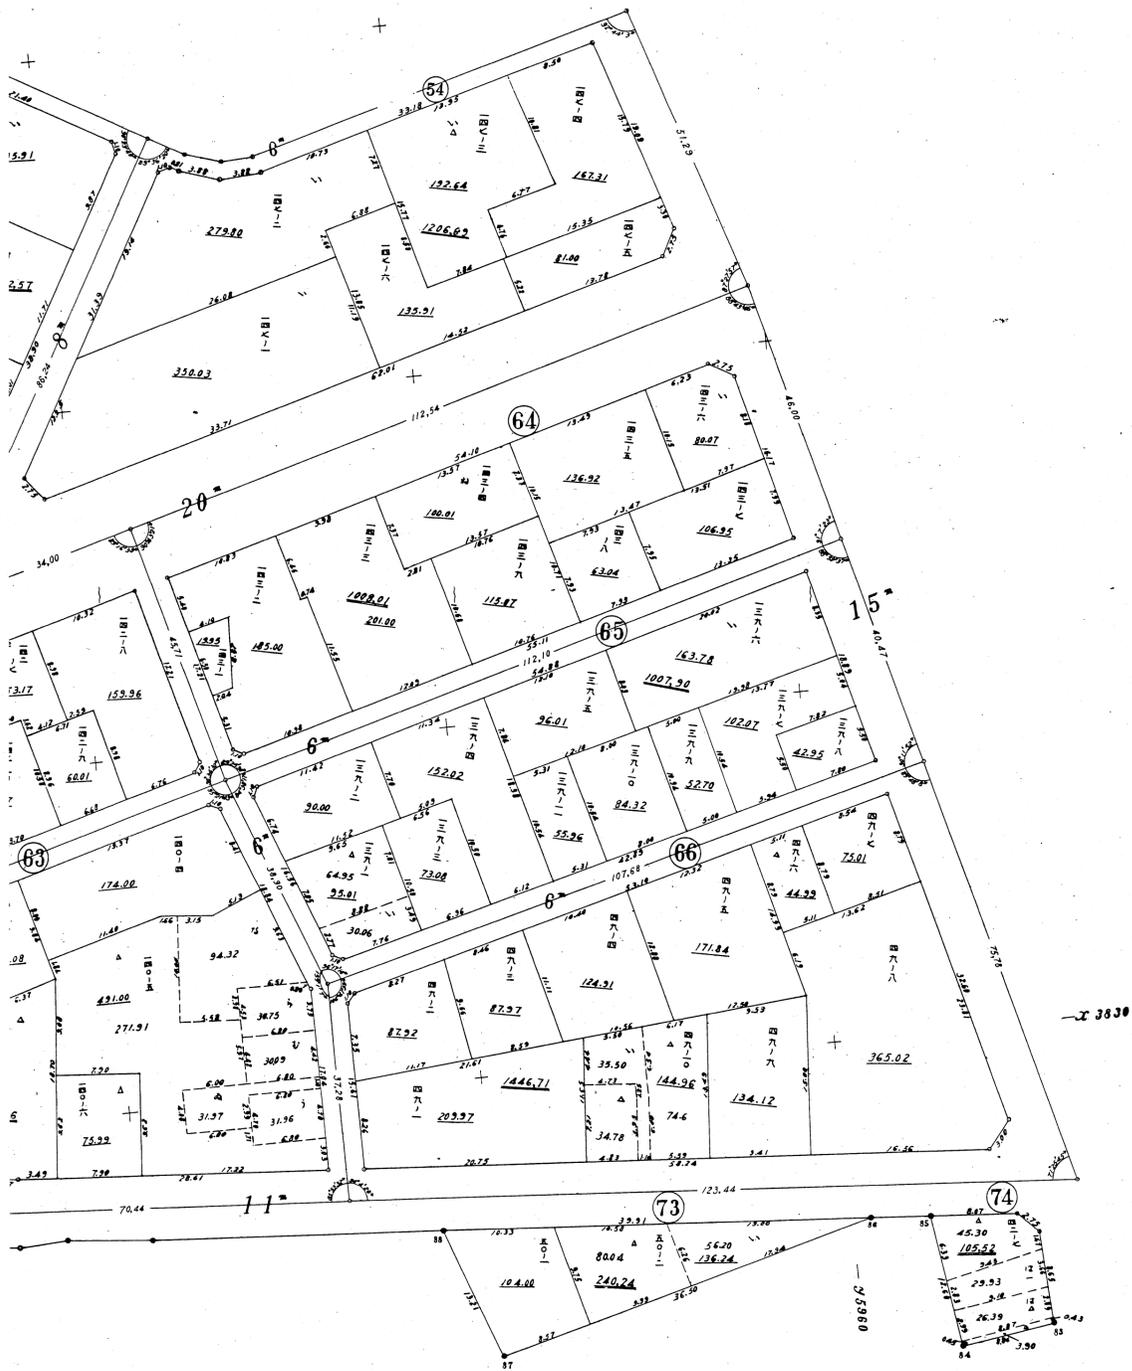


平安地区確定図第六号


6-7

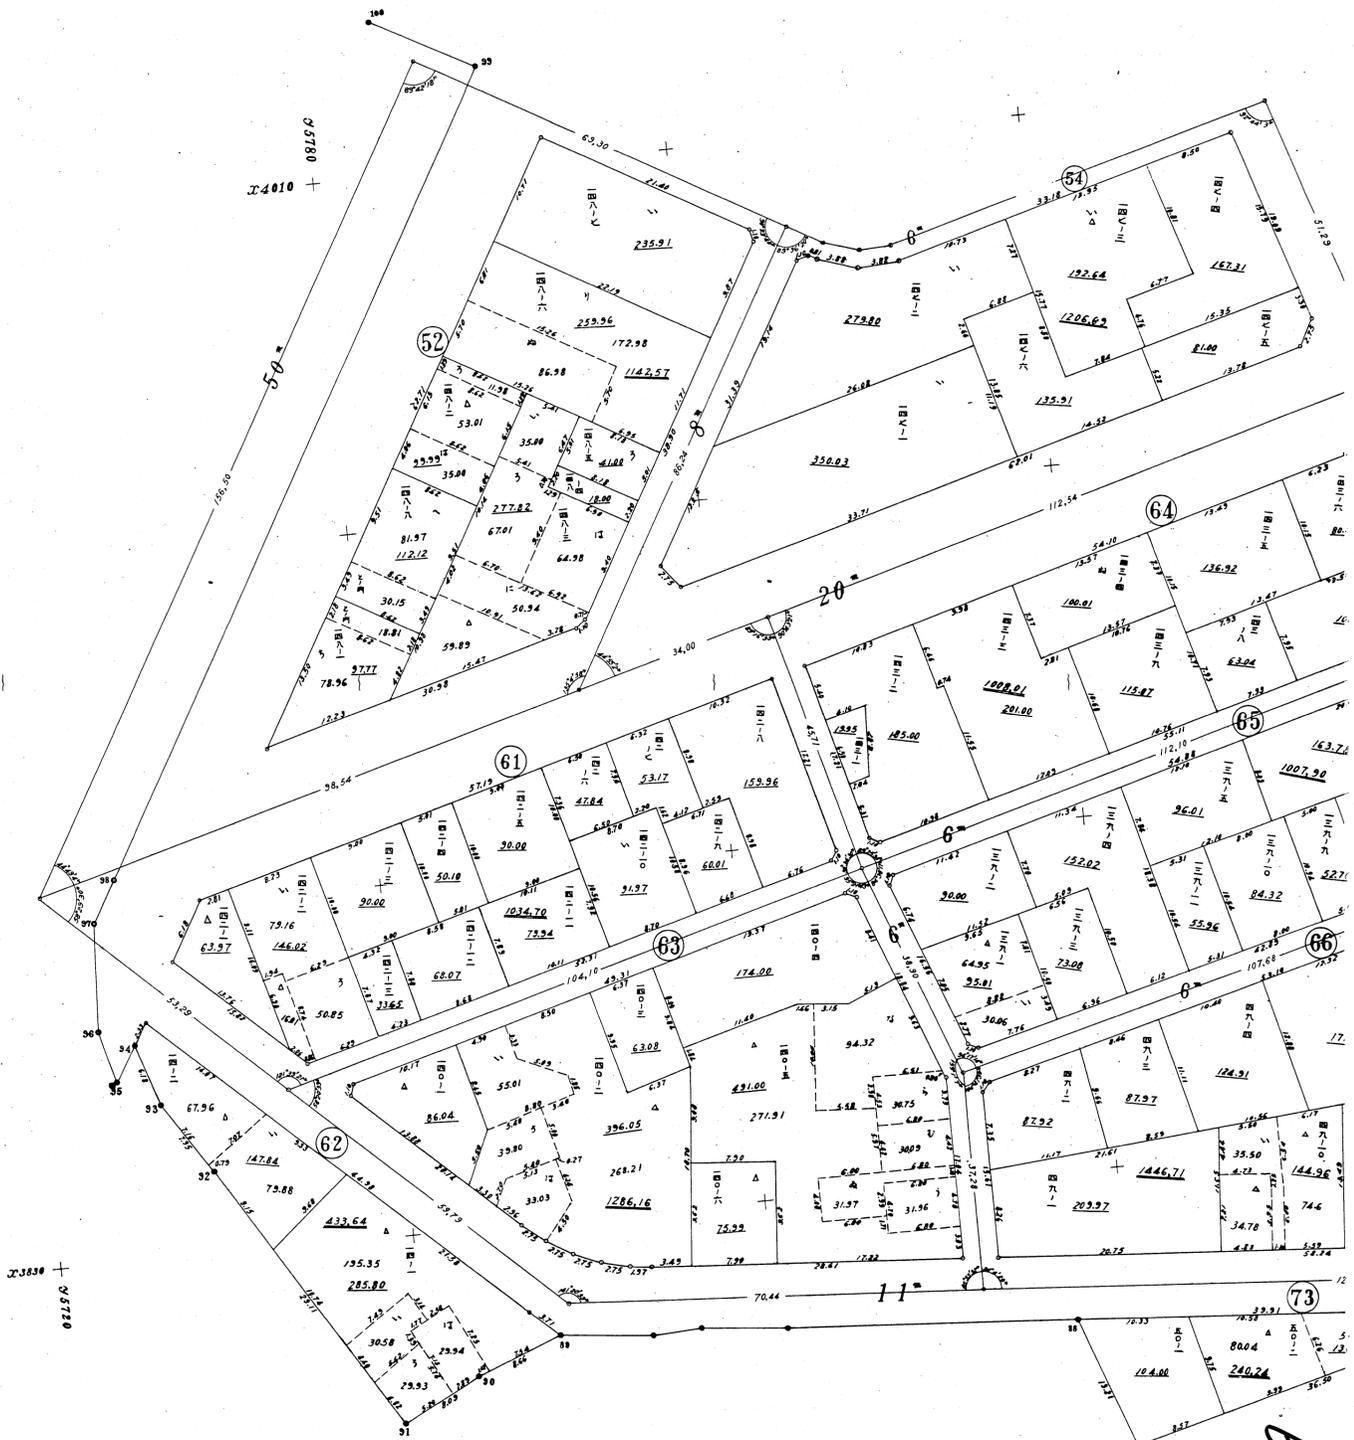

B-7

平安地区確定図第七号

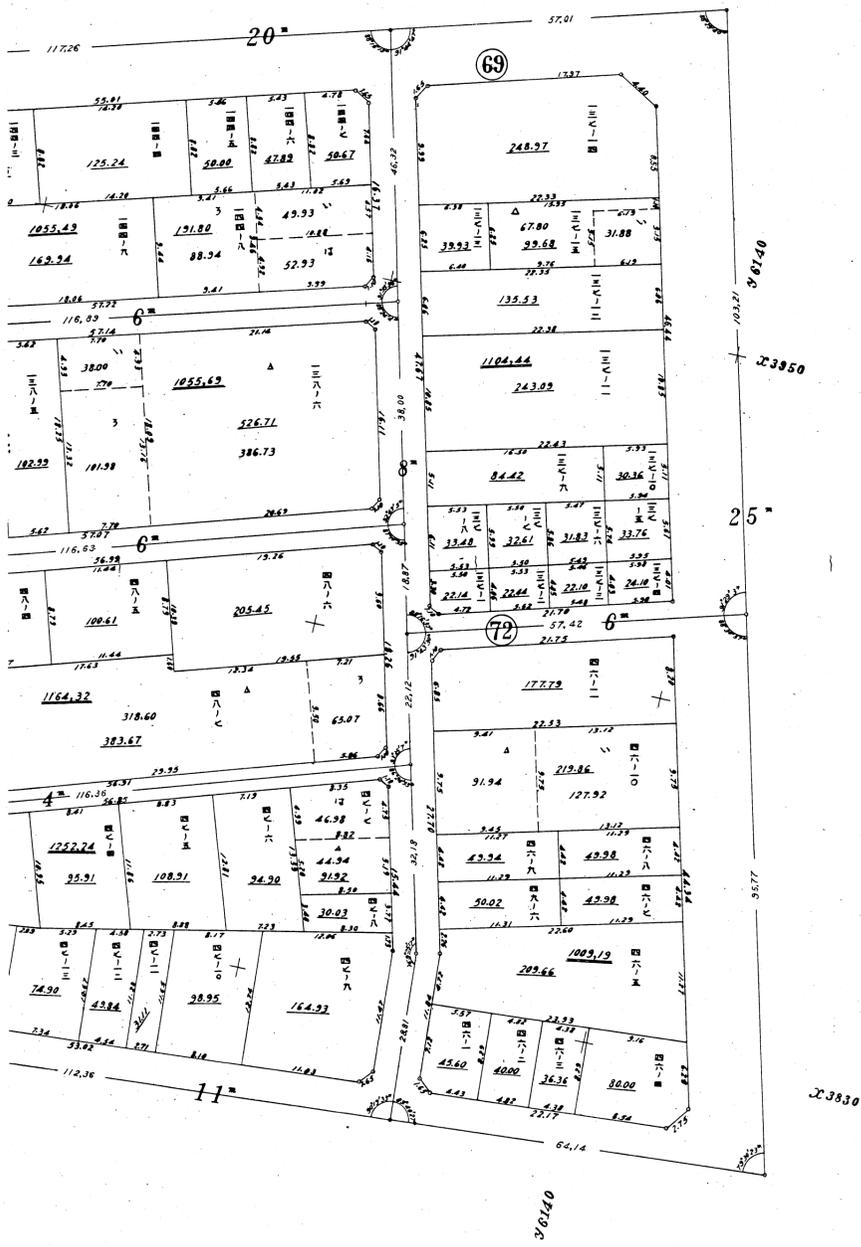


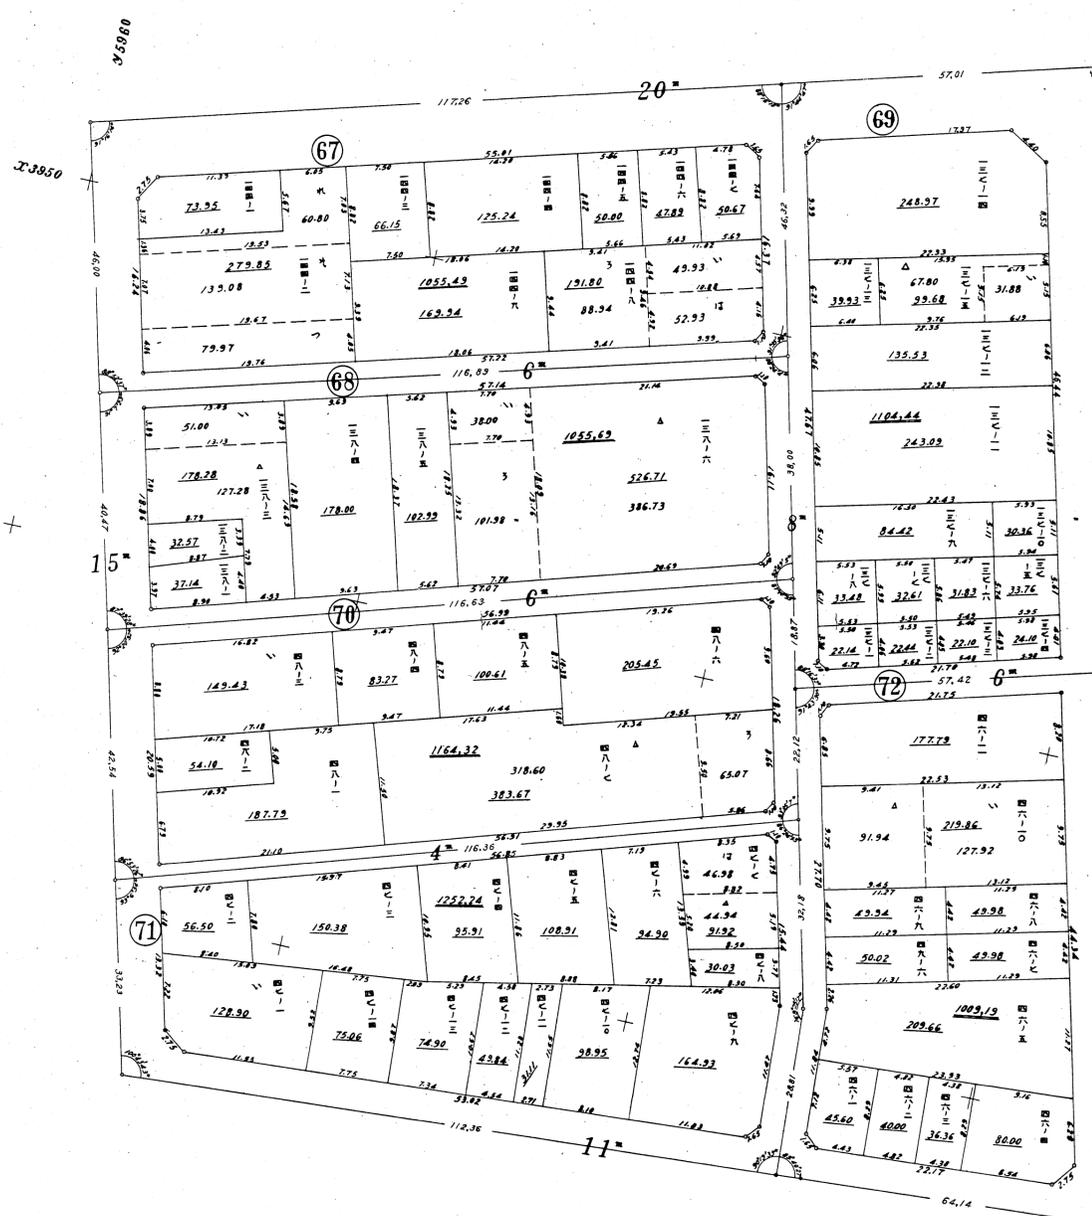

X 3850 +
35800

30140

8-9

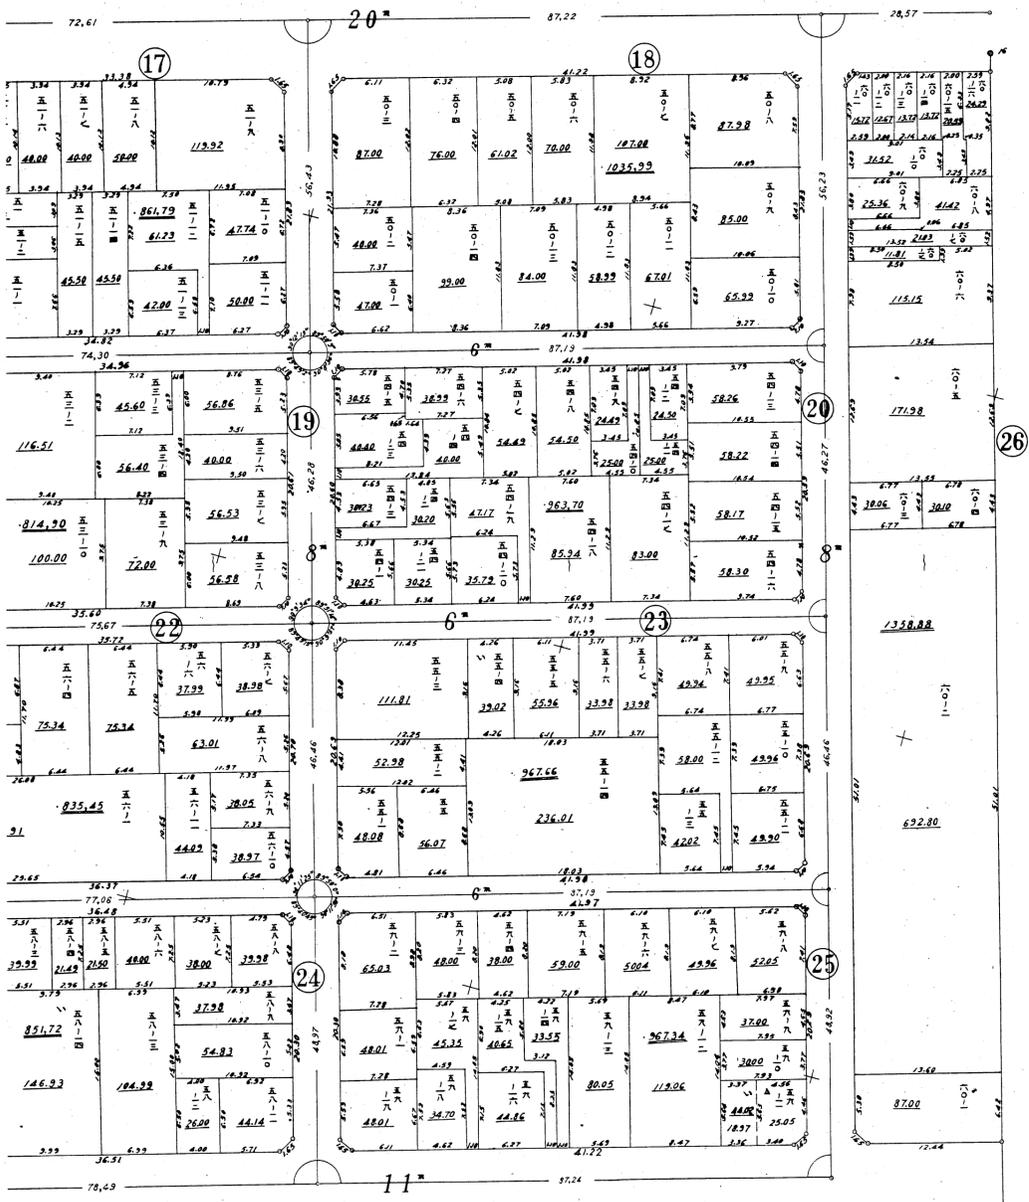

平安地区確定図第八号

6-9



6-9

21-10


6-10

港 10

平安地区確定図第九号

33770 + 05540


33770 + 05500

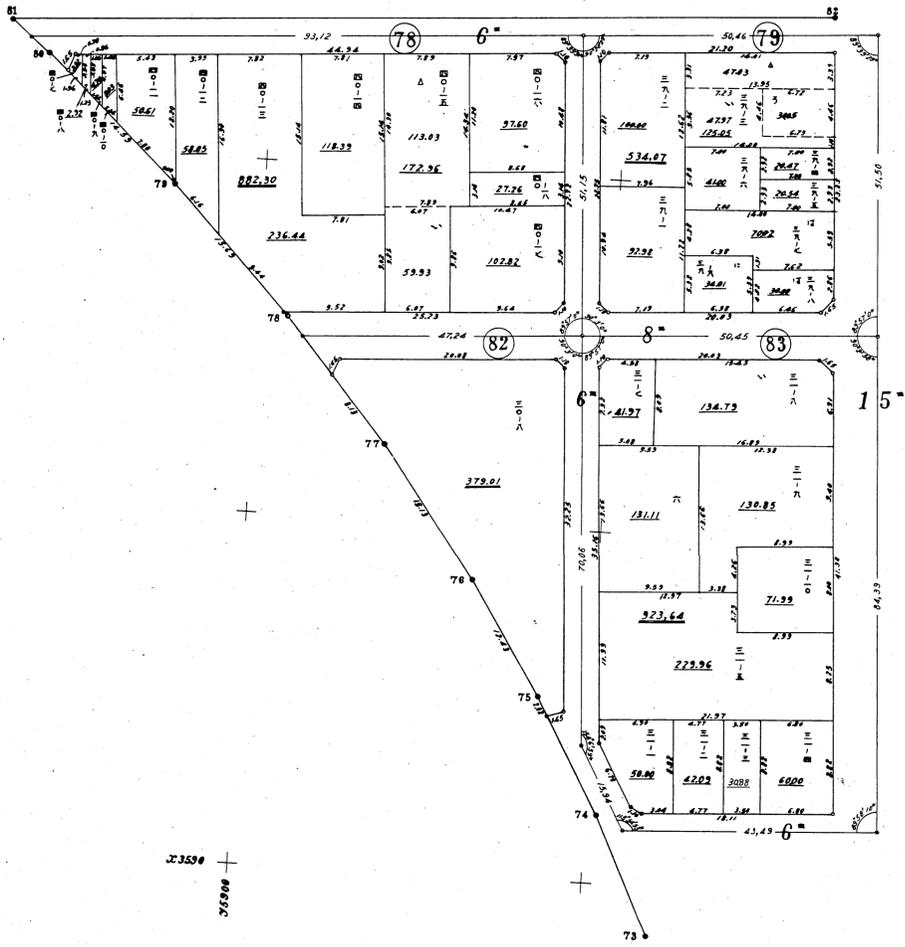

33590 + 06290

33590 + 06020

平安地区確定図第十号

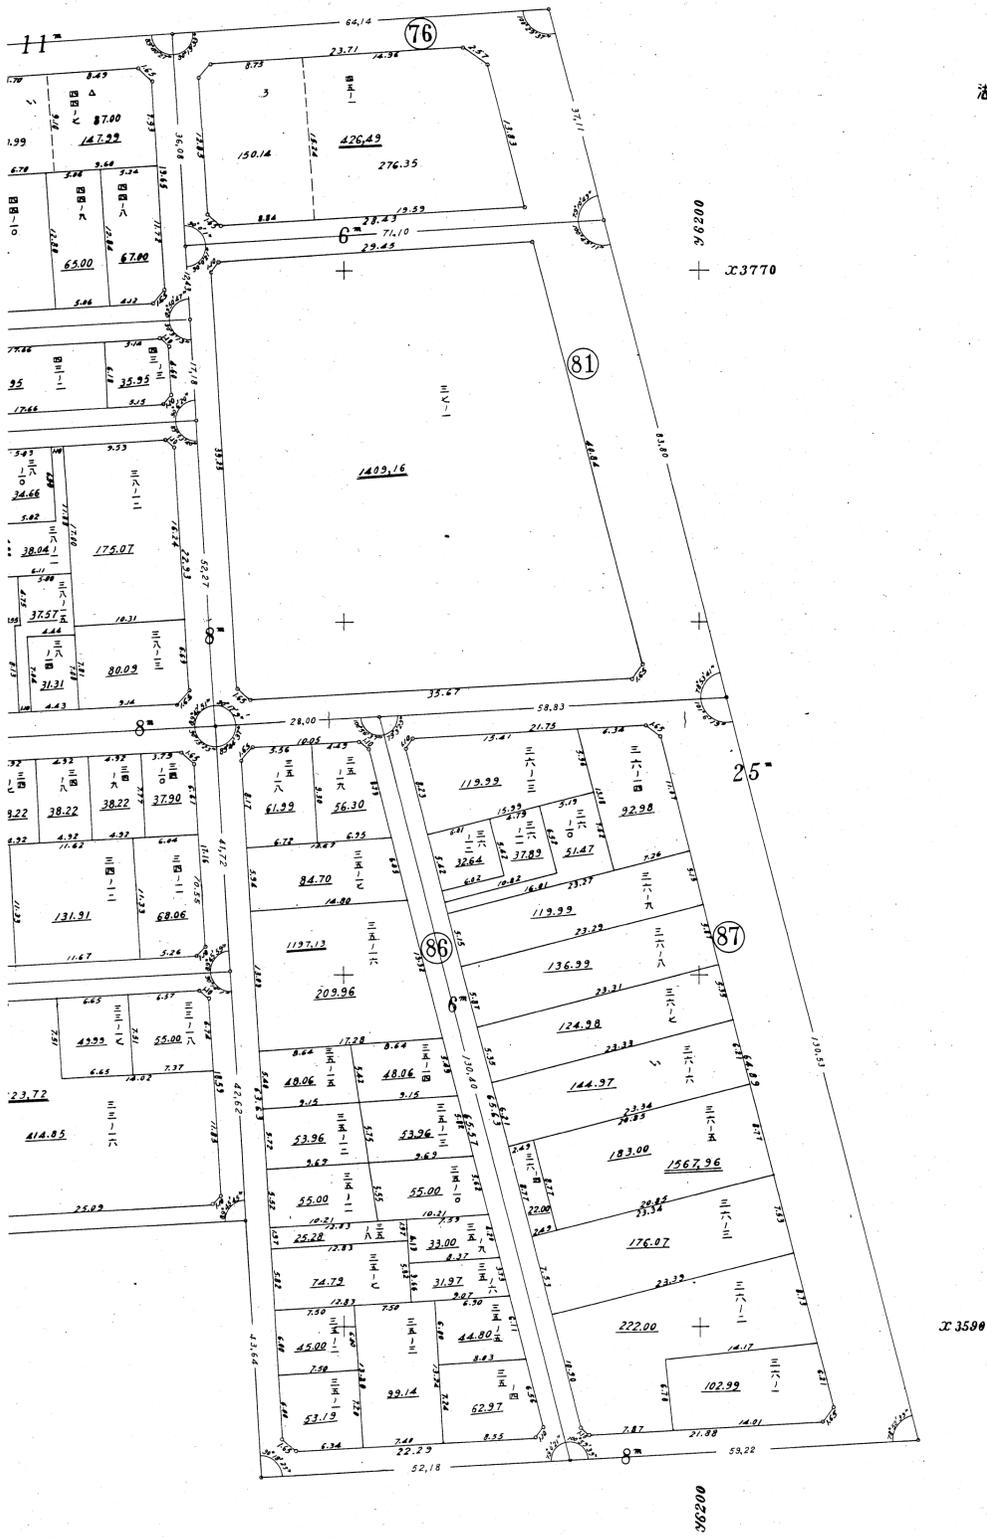


11-9



11-9

36020

平安地区確定図第十一号

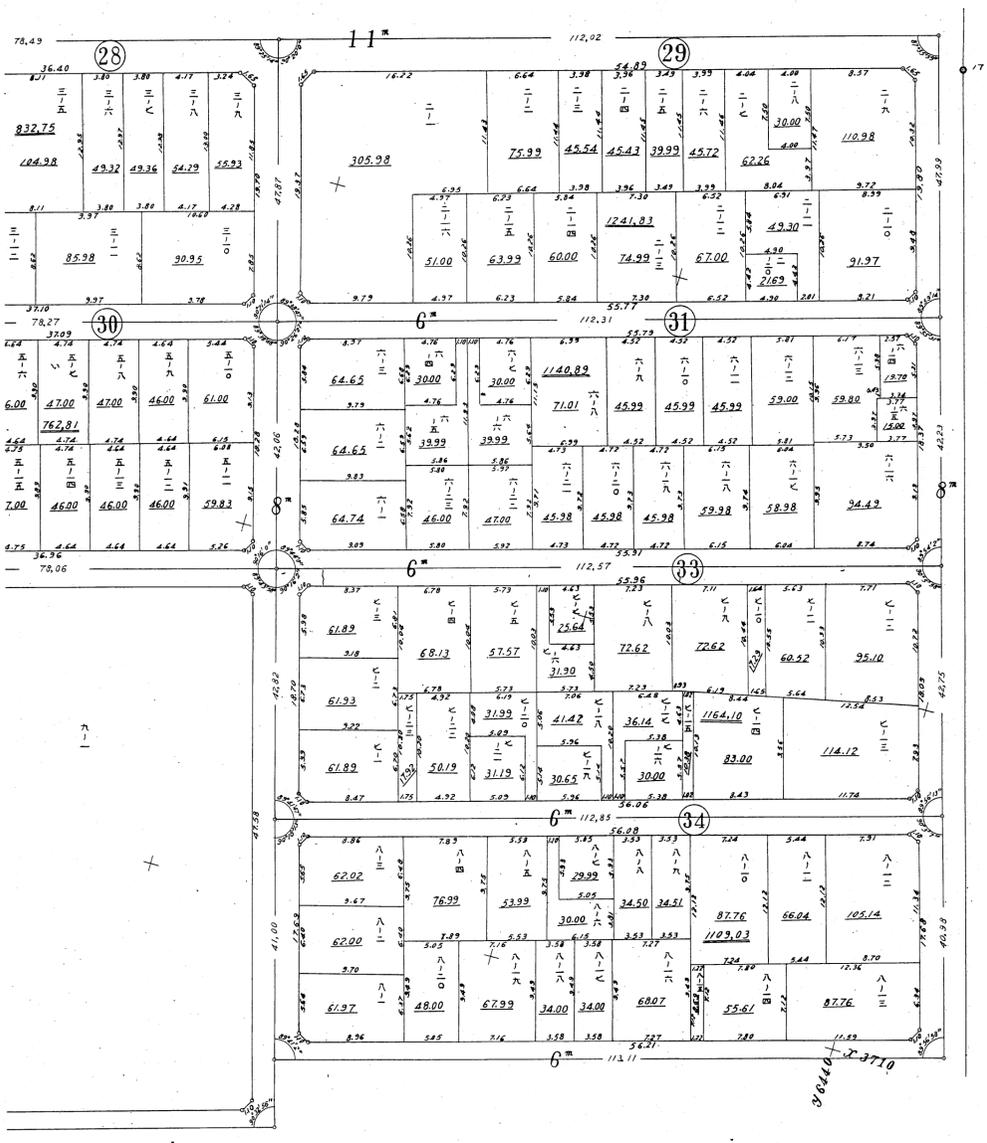

6-12



00200 +
03830 +

00200 +
03850 +

6-12

6-13

21-13

法 13

平安地区確定図第十二号






6-13

6-14

21-14

法 14


平安地区確定図第十三号

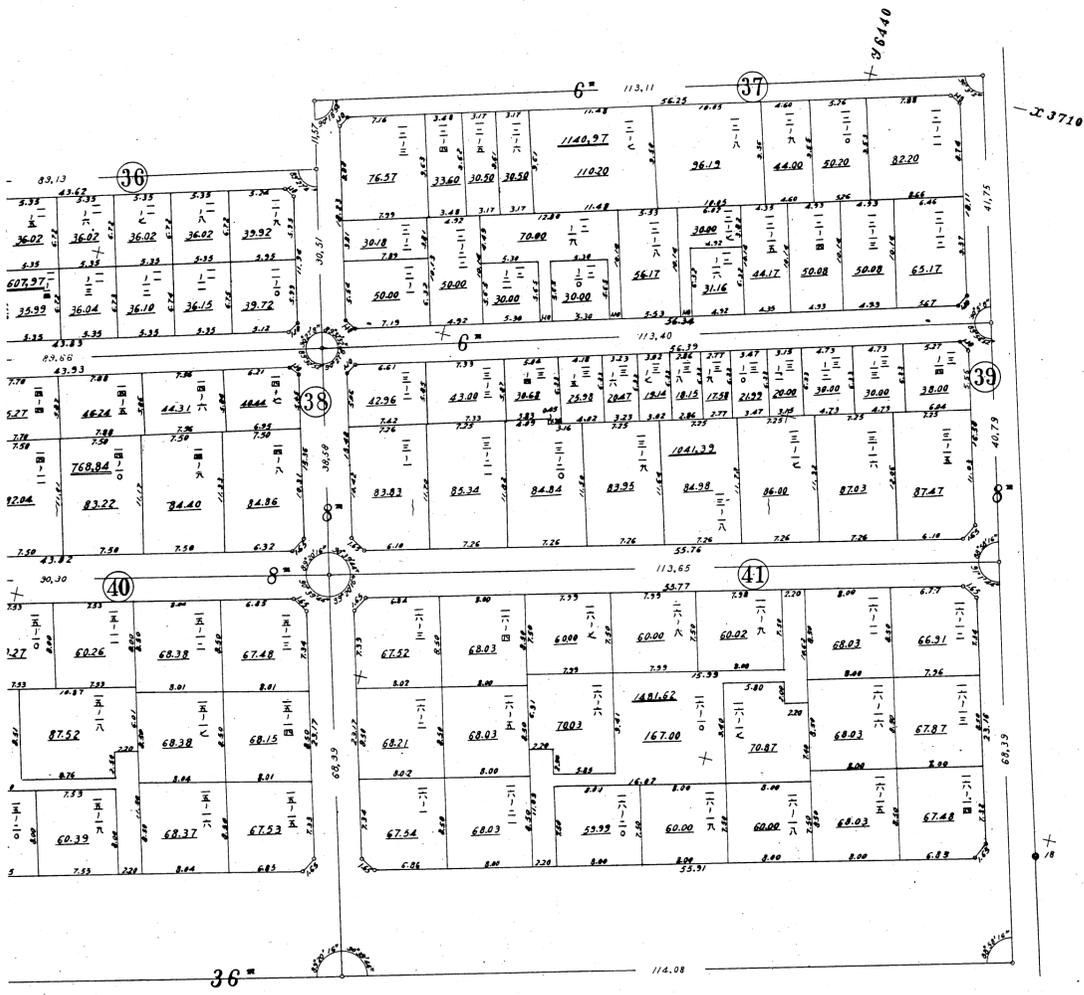

30500
+ 3530


6-14

X-3710 + 06280

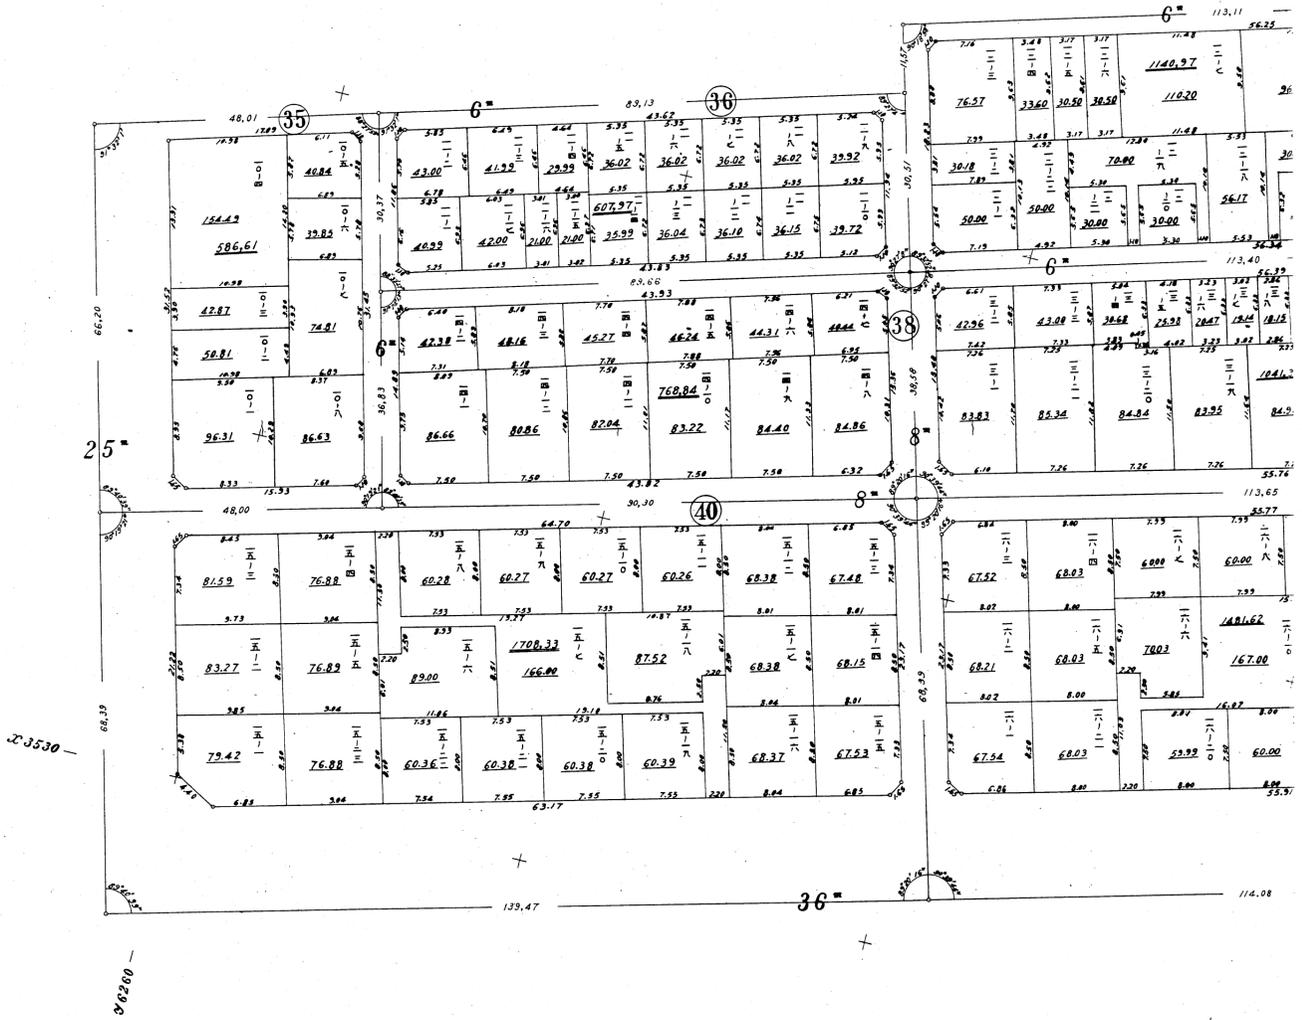


注 15

平安地区確定図第十四号

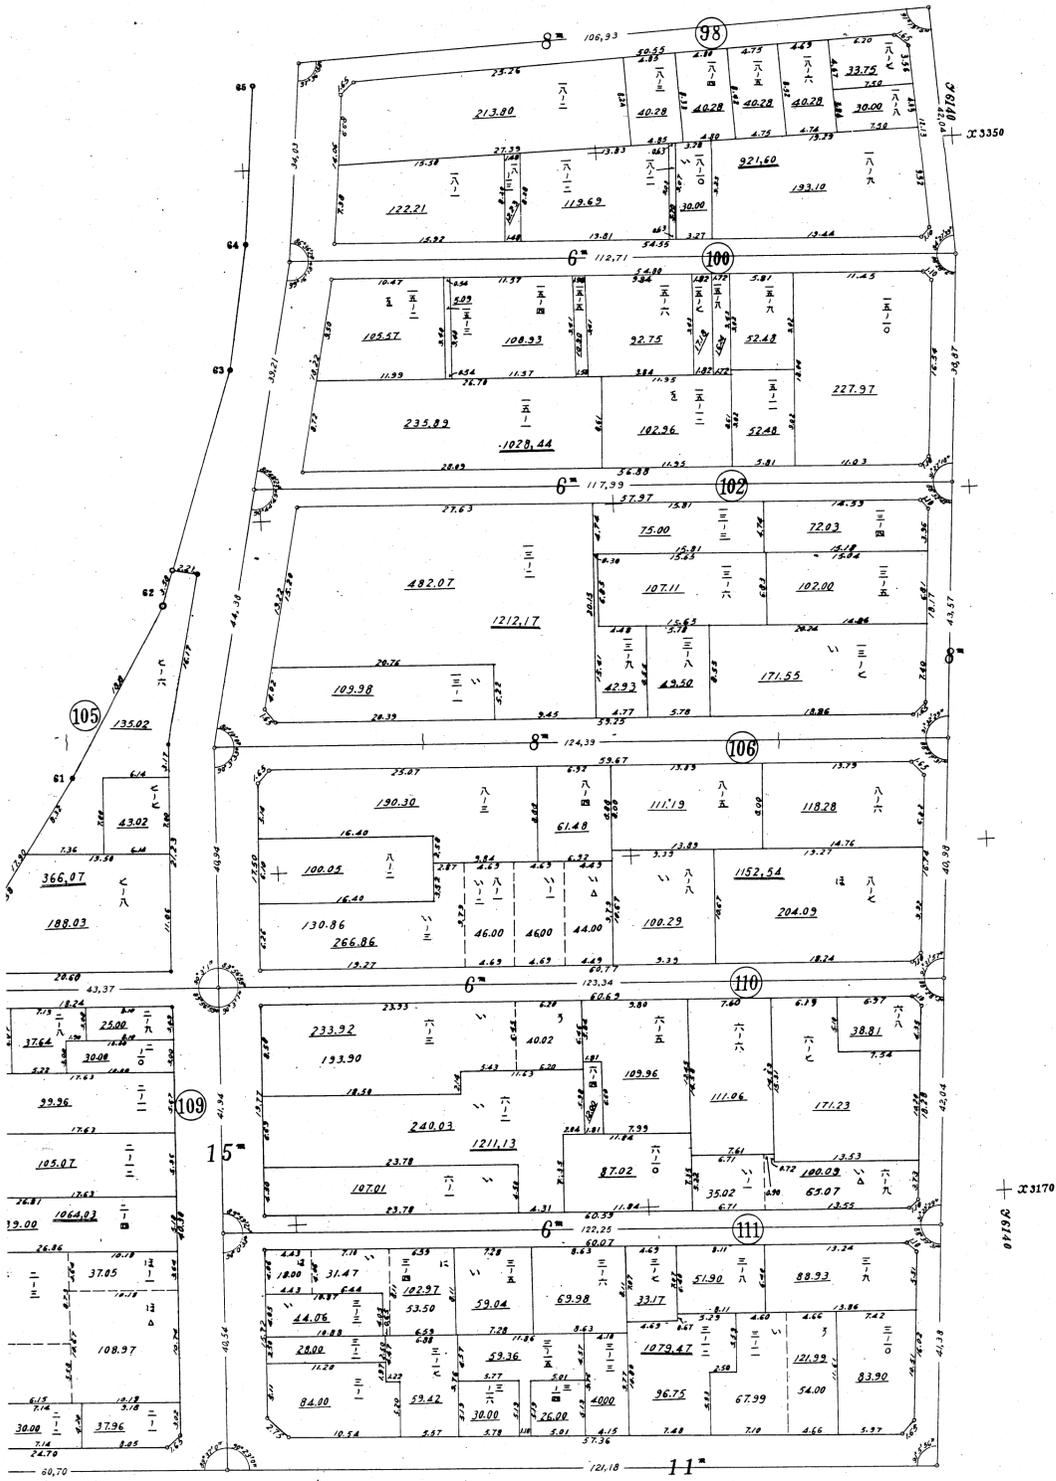

6-15

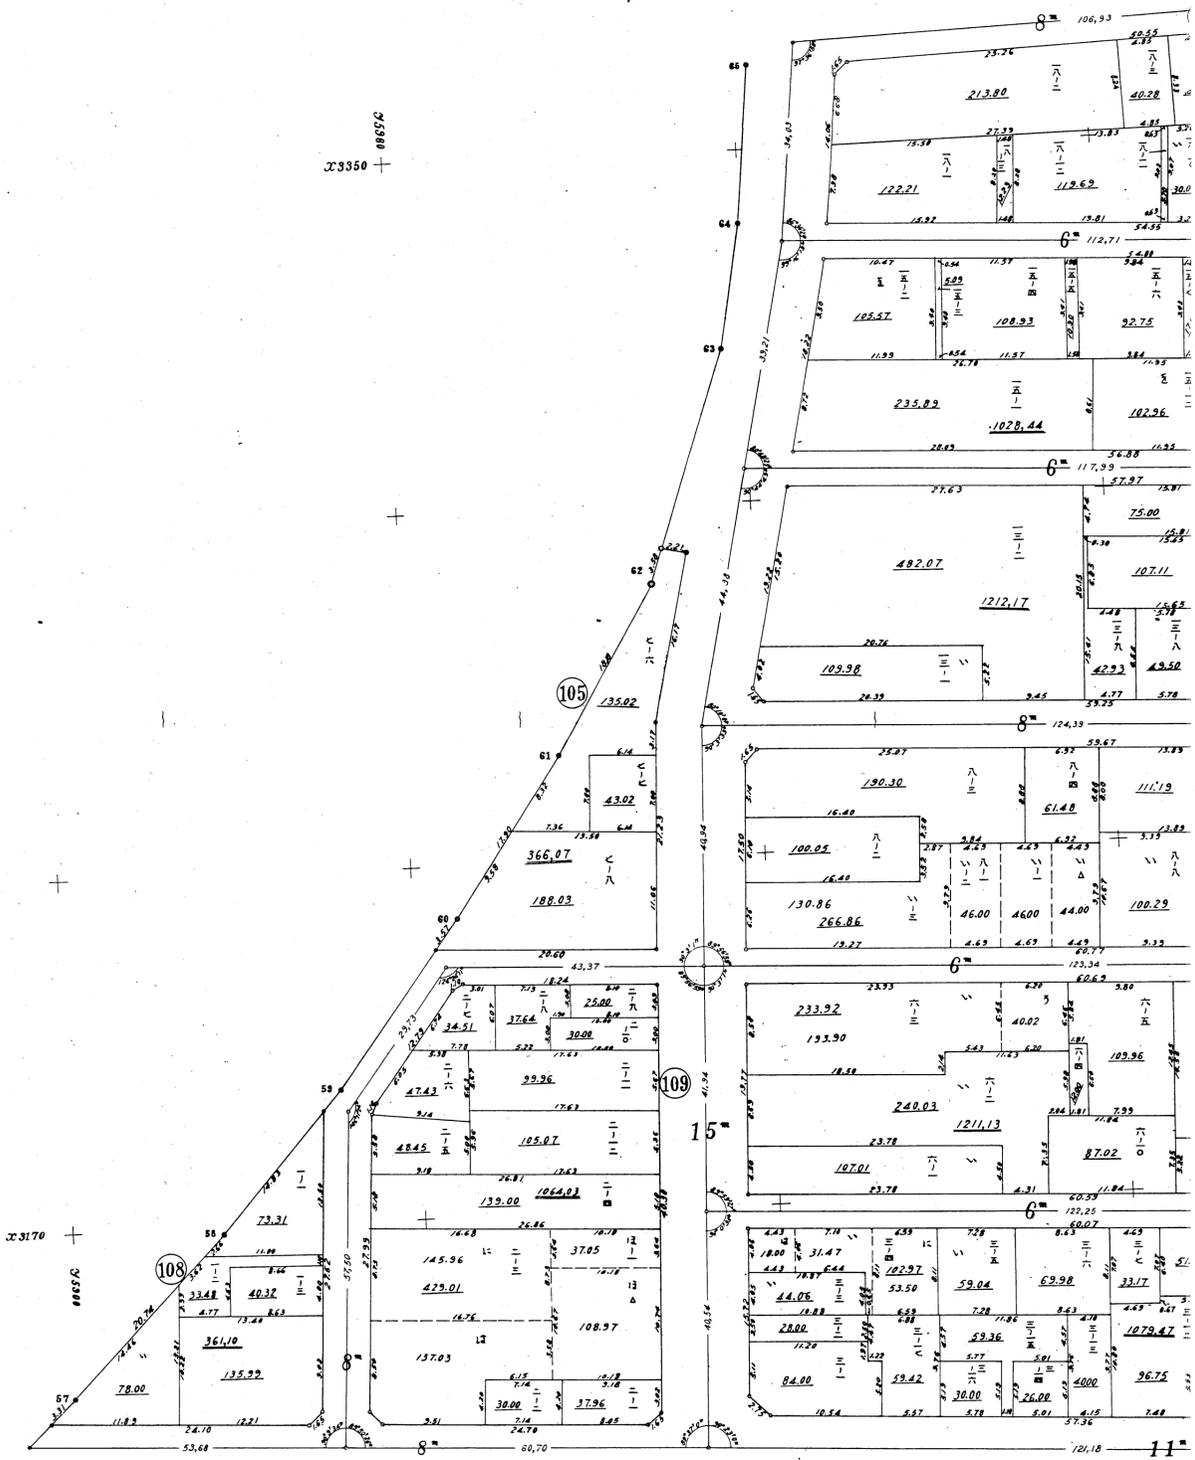


X.3350 +

X.3170 +


6-15

11

平安地区確定図第十五号

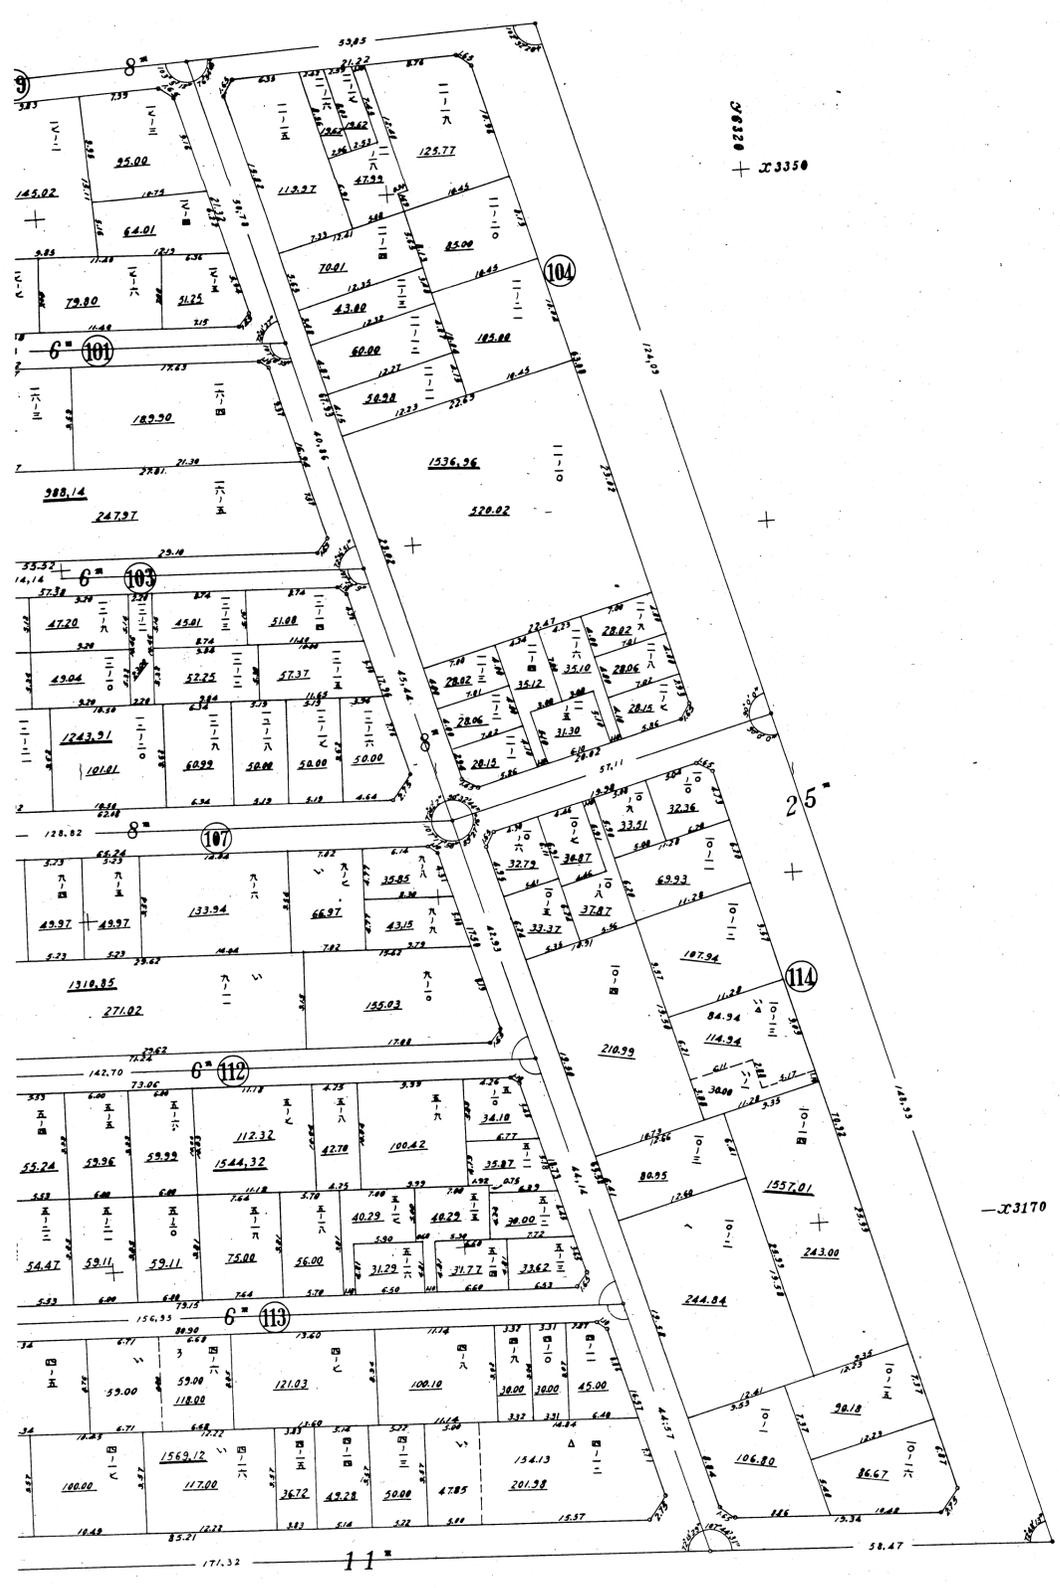


6-16

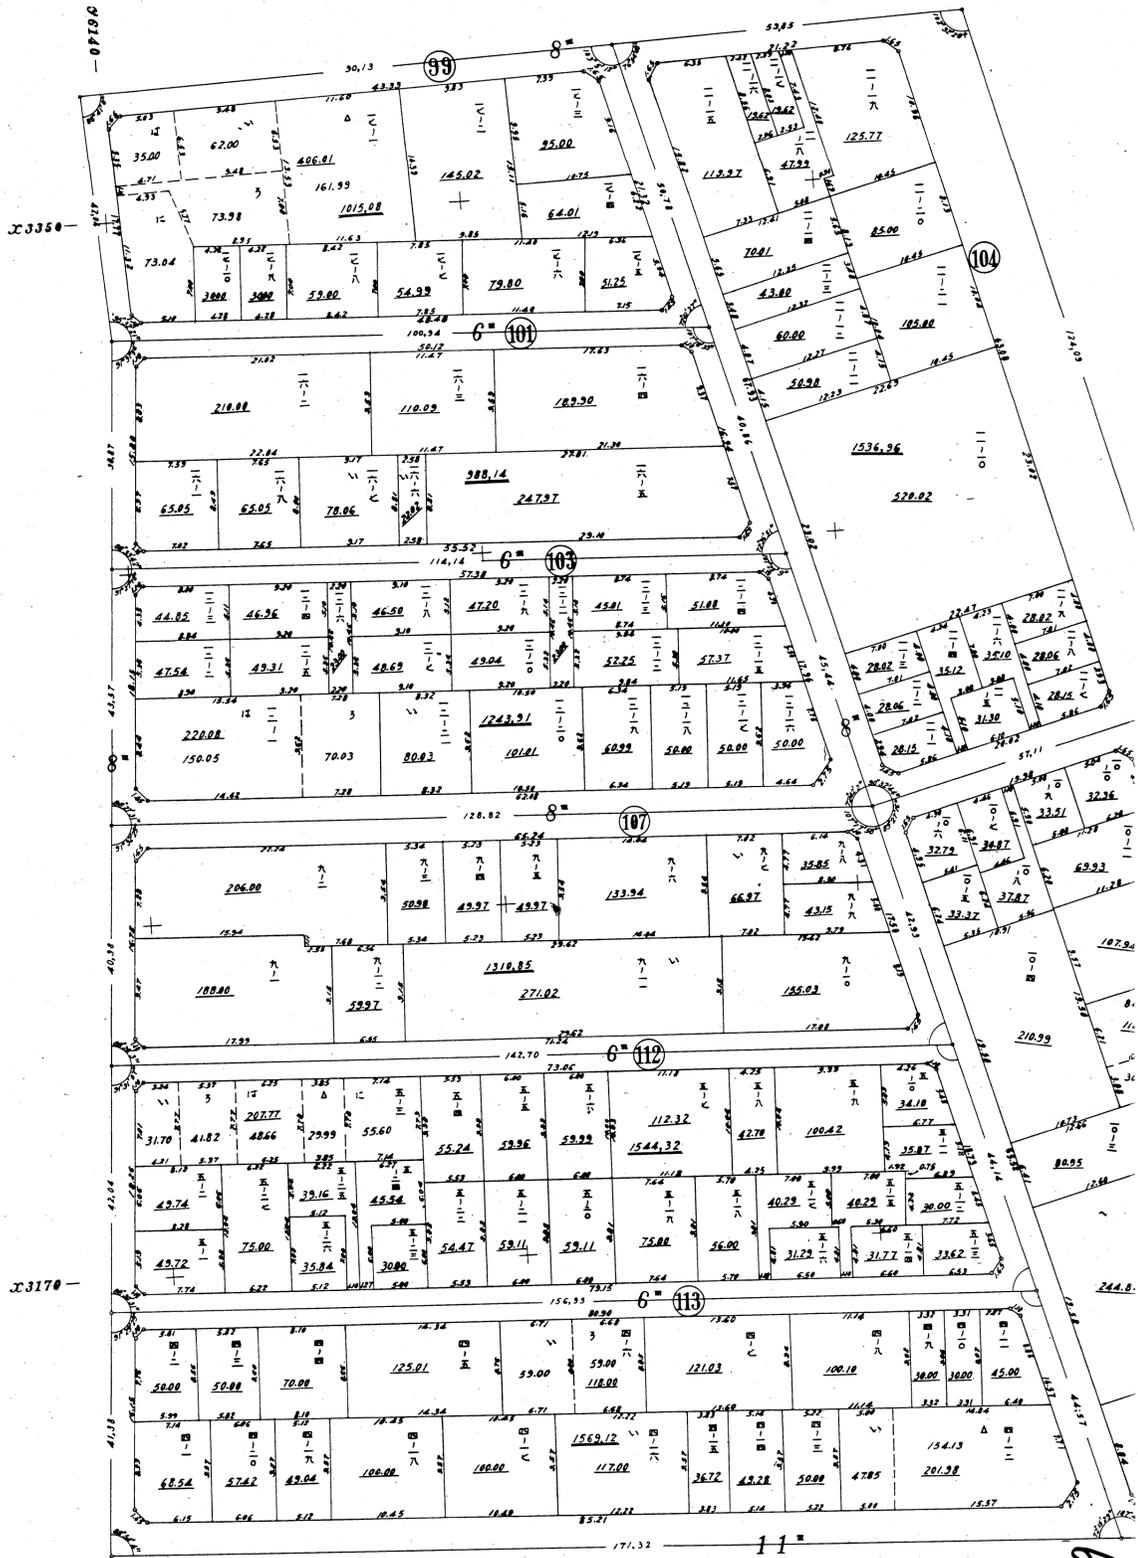

XJ350


XJ370

91-9

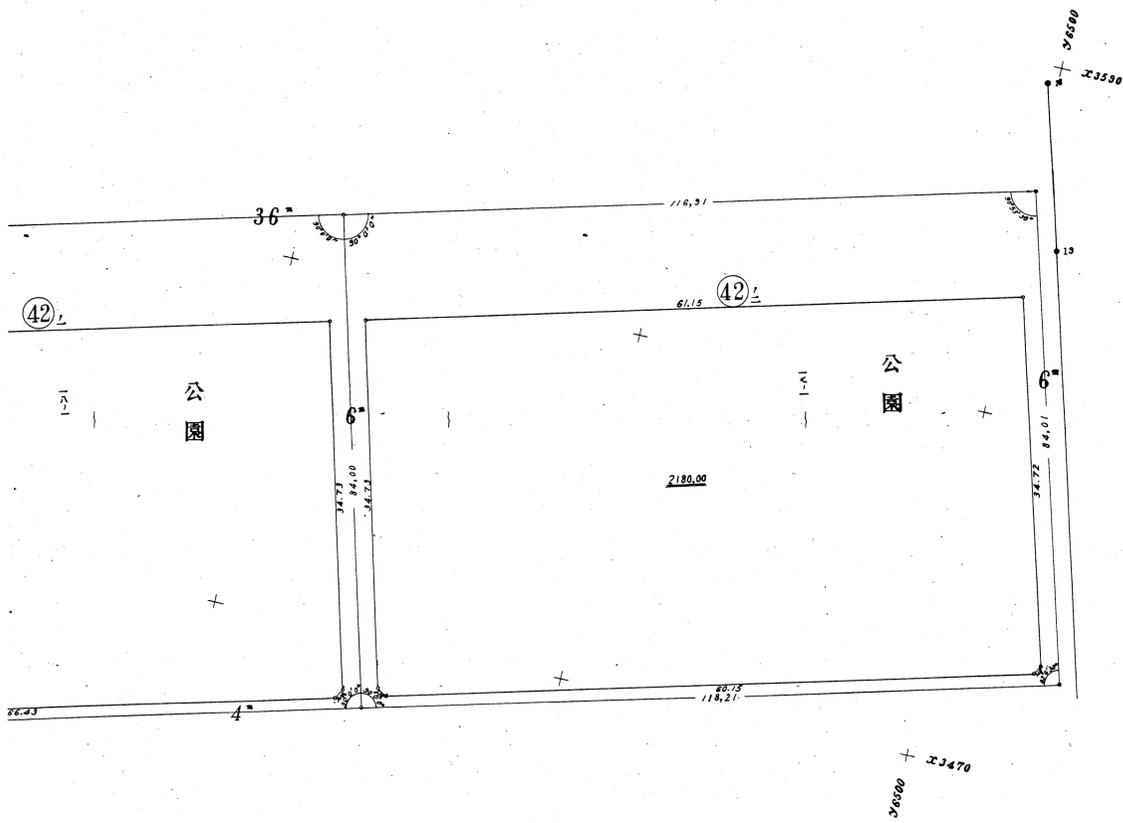


平安地区確定図十六号ノ一

6-17

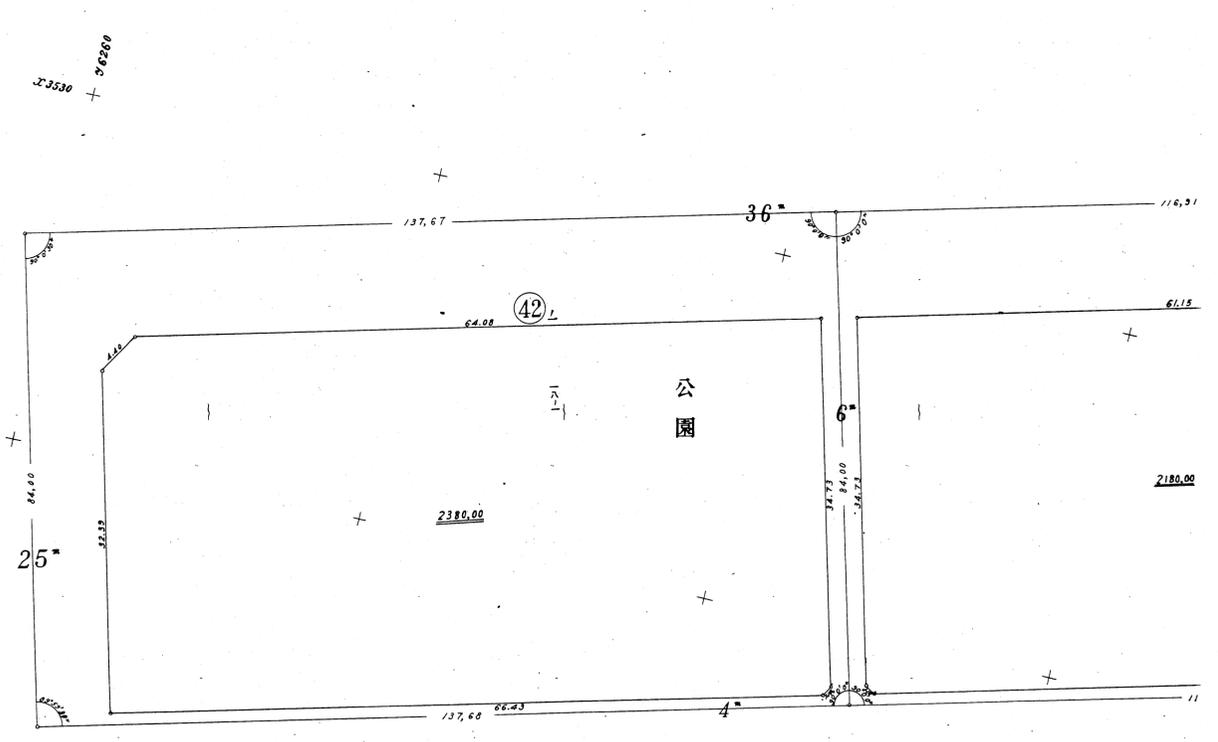


23410 +
36260


6-17

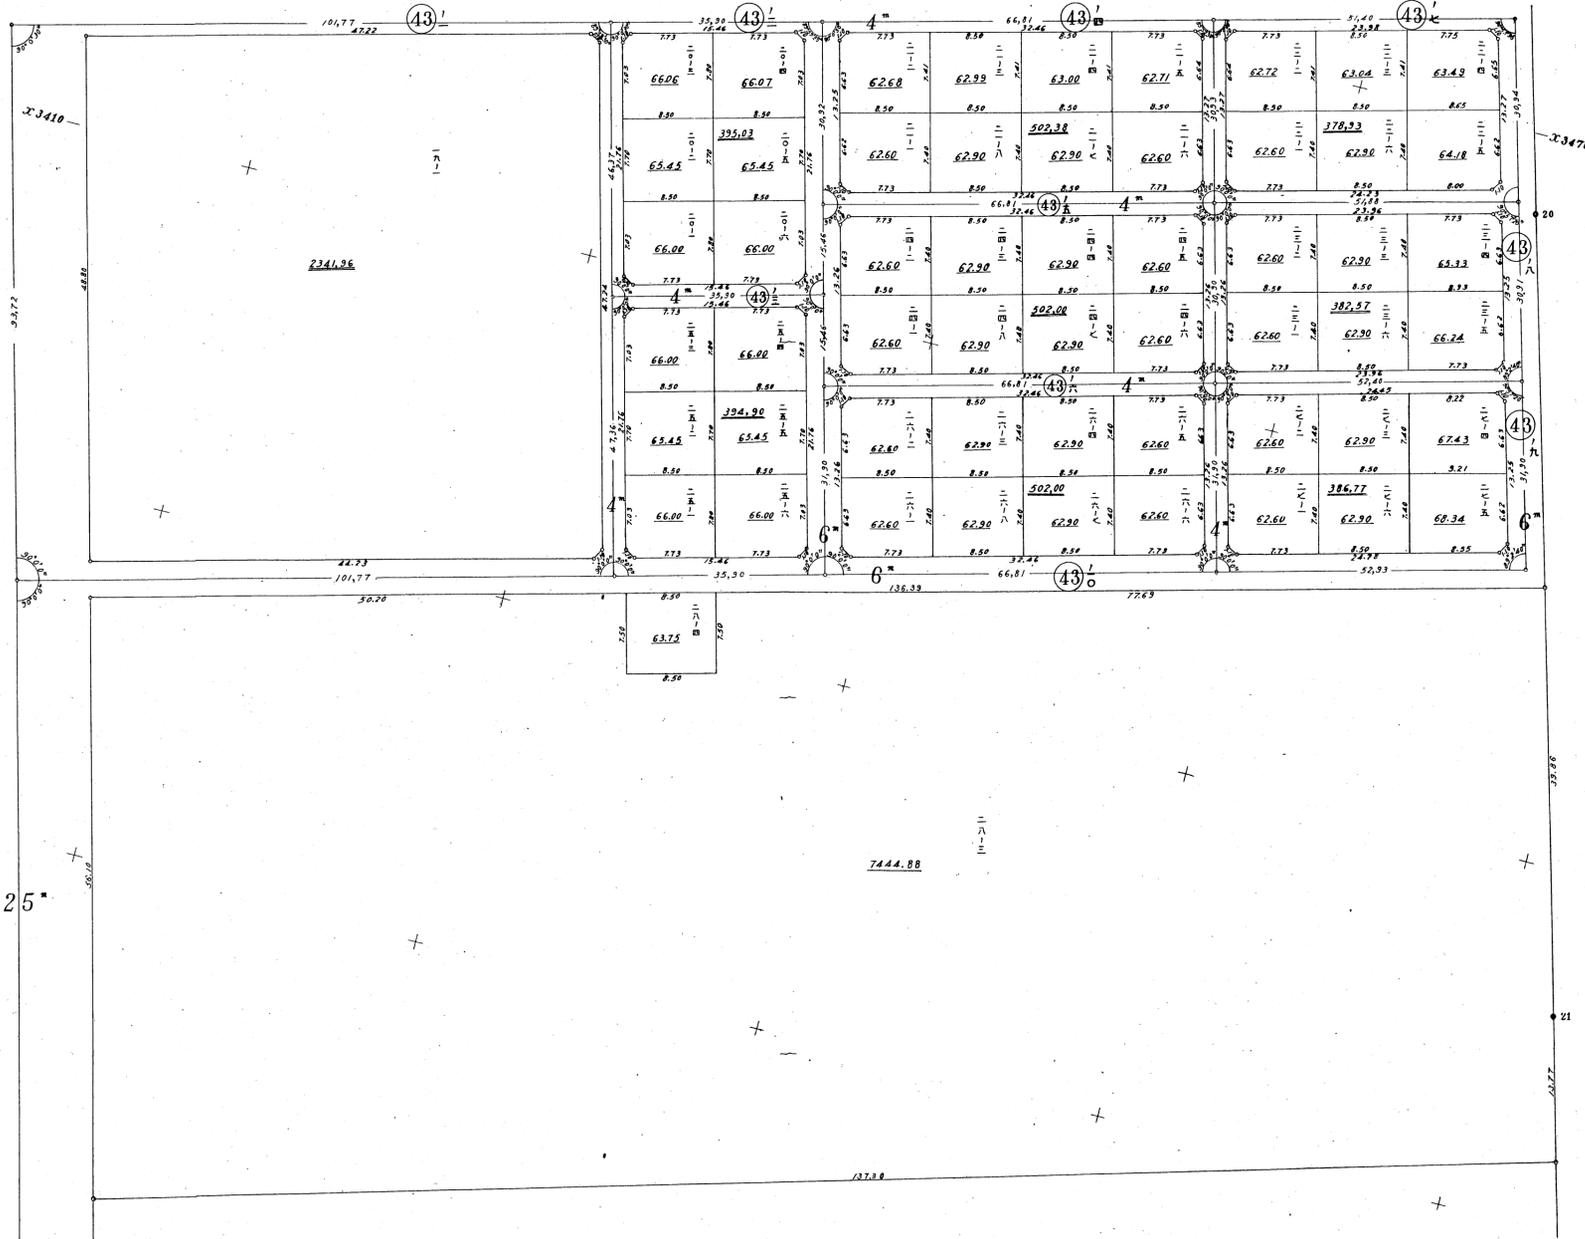

6-19

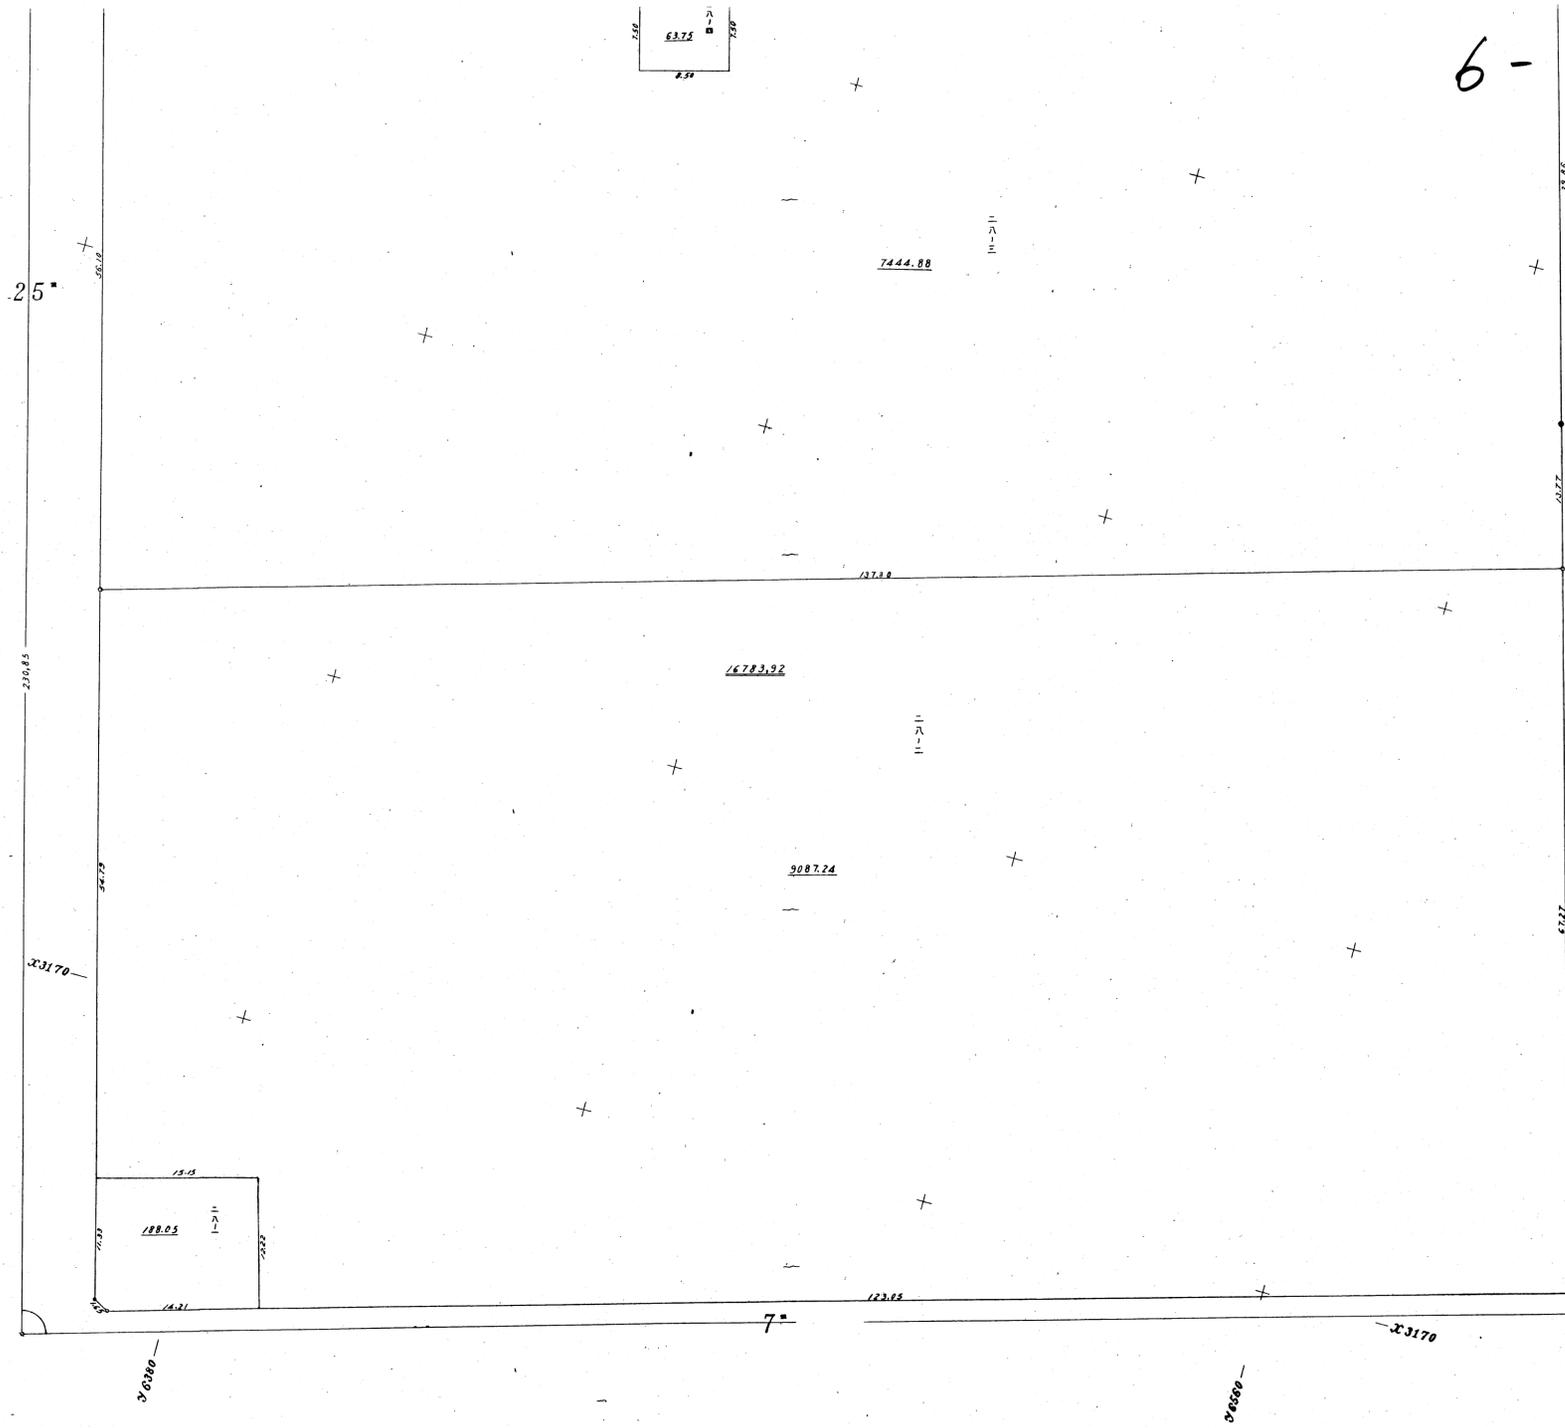

平安地区確定図第十七号

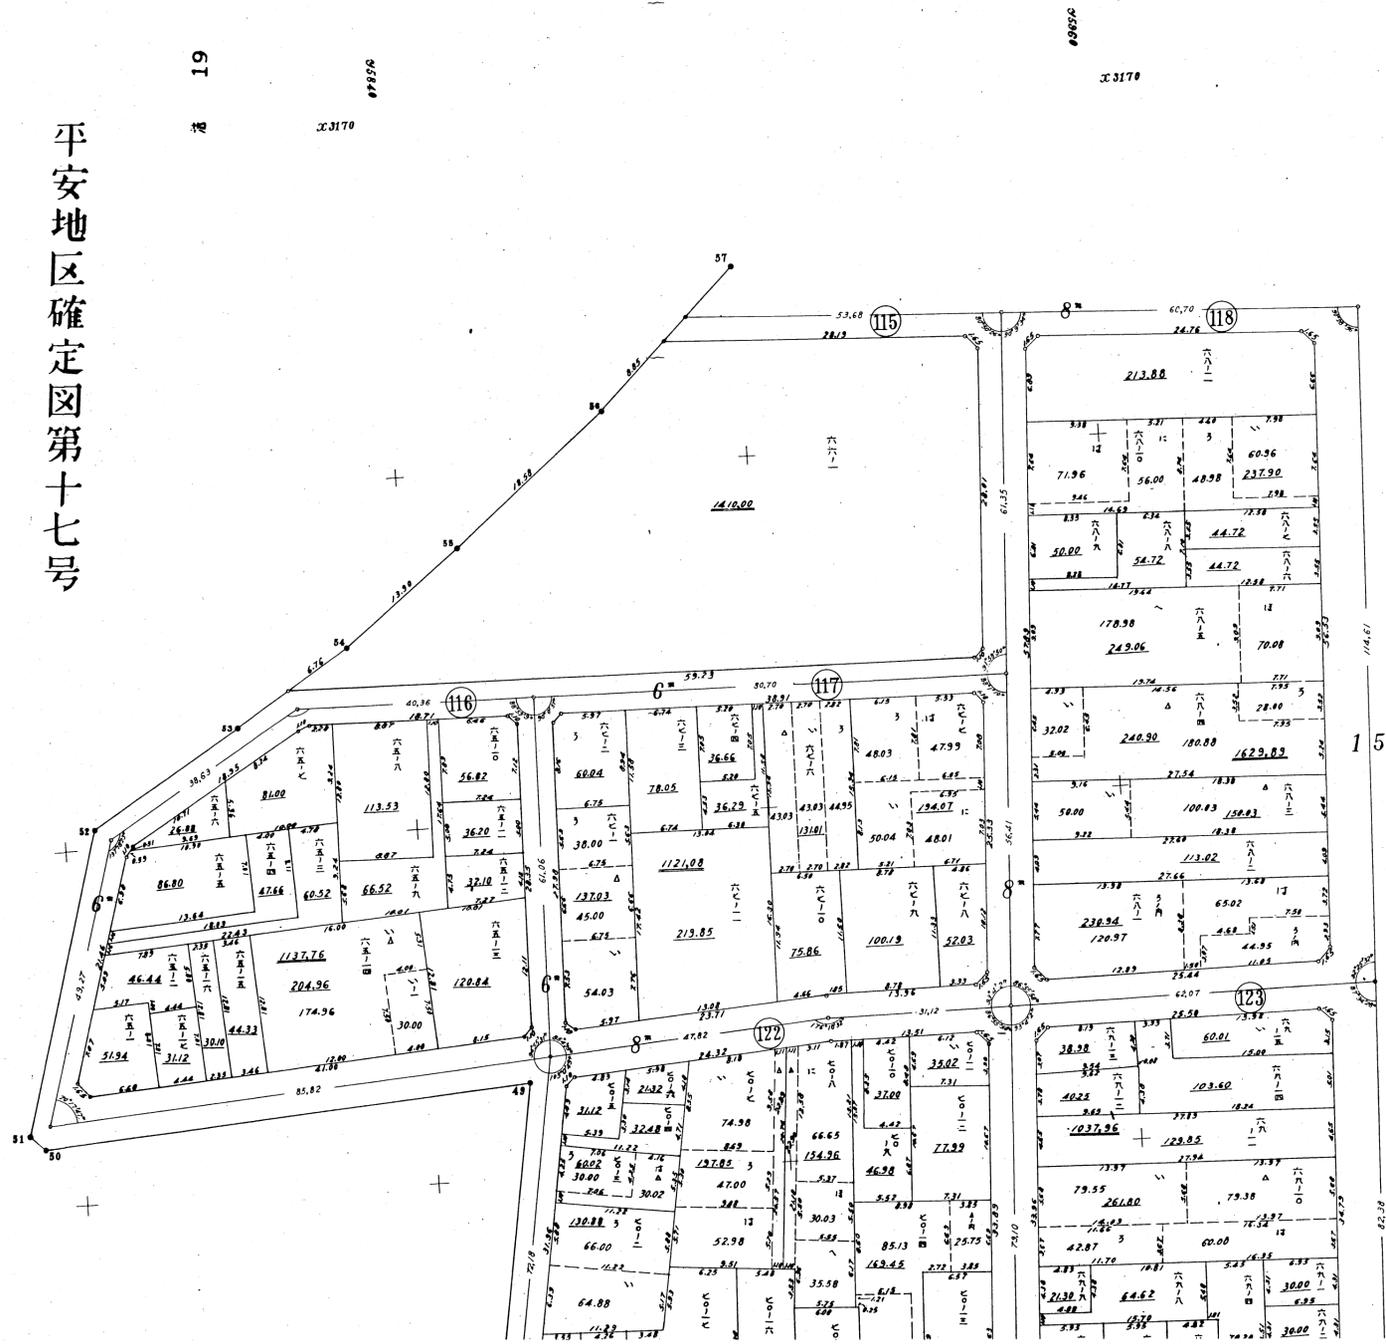




6-17
15'

公園
4226.80


08654

法 20

平安地区確定図第十八号

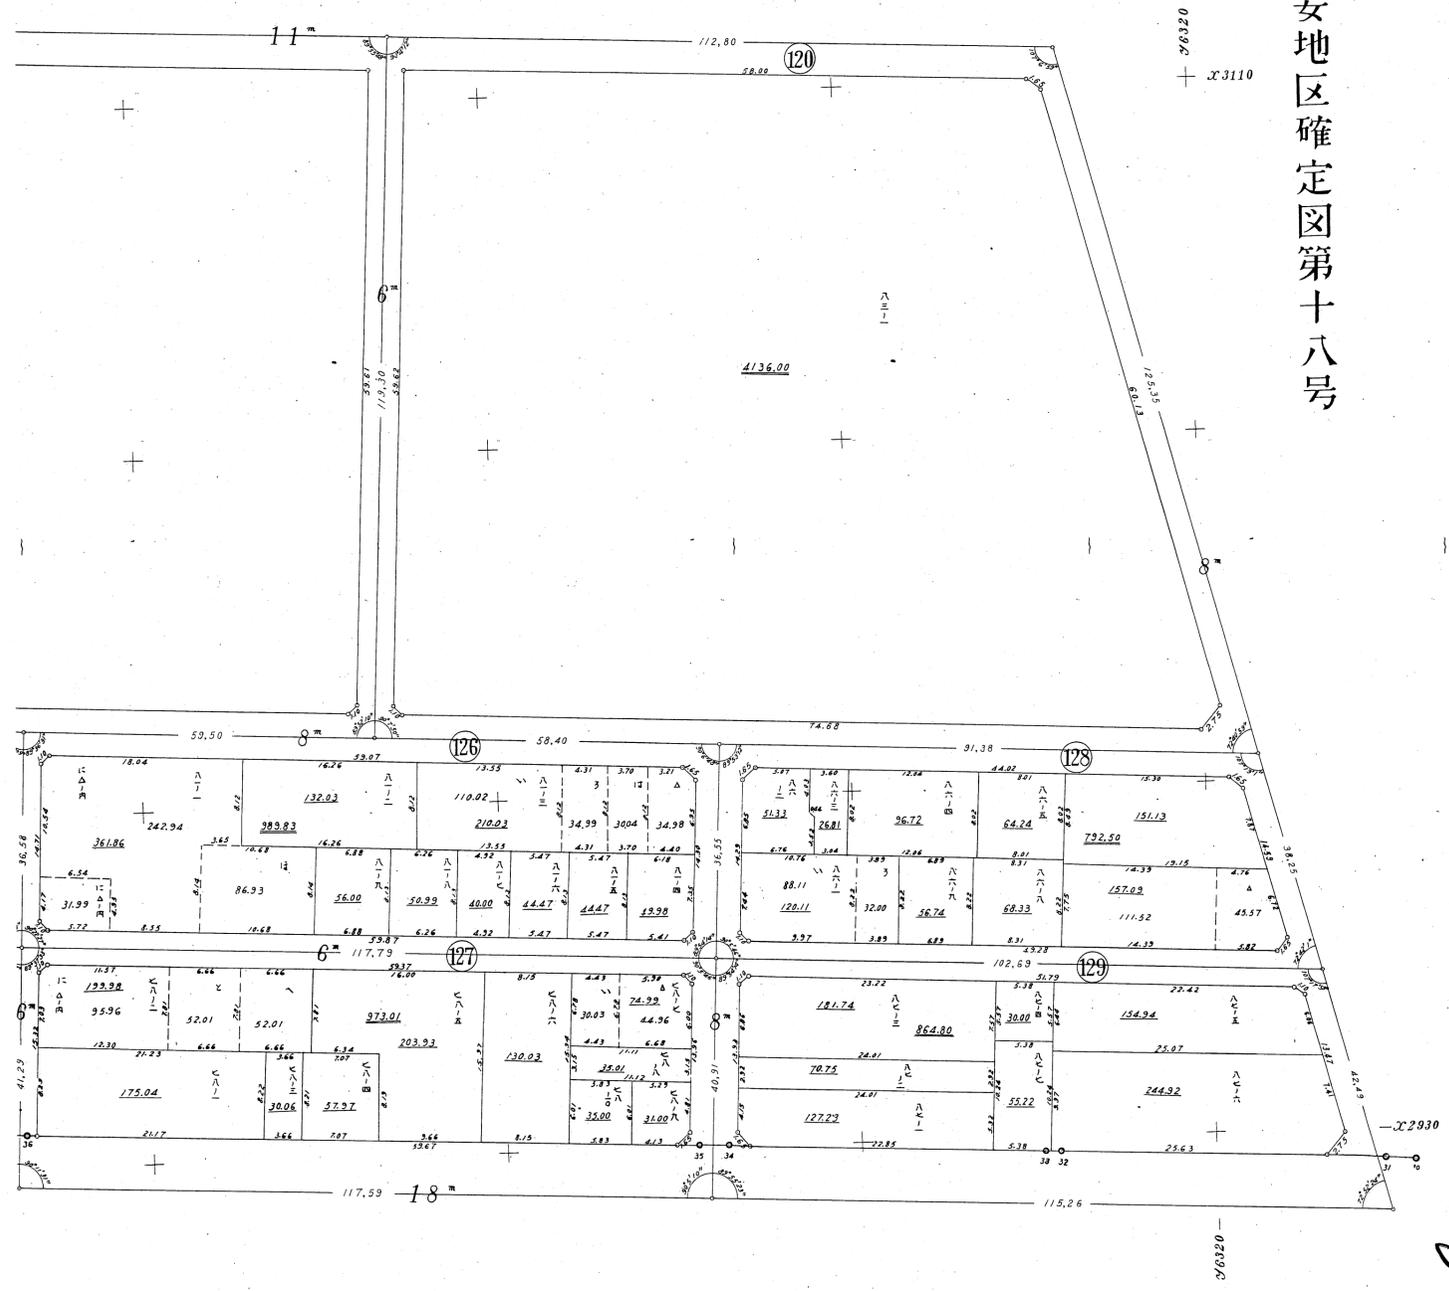


6-20

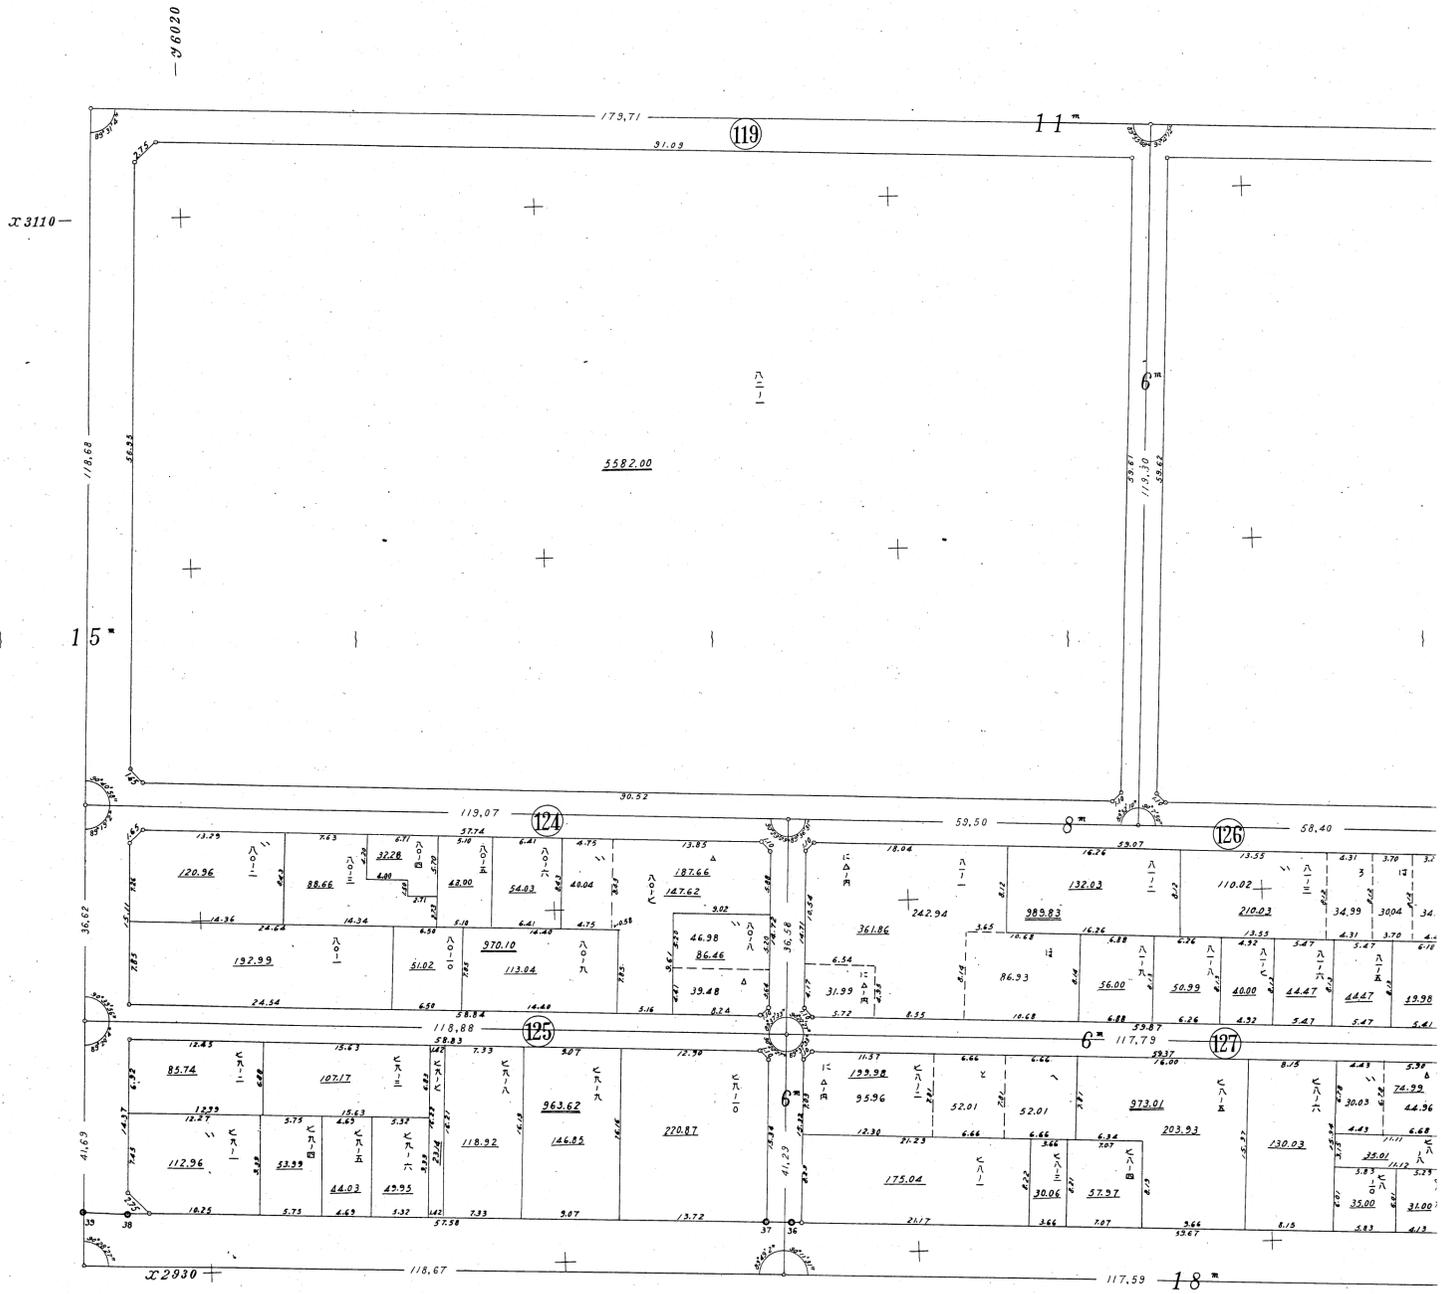

6-20

平安地区確定図第十九号

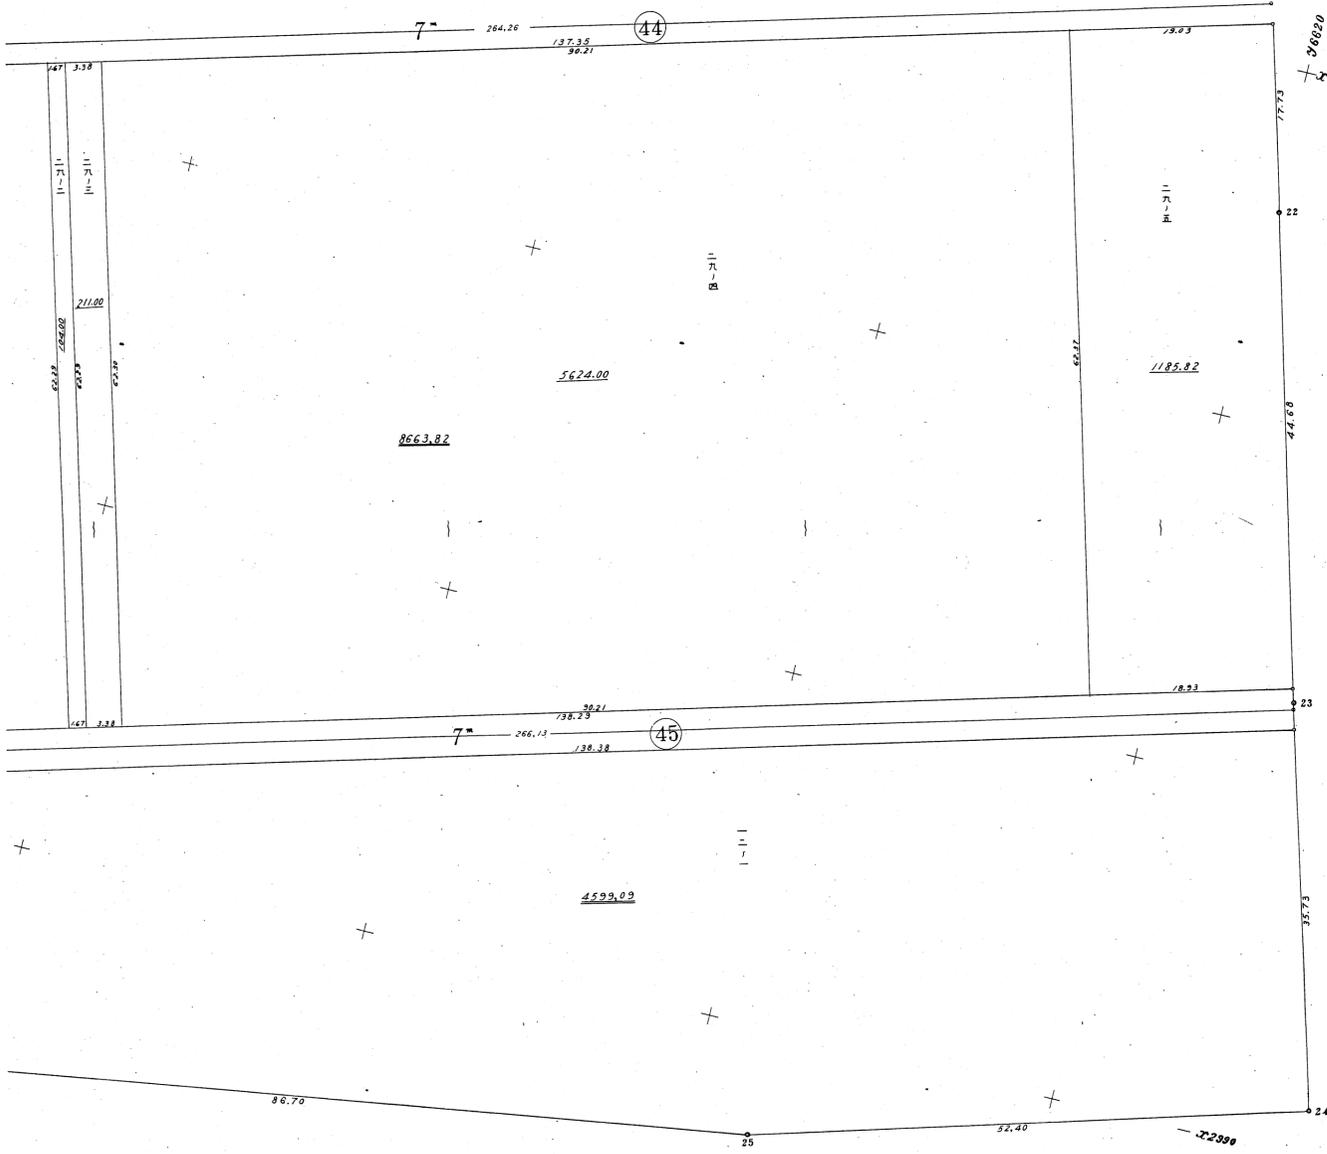

6-21

