


潮田地区確定図索引

赤字は図面番号

この頁は当地区の索引図（頁照合用）として
本市職員が作成したものです。

赤字は、頁（ページ）番号になります。

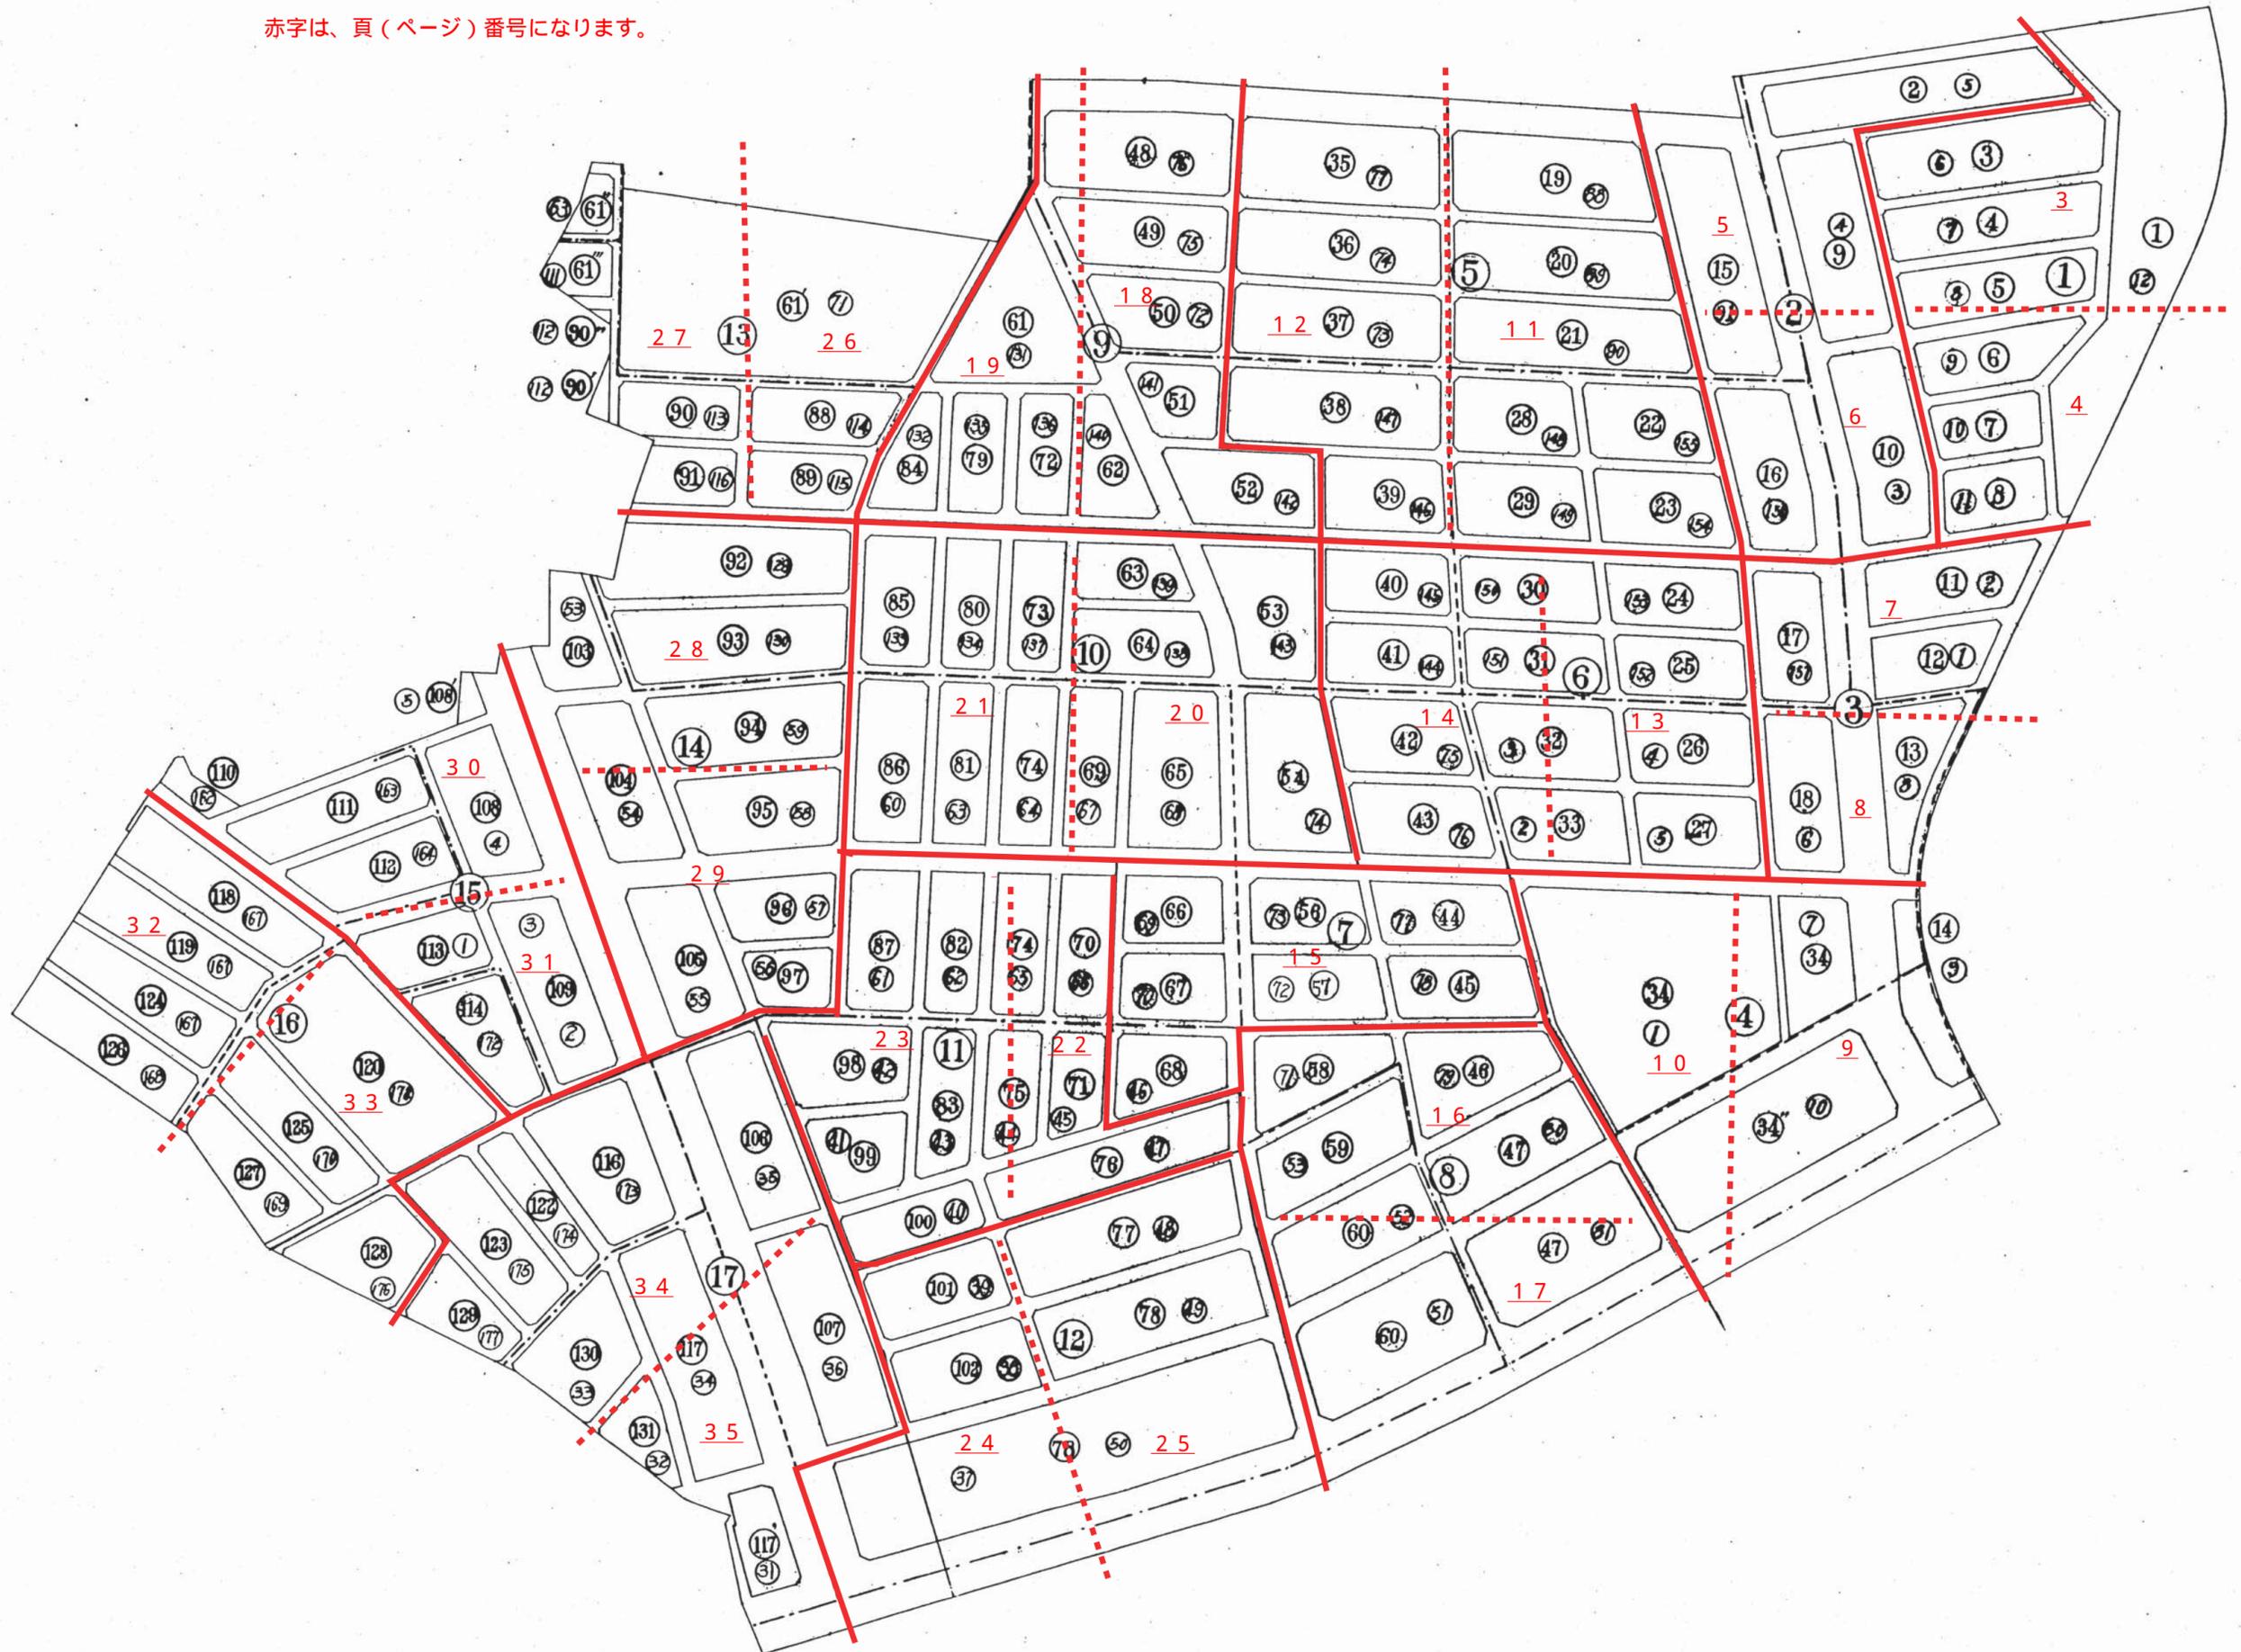

1-1


② 新地番

第 2

潮田地区確定図索引


赤字は図面番号




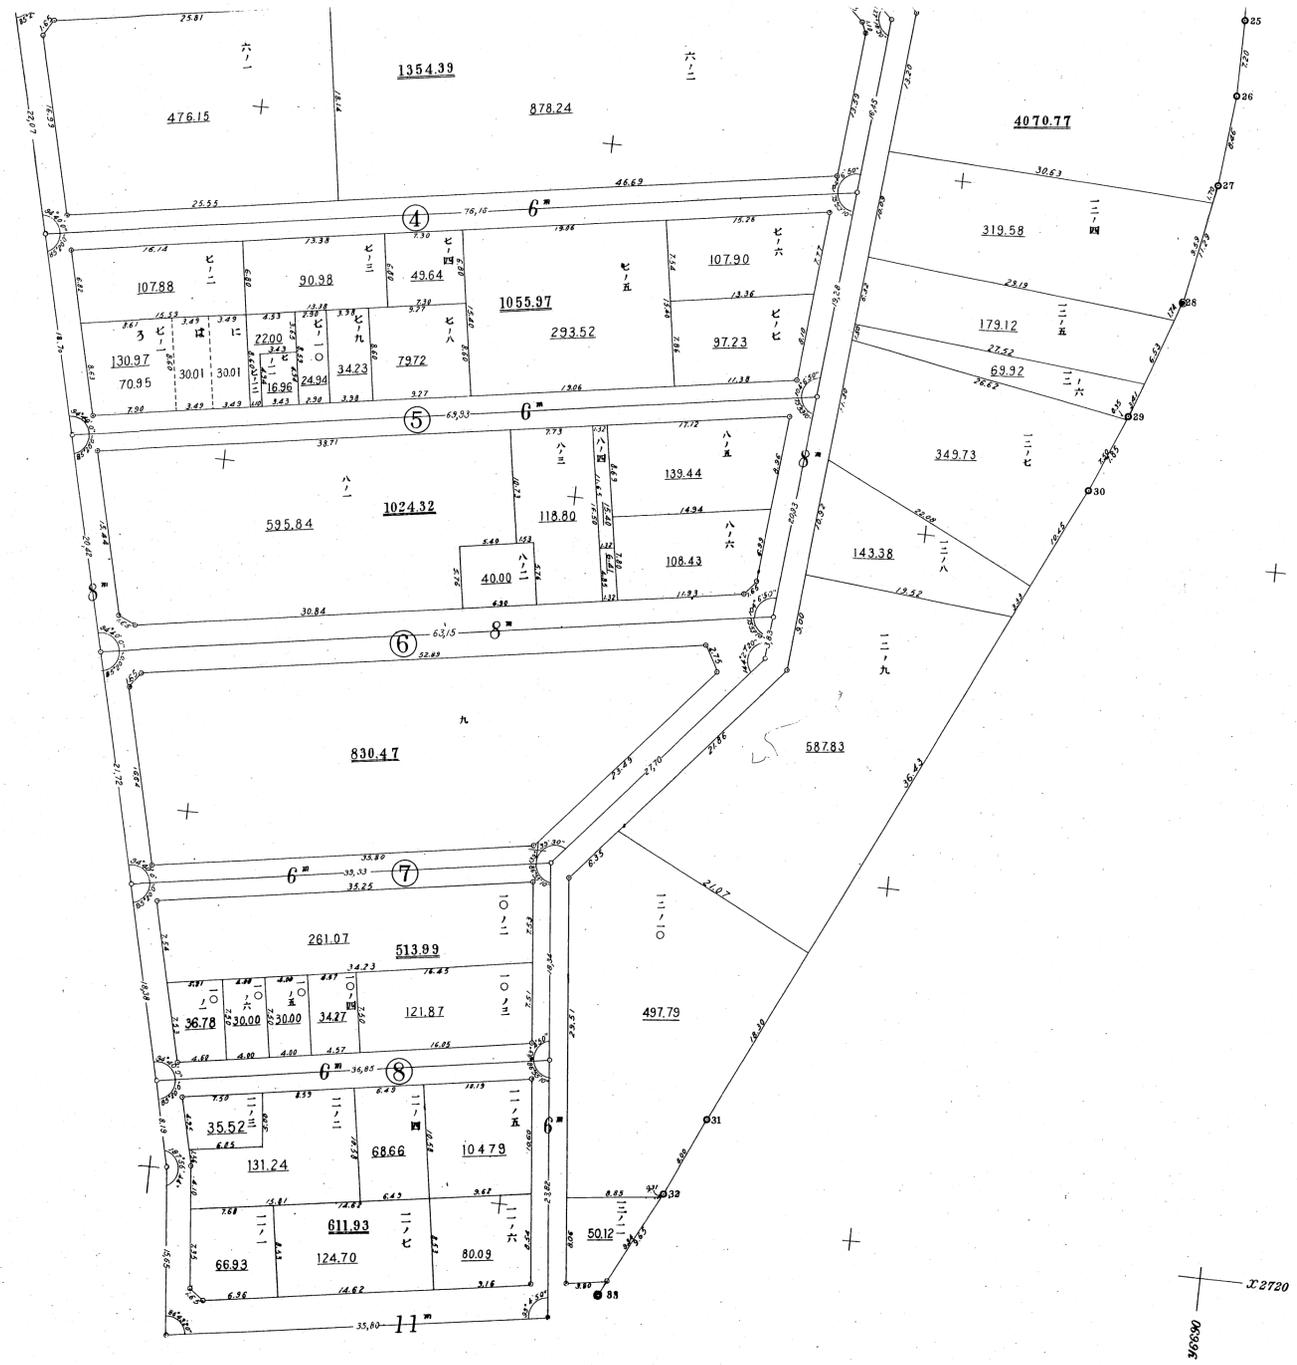

1-2

366590
J.2720

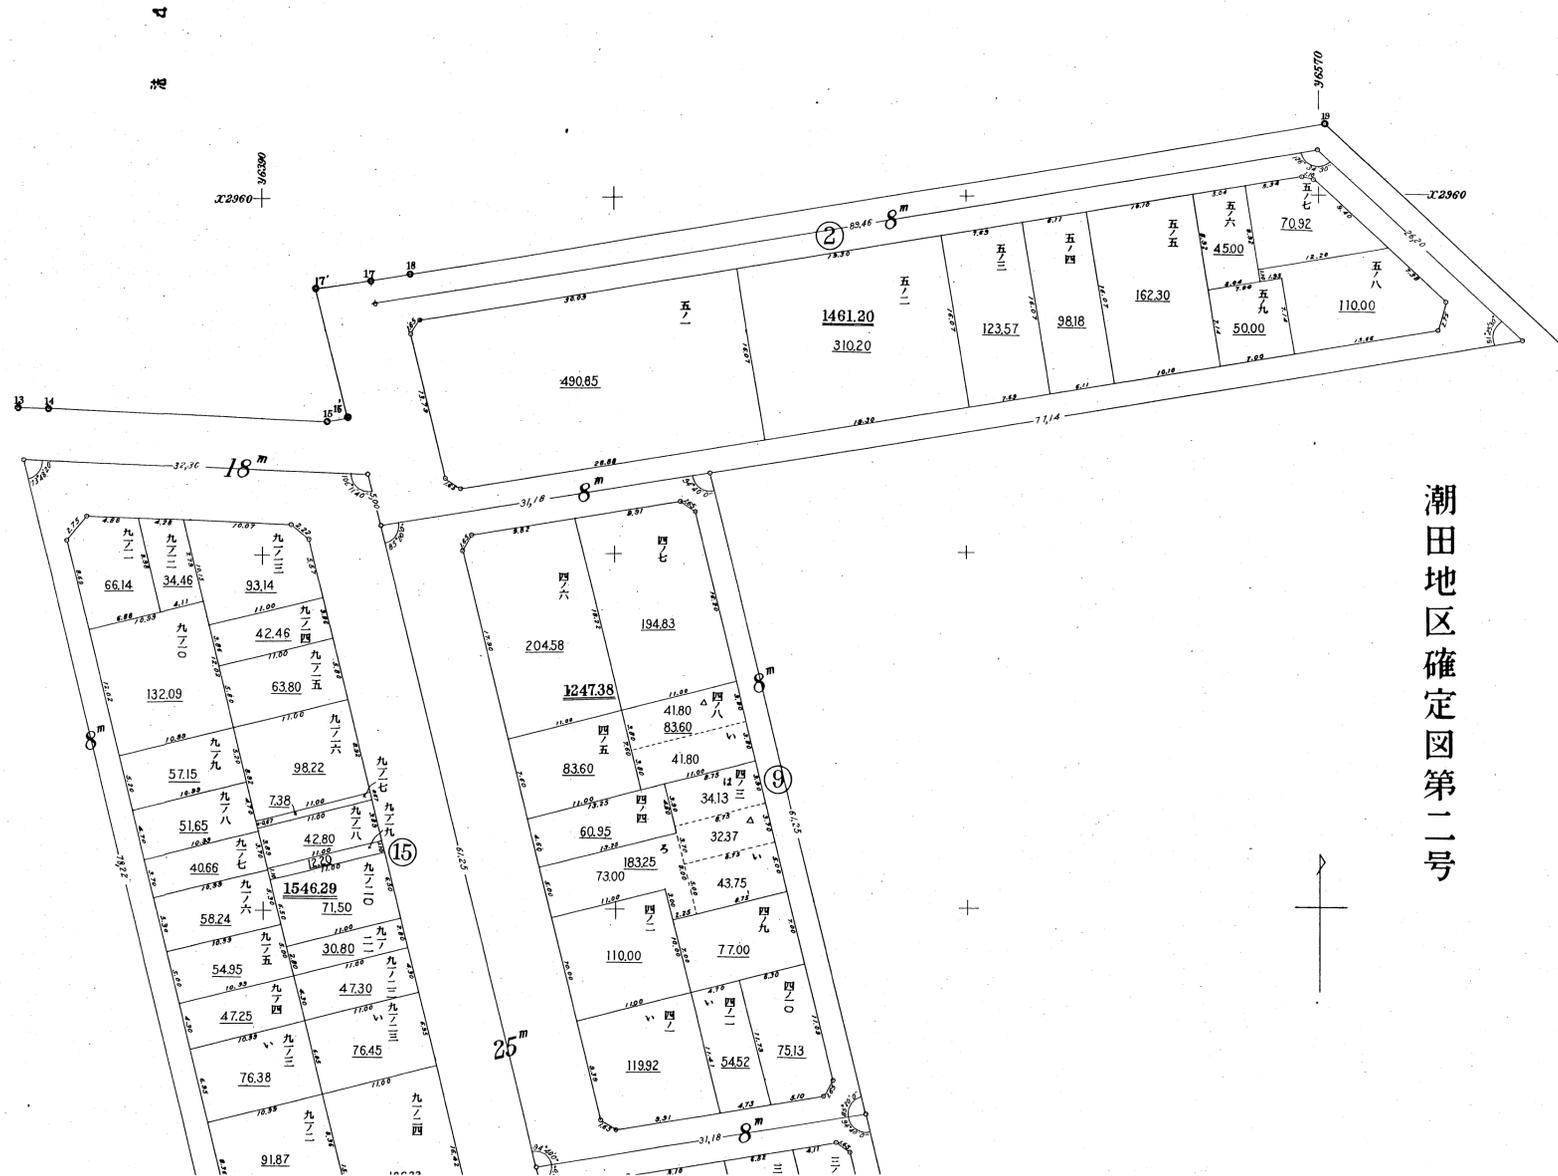

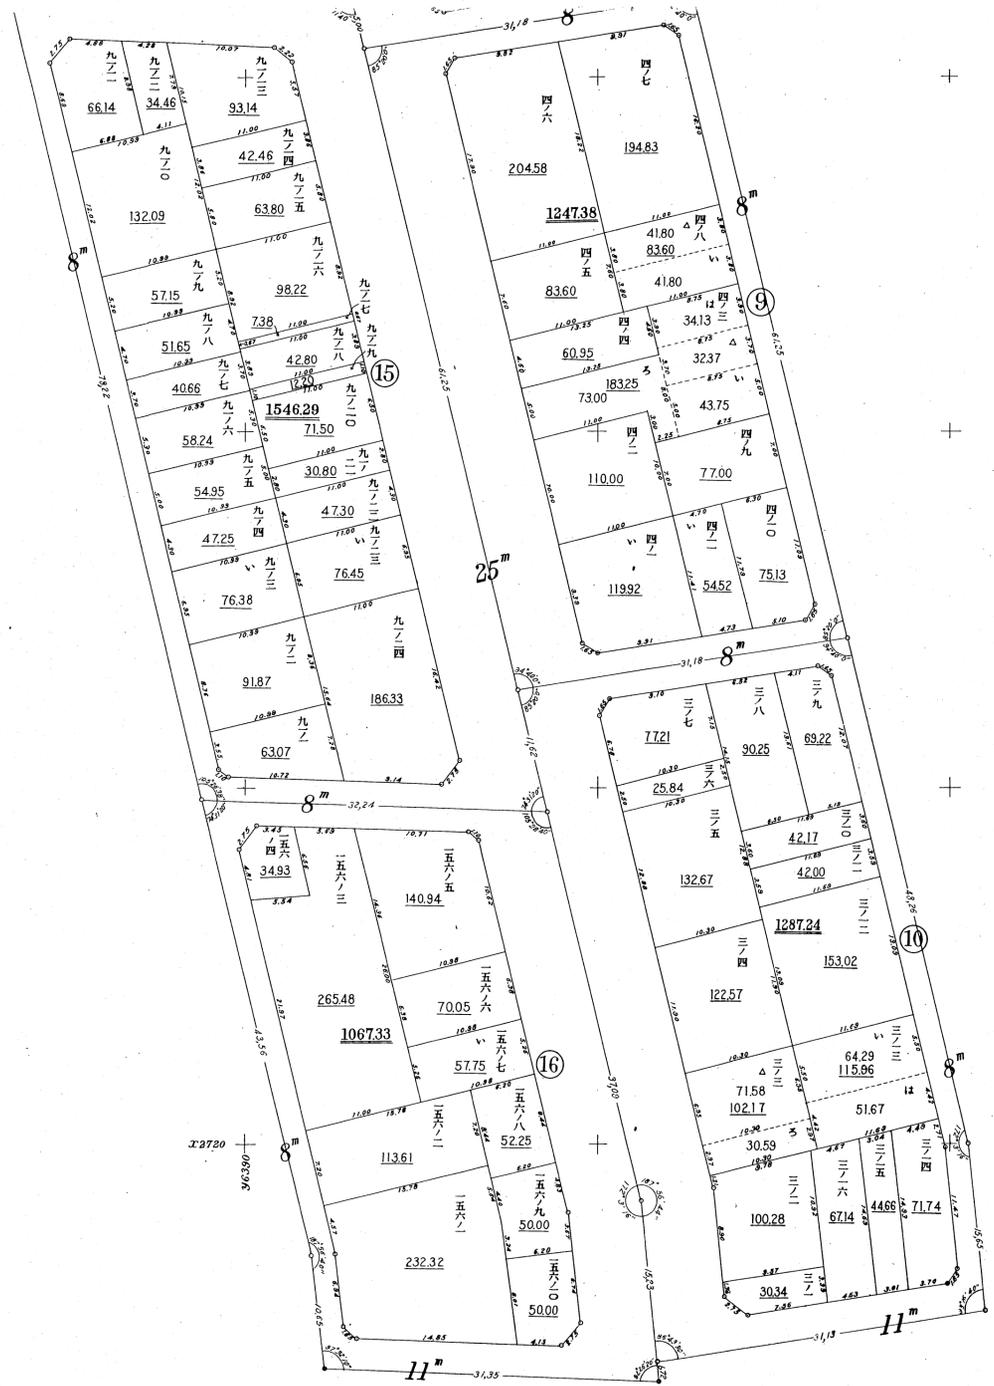


潮田地区確定図第二号

1-3



36390

36570

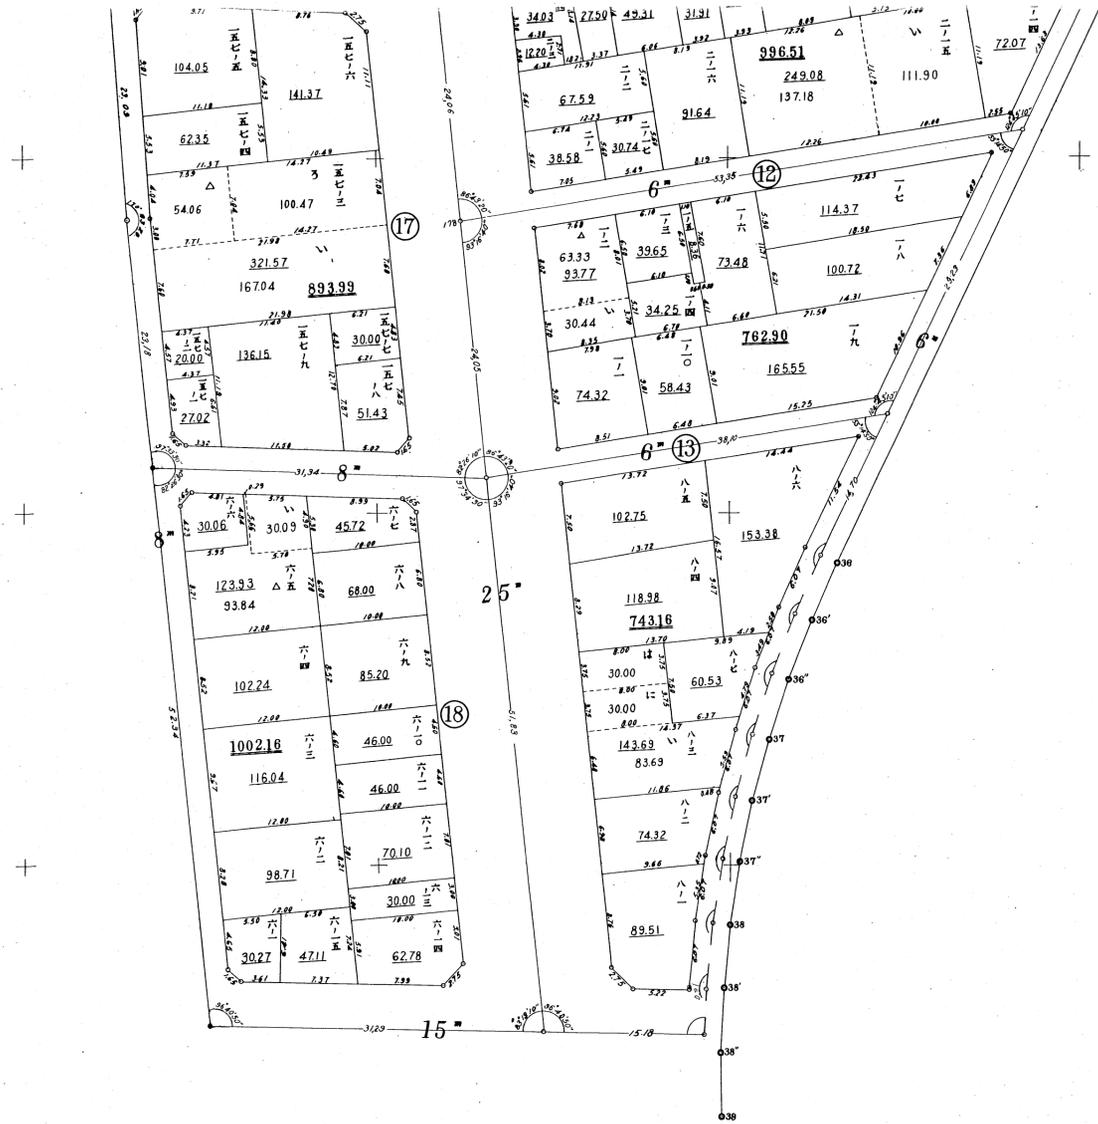


号

1-4


22470
56530

22470
56530

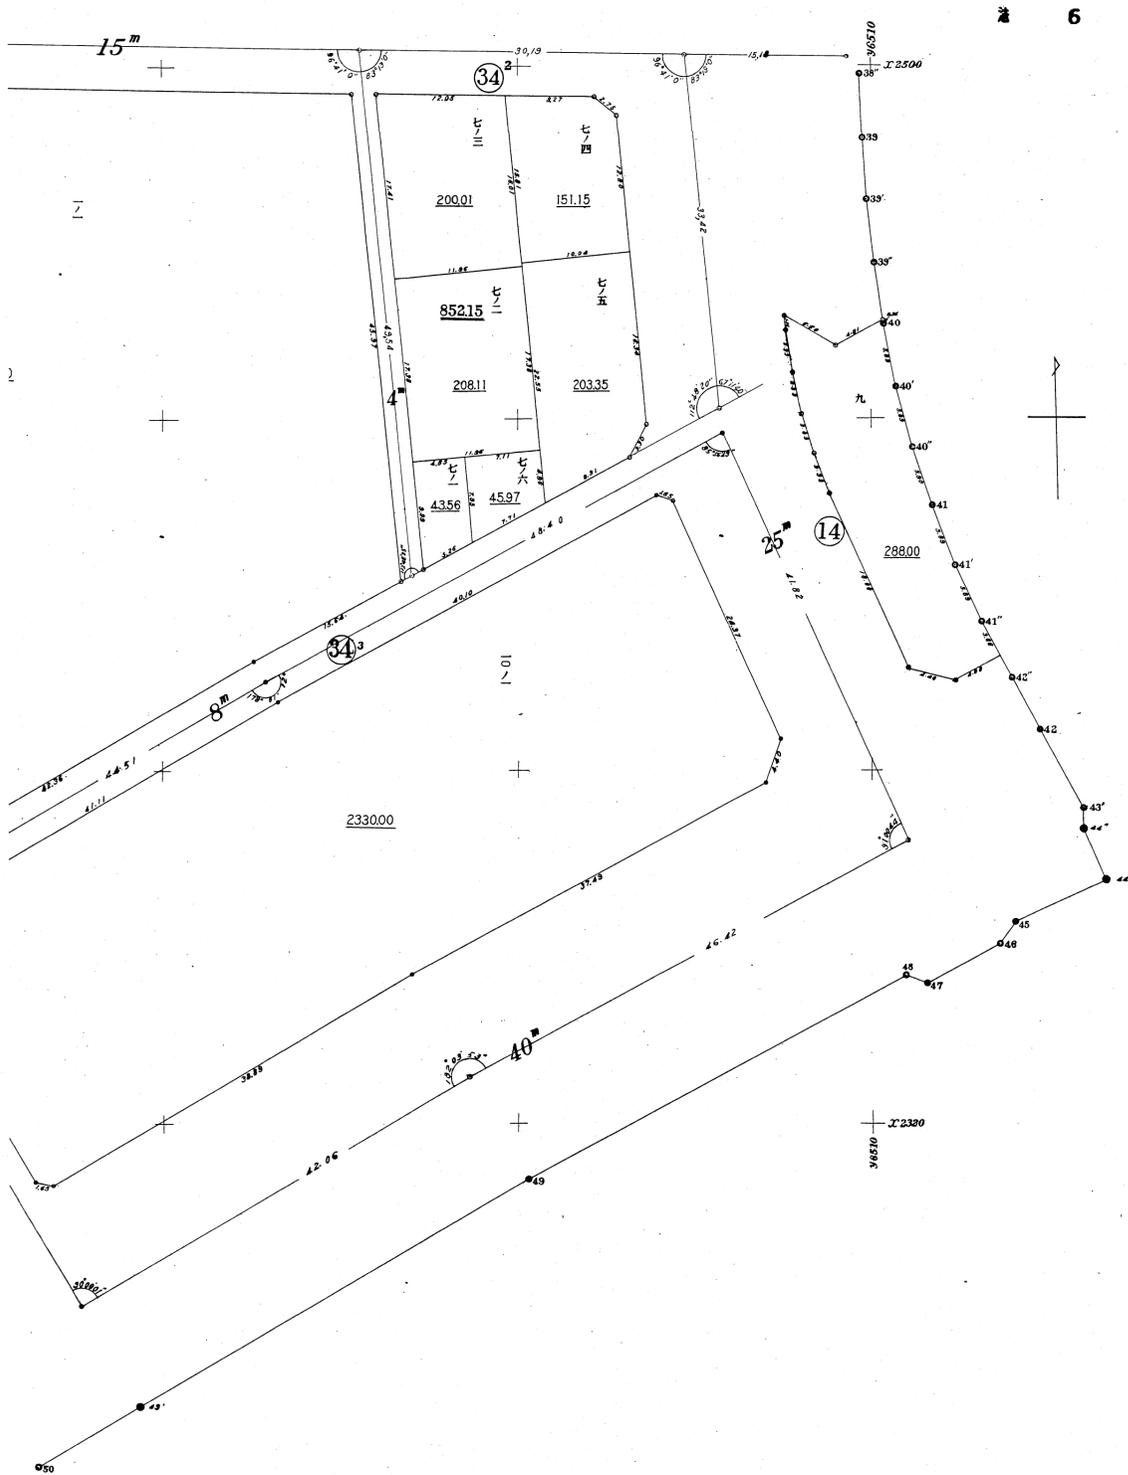

潮田地区確定図第四号

1-5

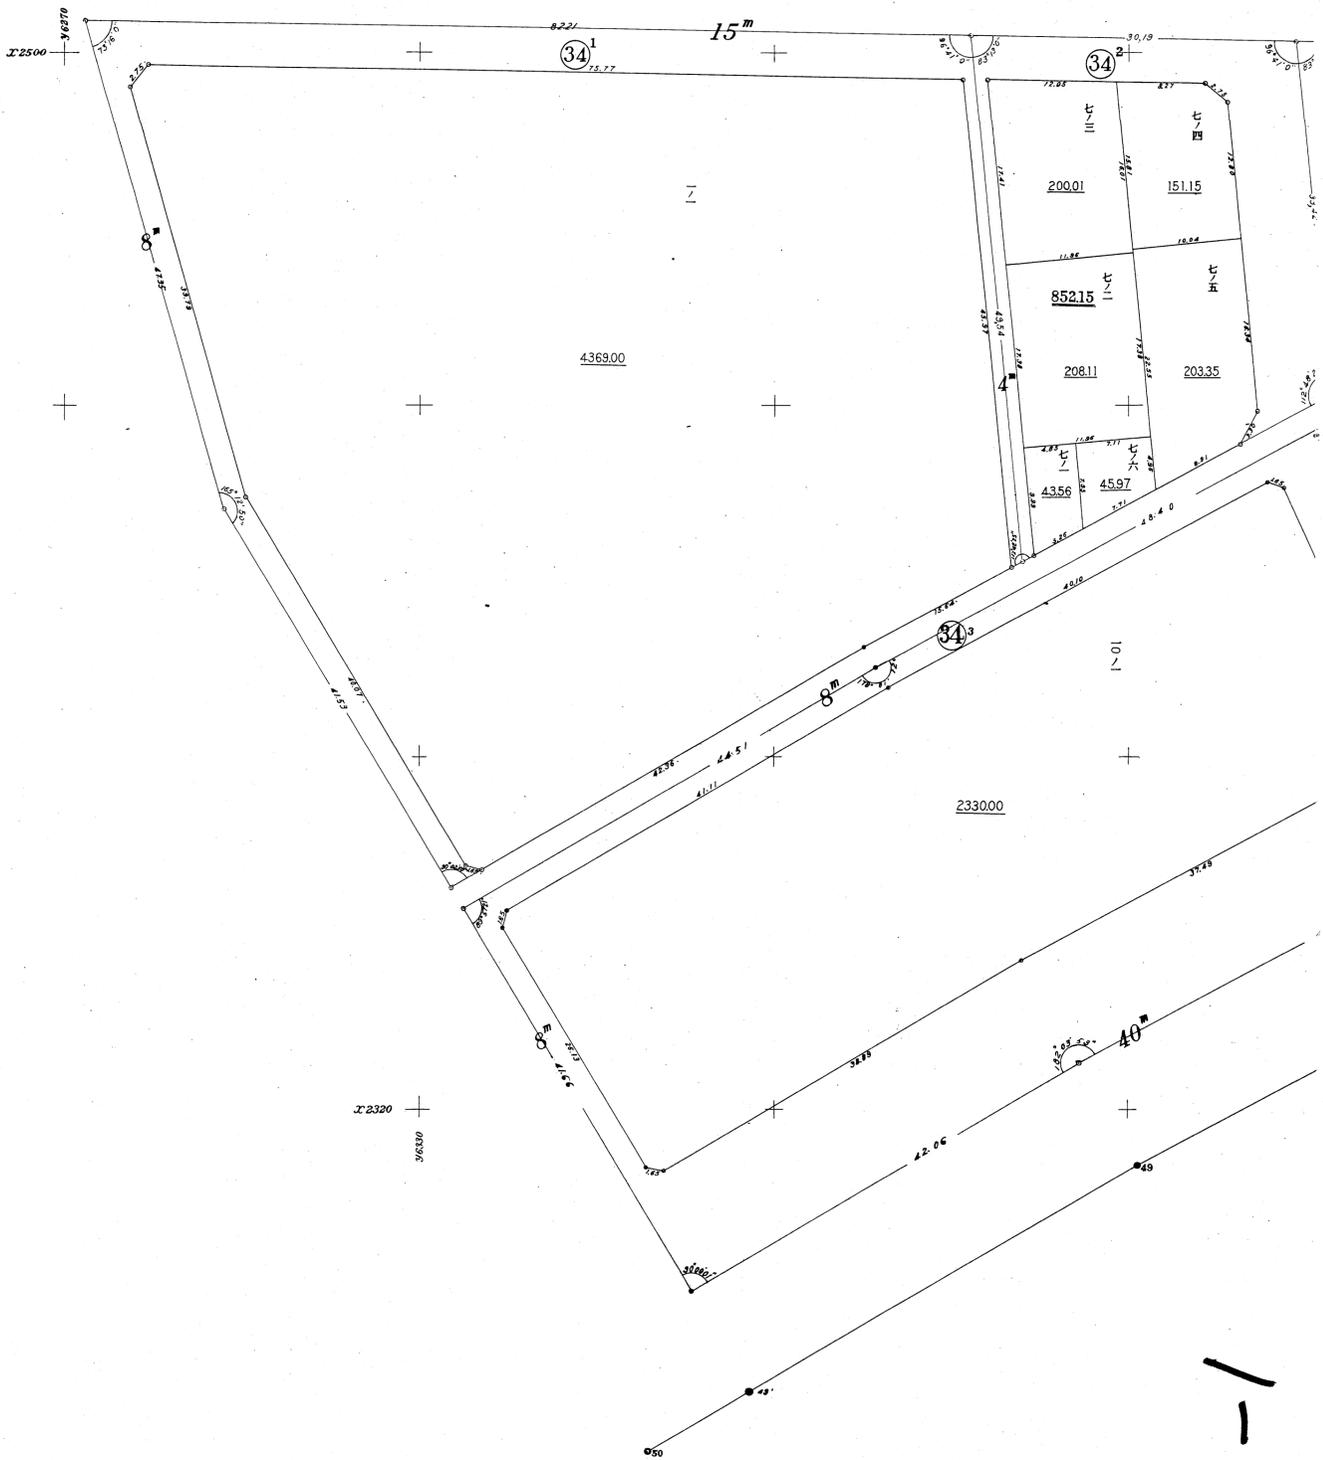


1-5

22820 30000

+

+


22740 30000

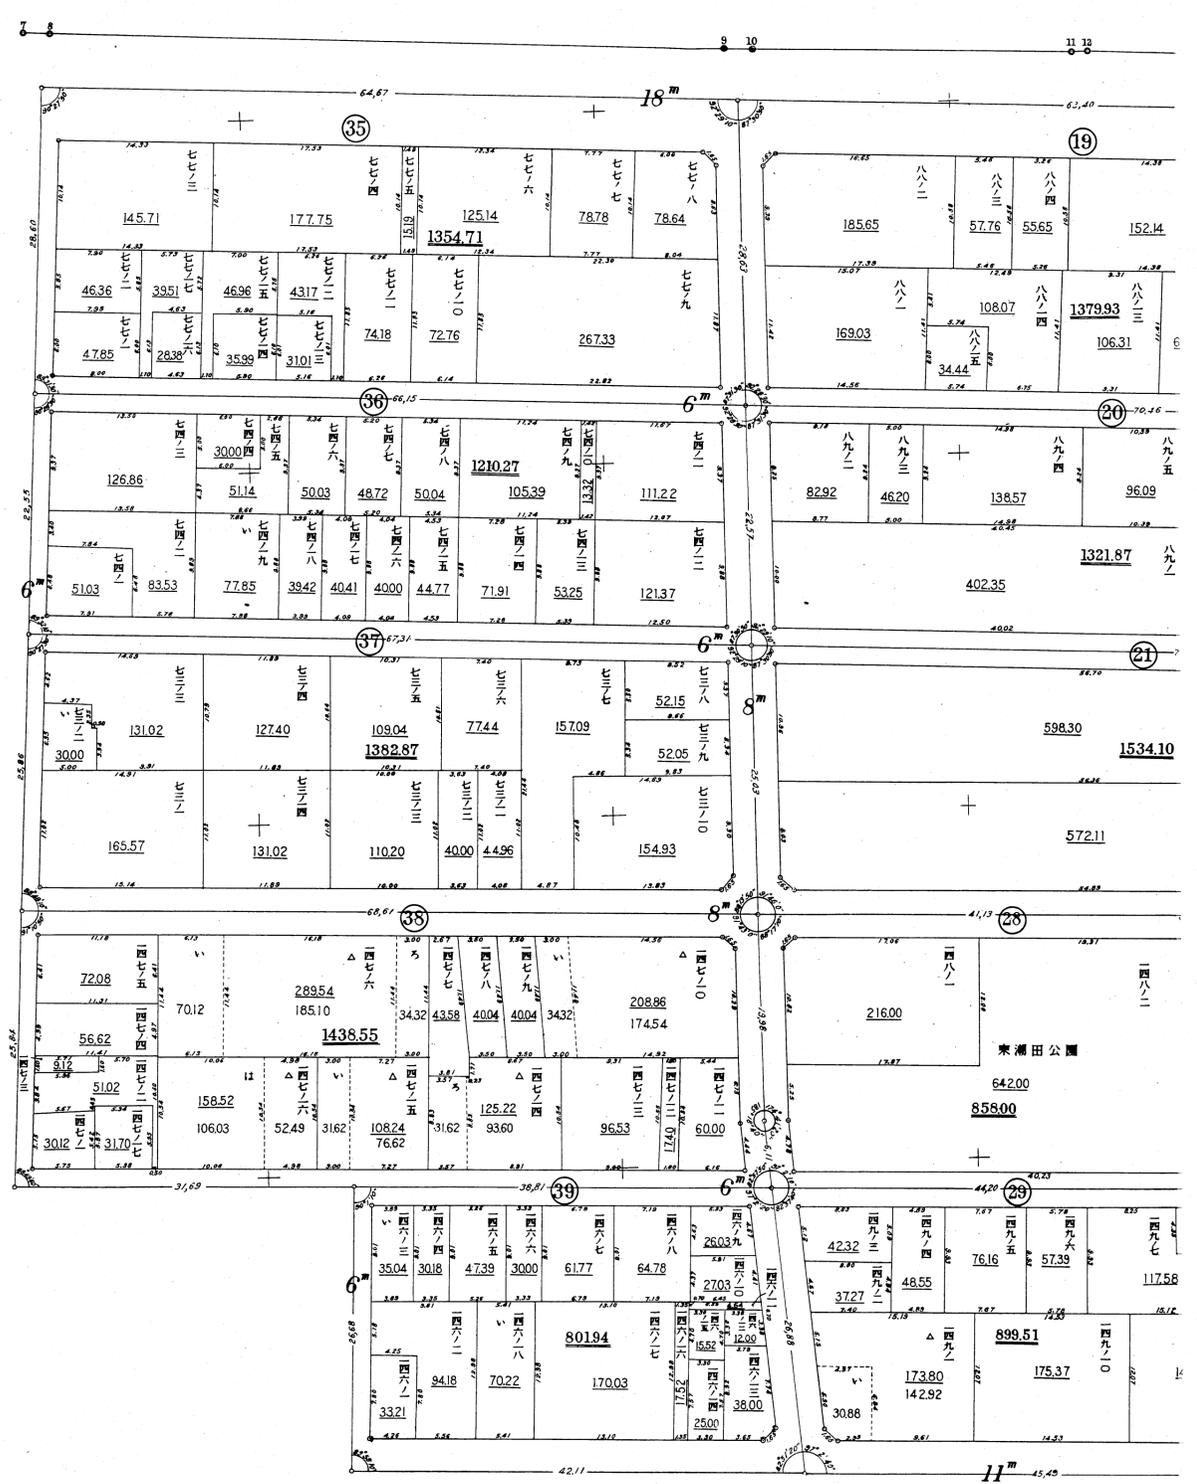

1-6

港 8


潮田地区確定図第六号

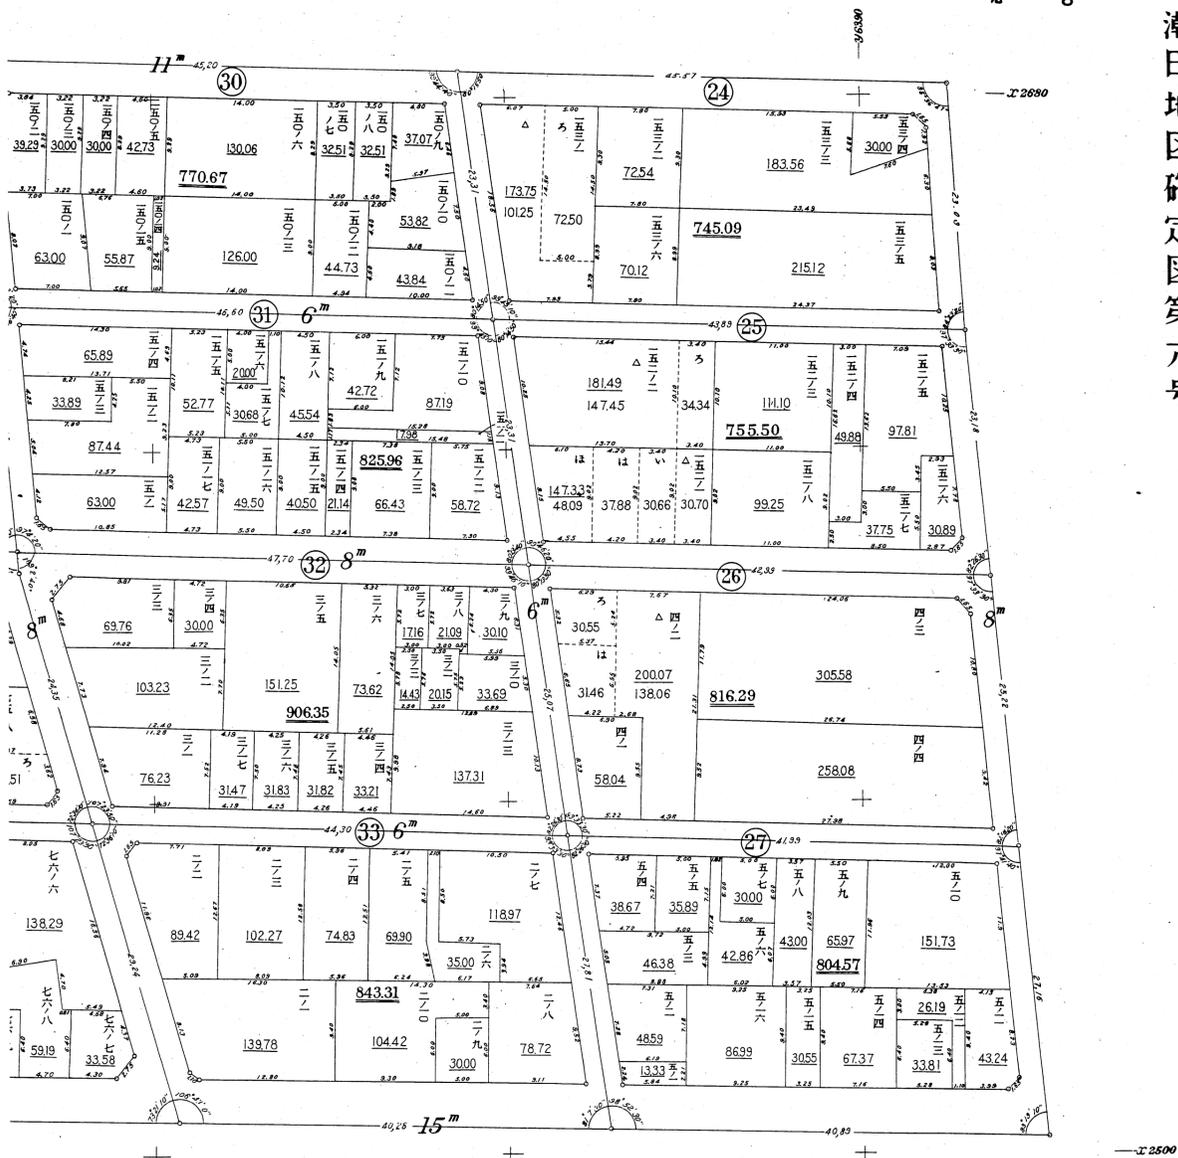

1-7


1-8

潮田地区確定図第七号

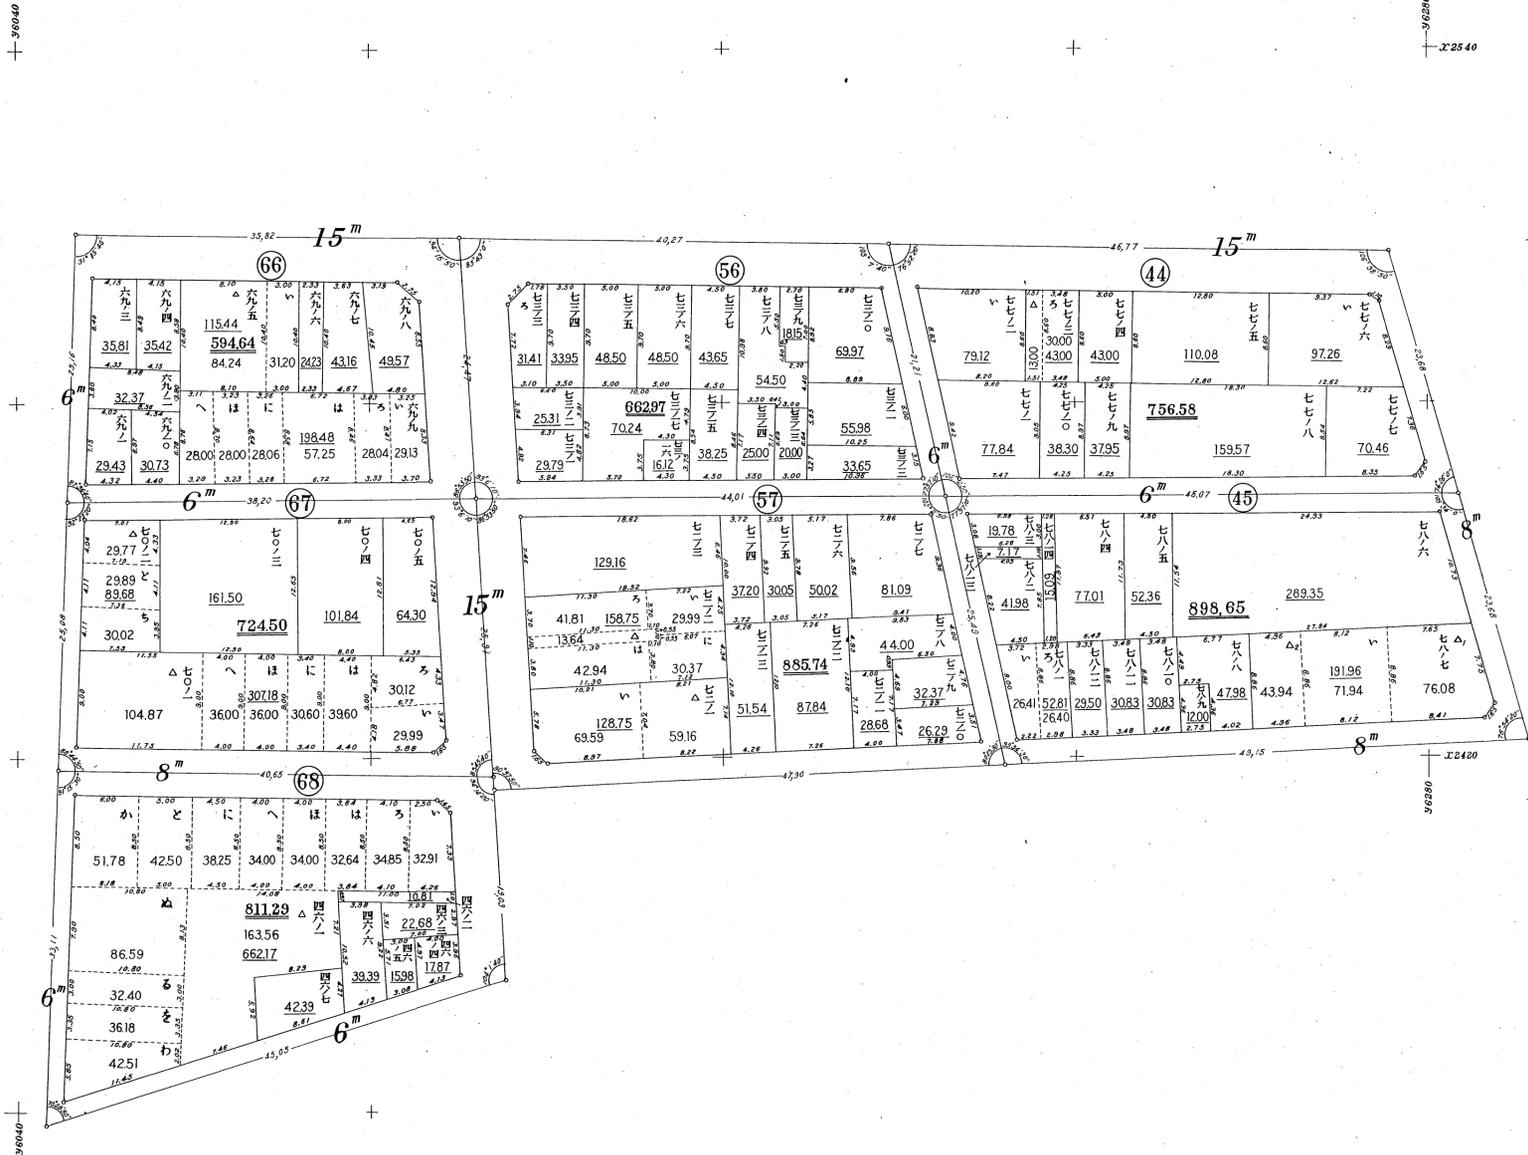

潮田地区確定図第八号



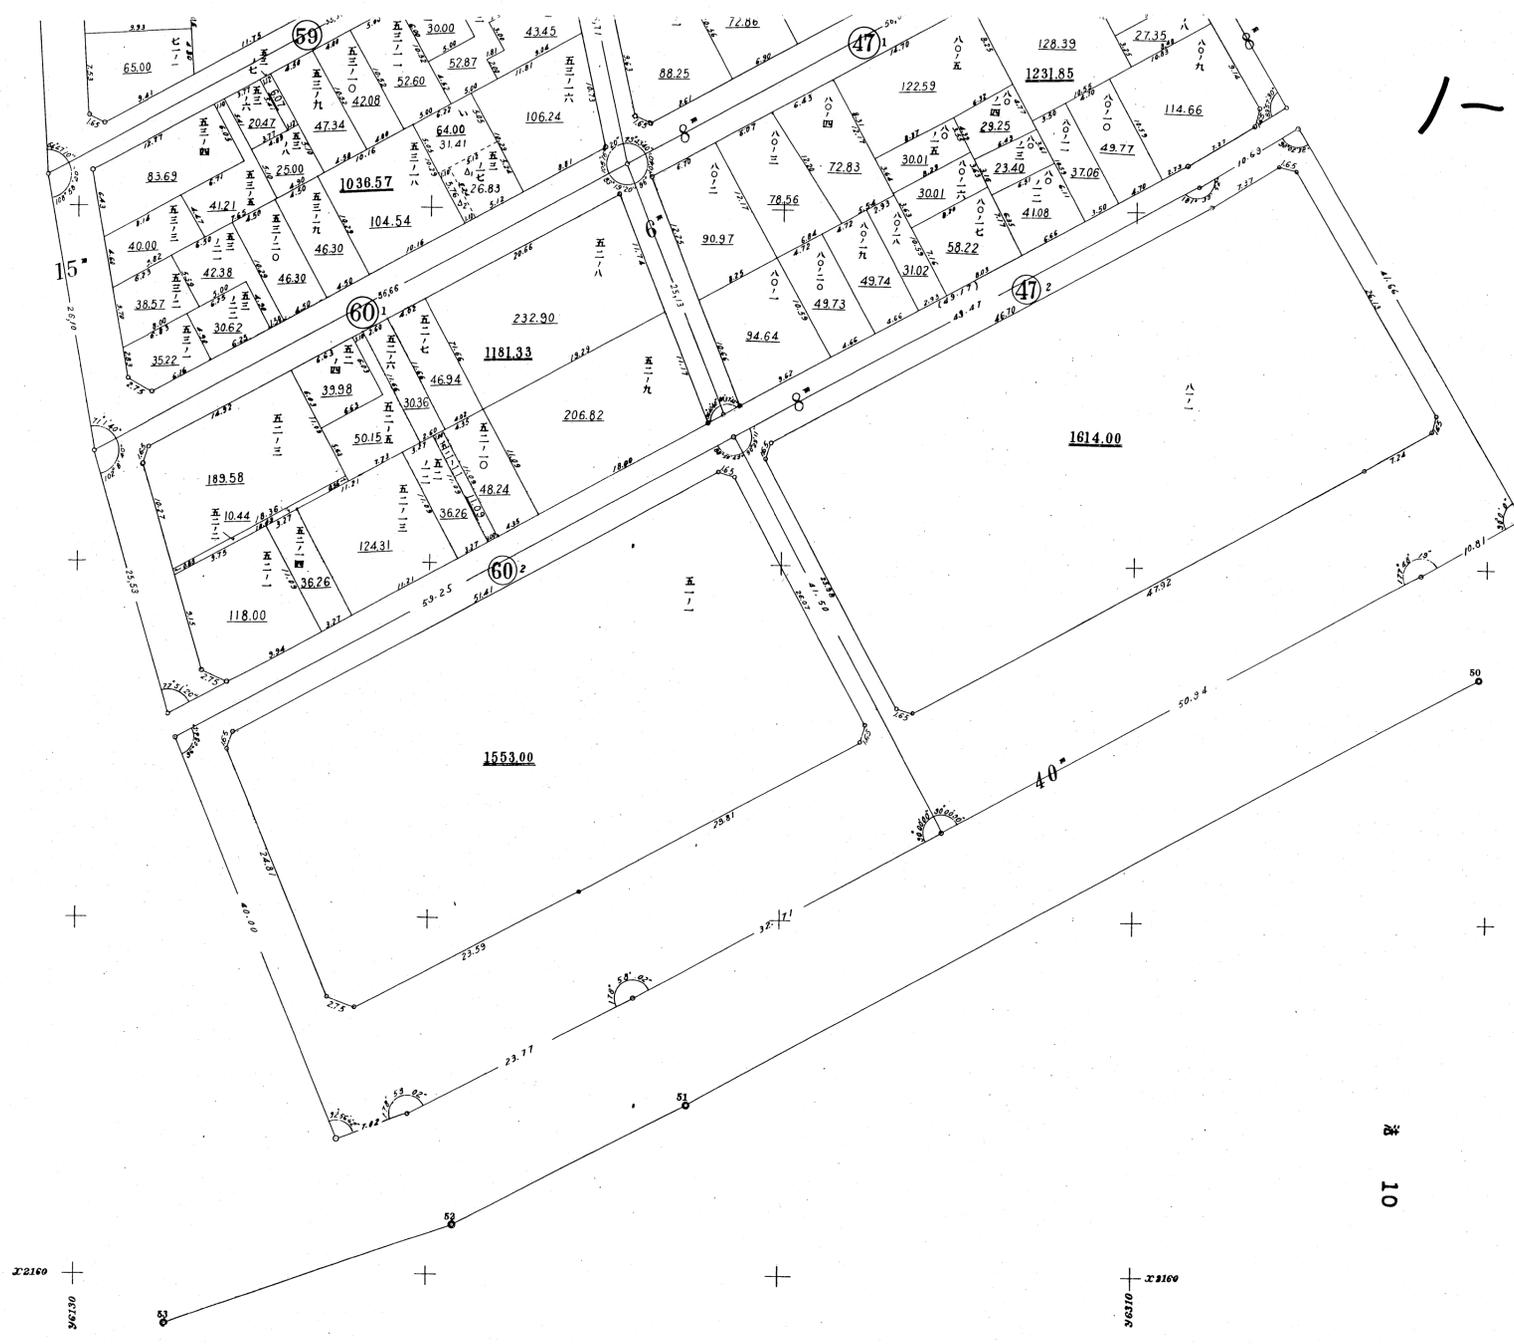


1-9

10

22160
462130


22160
462130

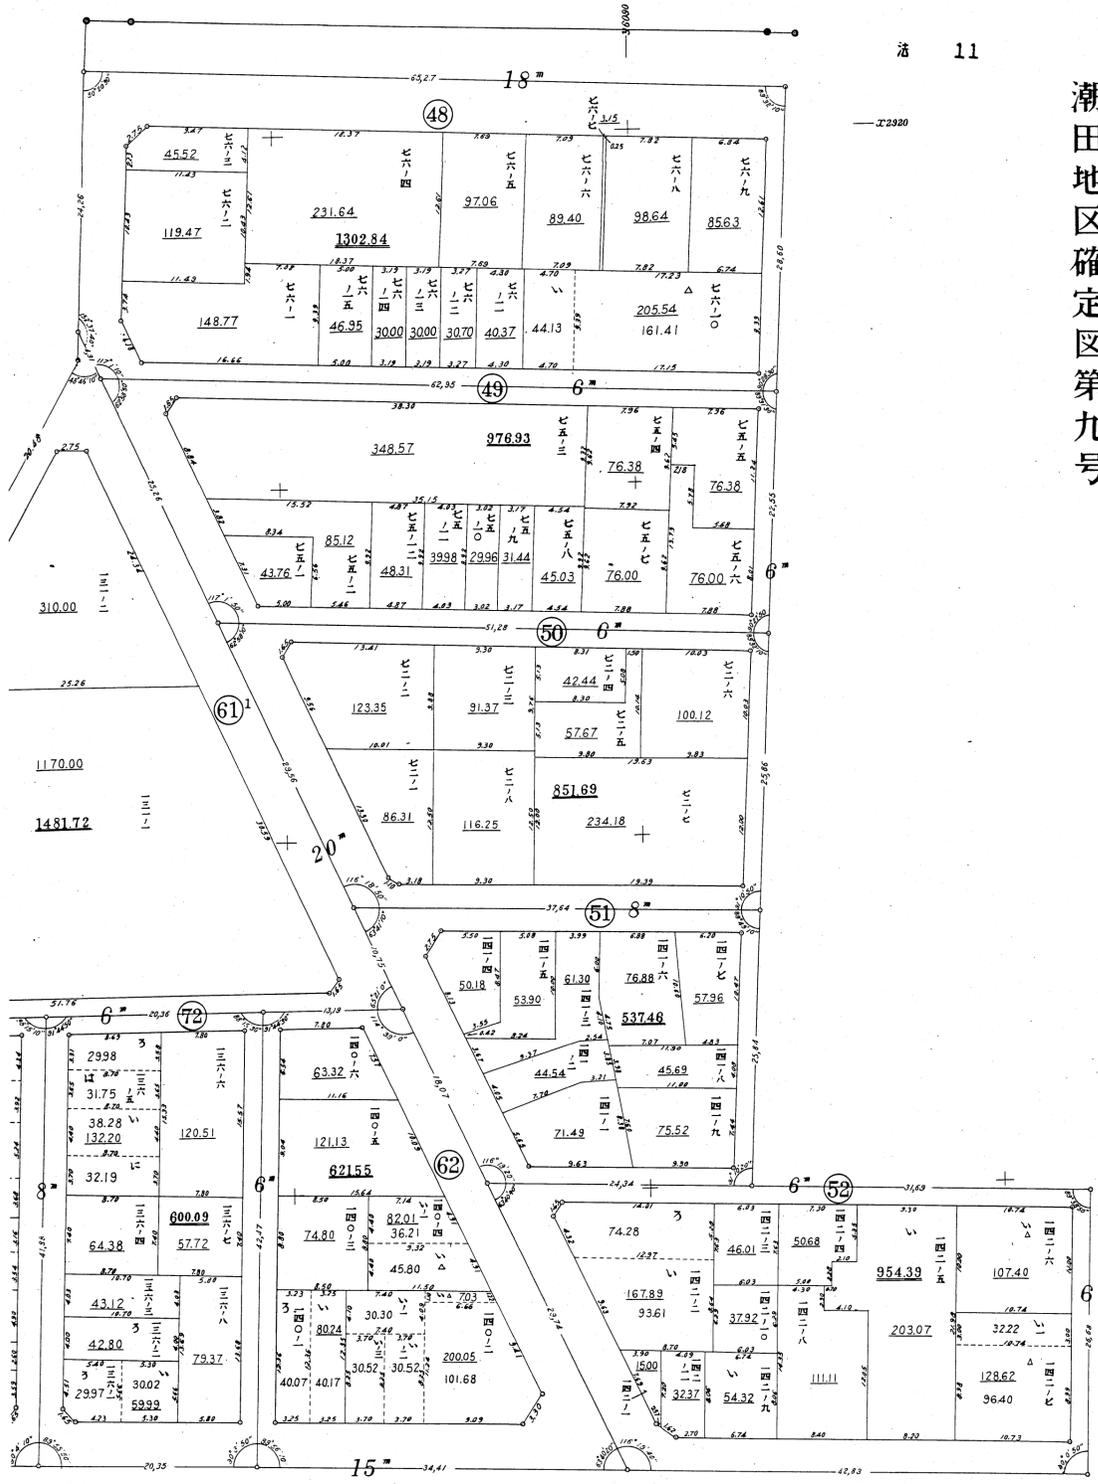

法 11

潮田地区確定図第九号

01-1

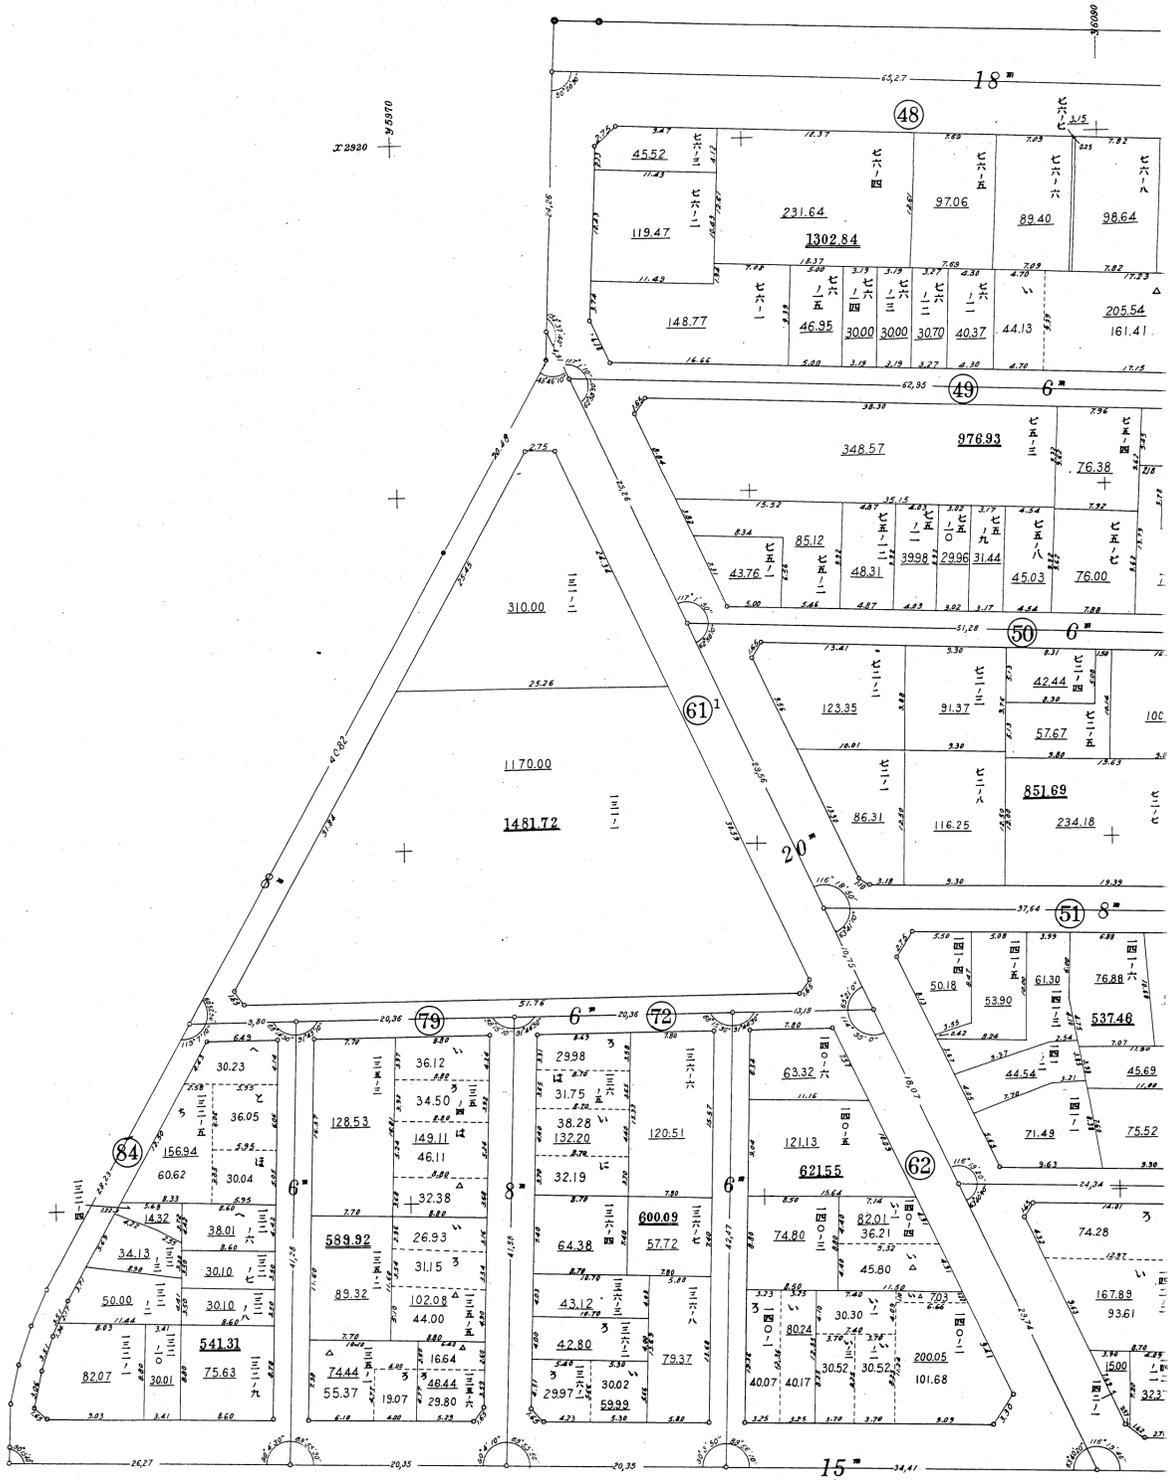

01-1


潮田地区確定図第十号



11-1

1-12

18-12

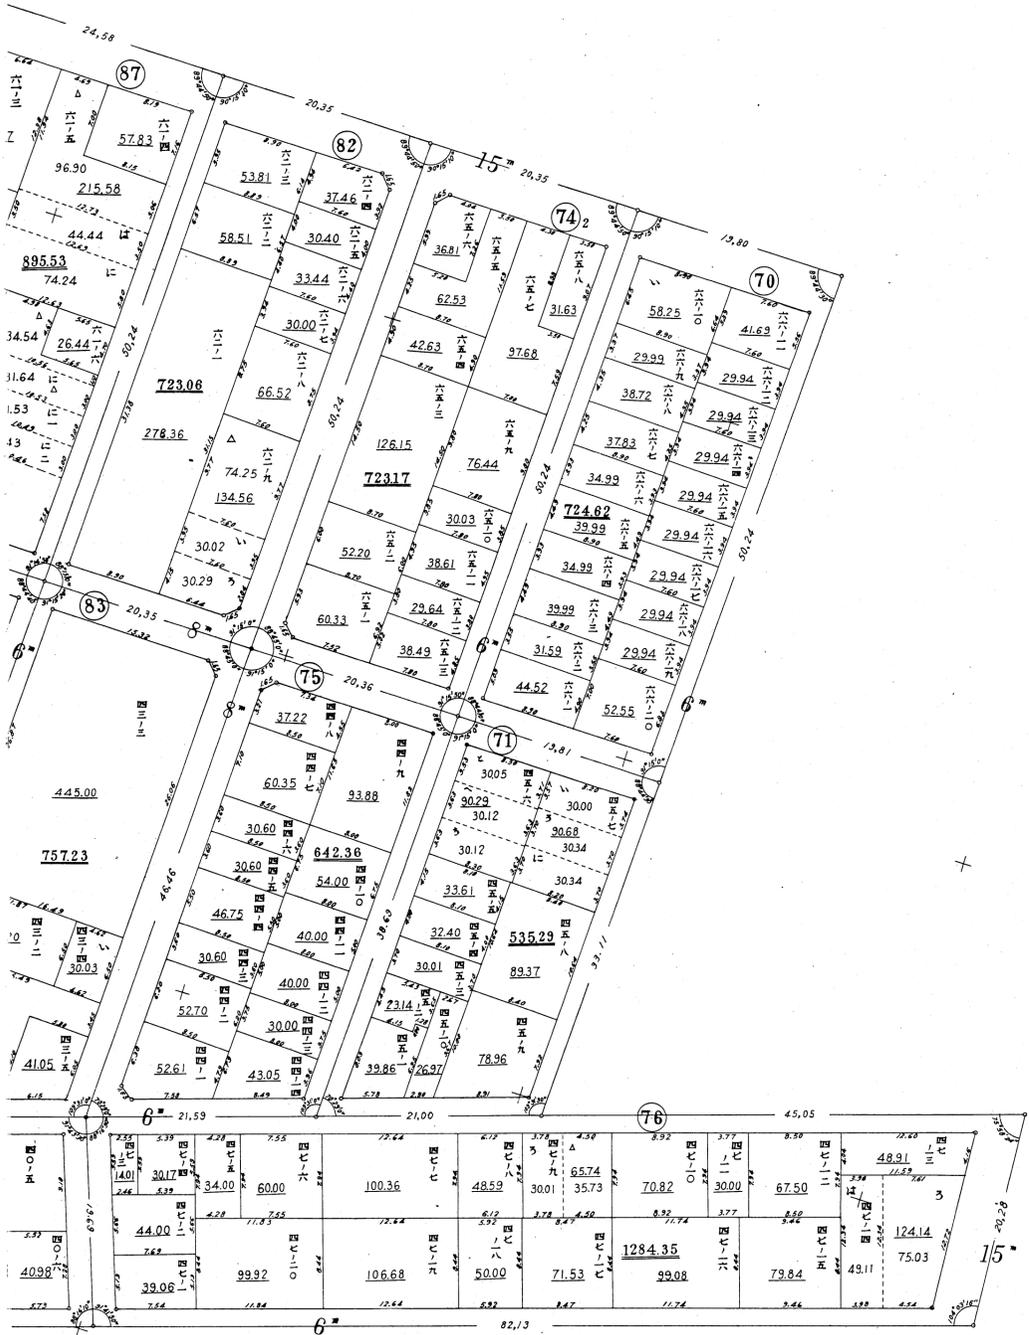

法 13

潮田地区確定図十一号

36500
+ 22480

36500
+ 2360

1-12




22200 +
08582


22480 +
39589

0 82,73


潮田地区確定図第十二号

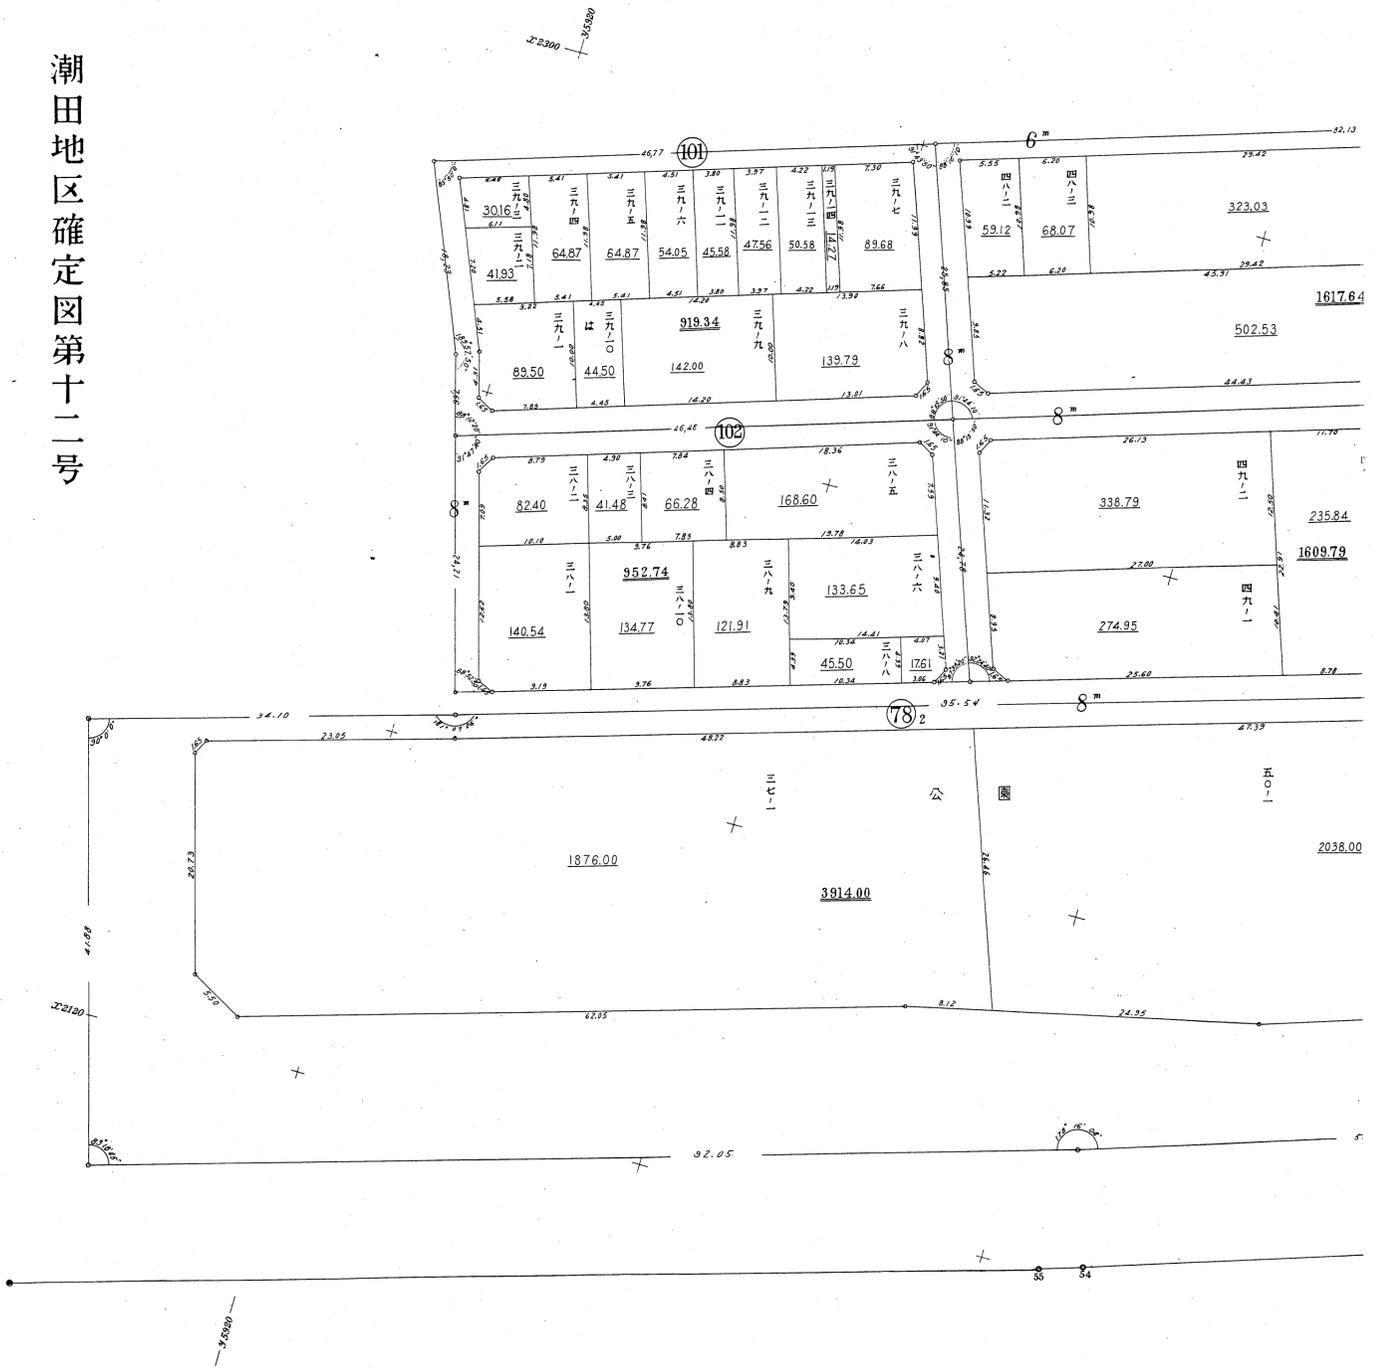

法 14

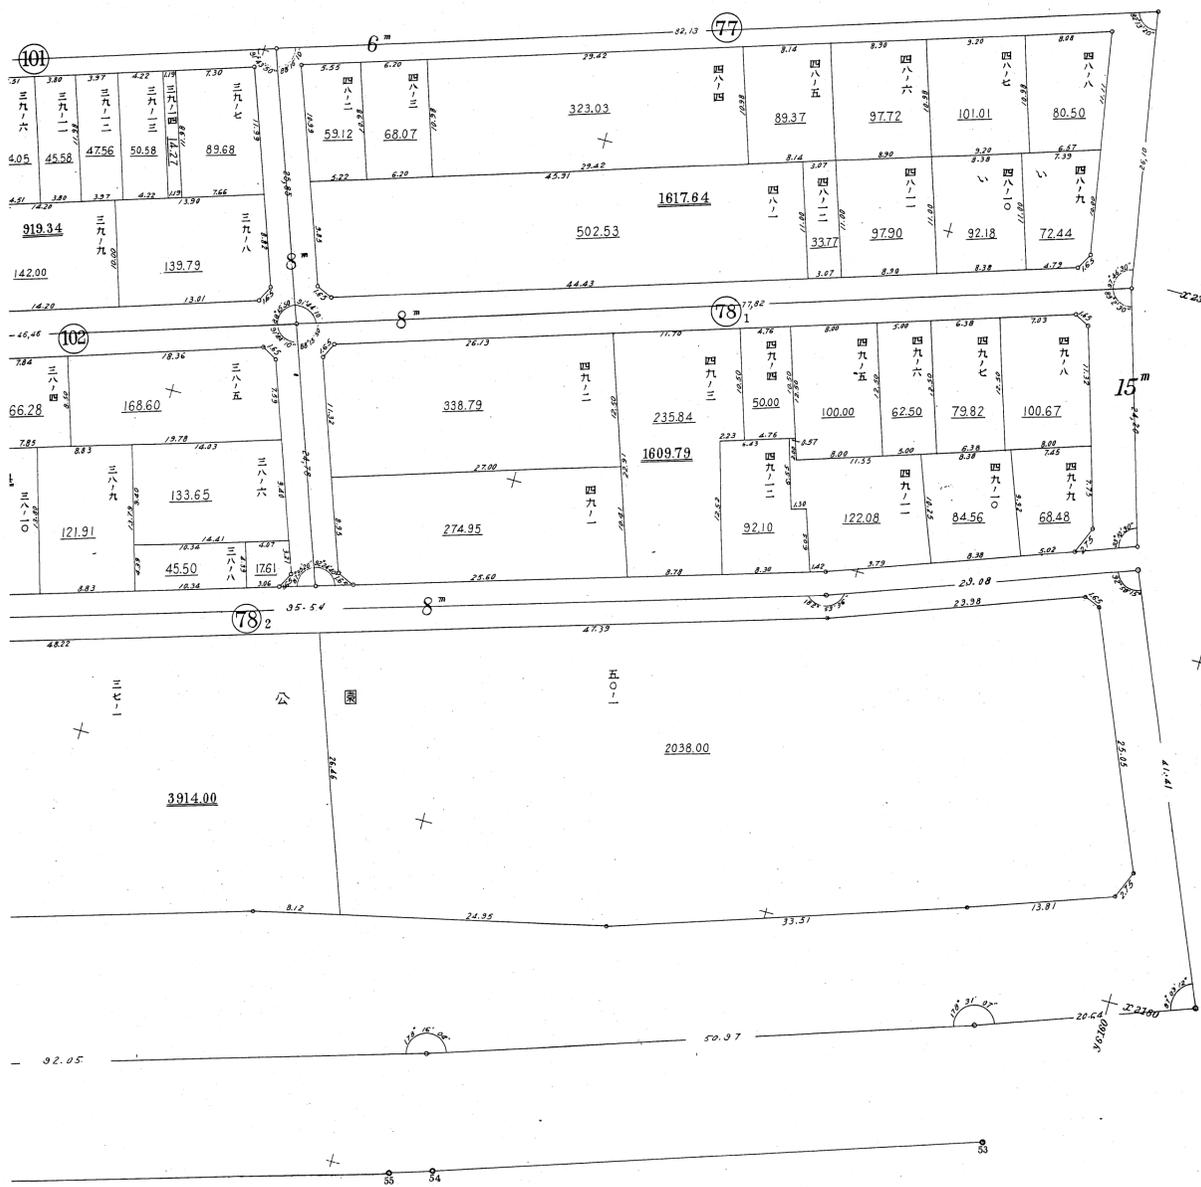


1-13

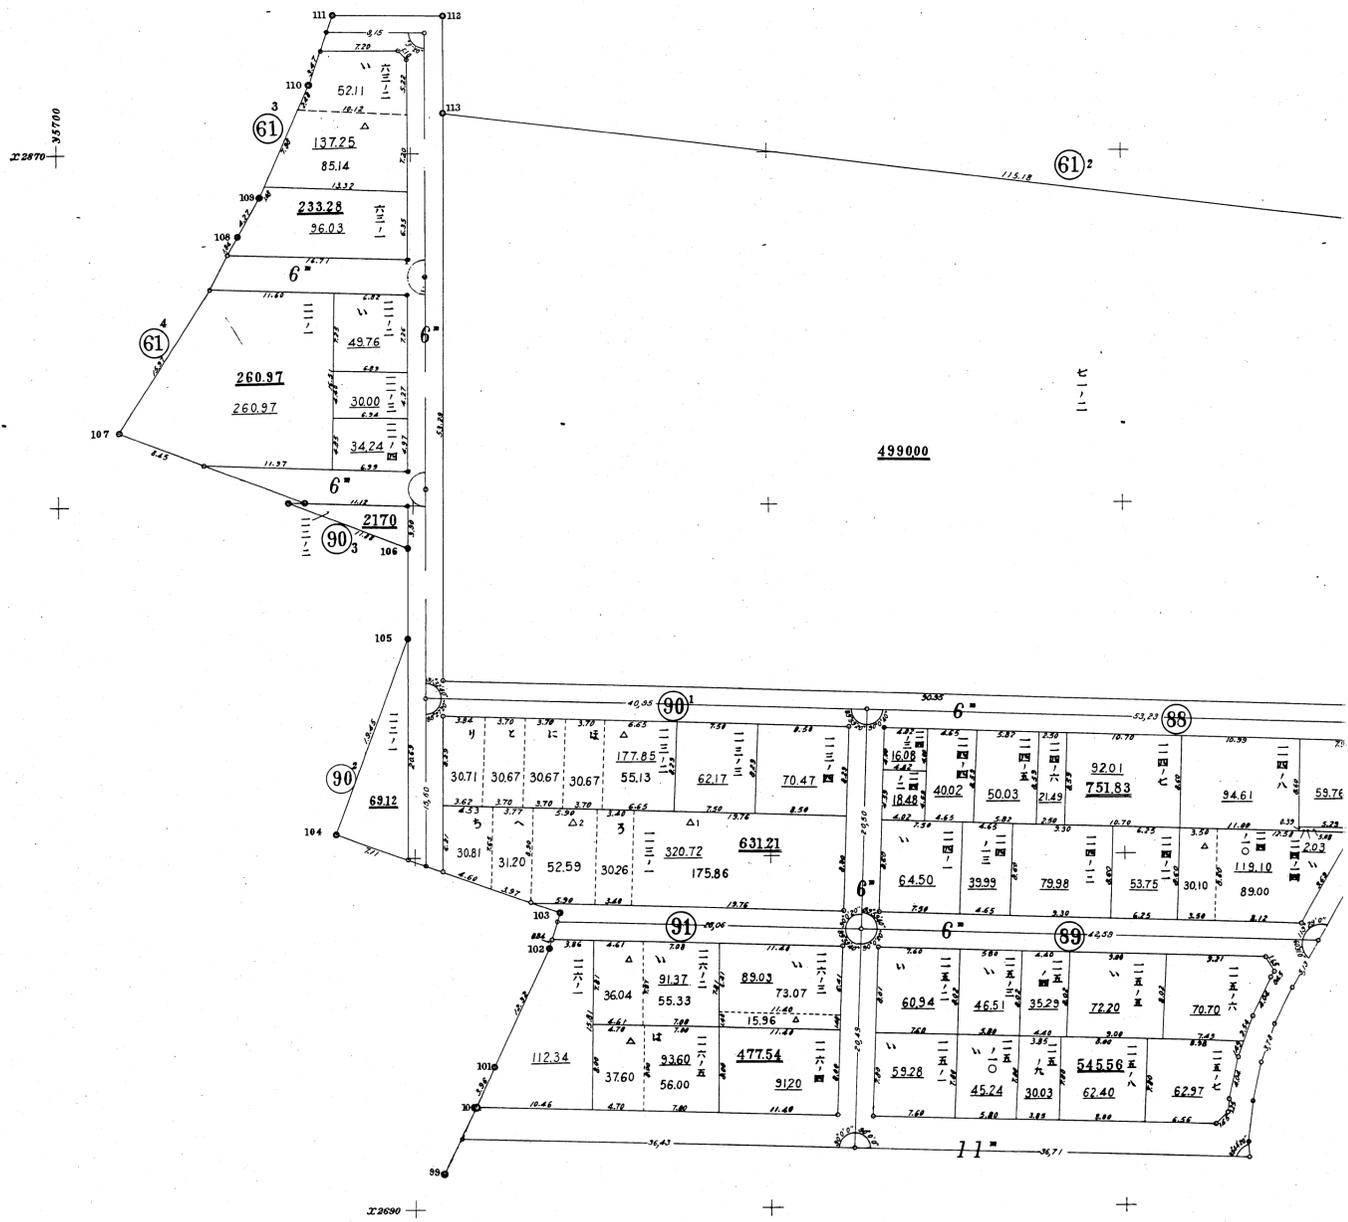

1-14

潮田地区確定図第十四号




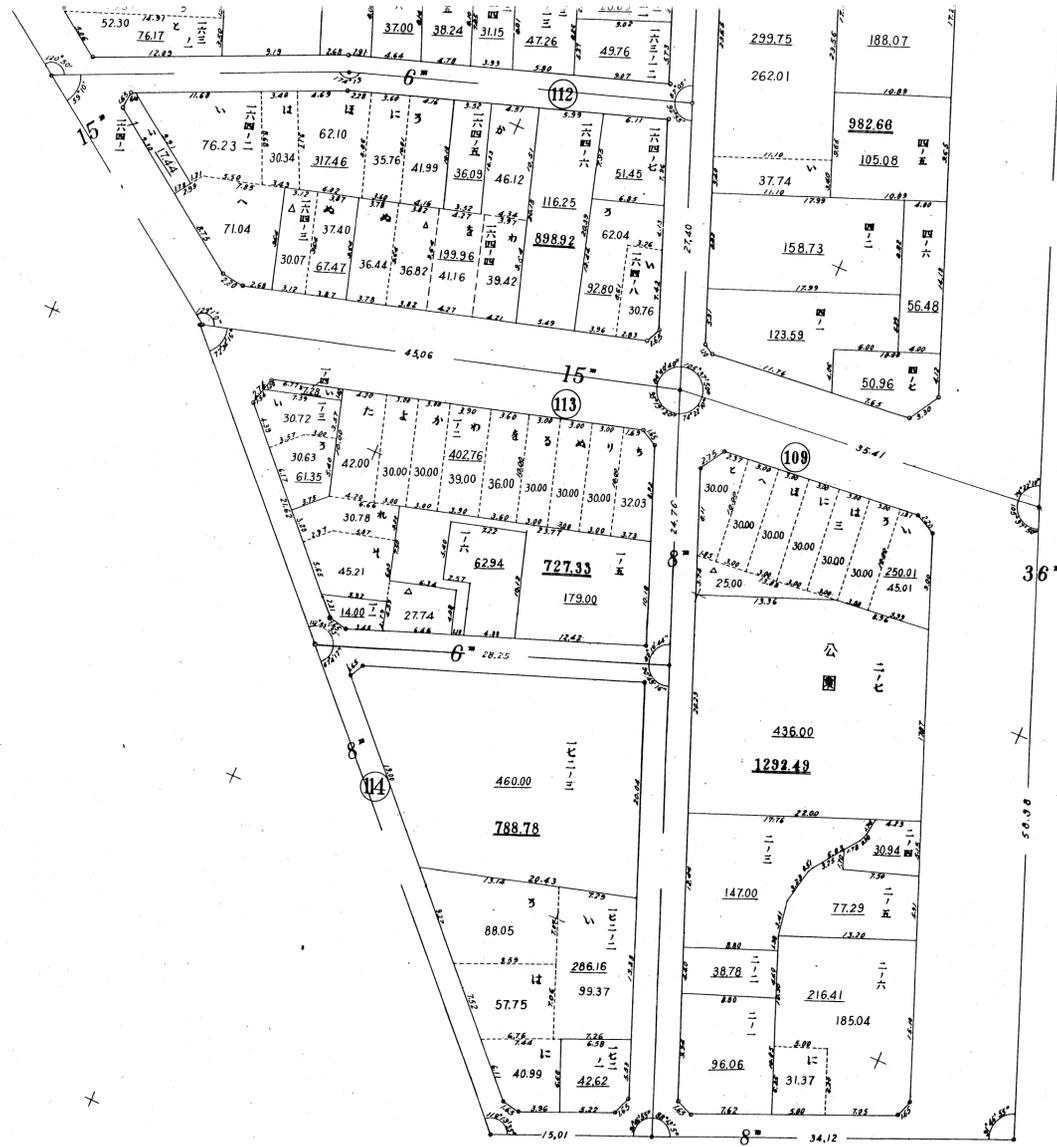

1-16

32340
36538

35760
32340

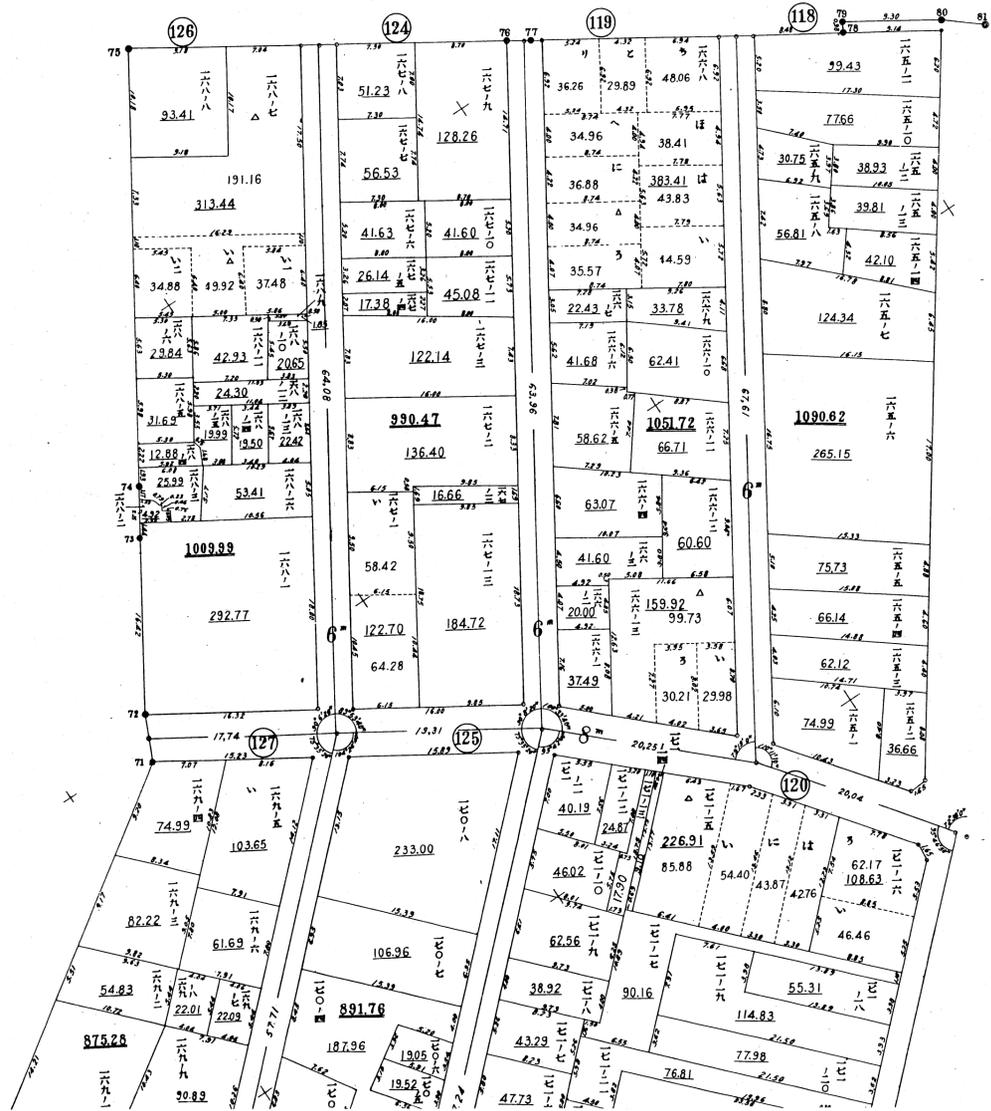

潮田地区確定図十六号

2-2220
35460

2-2220
35460

