



中川第1(その3)

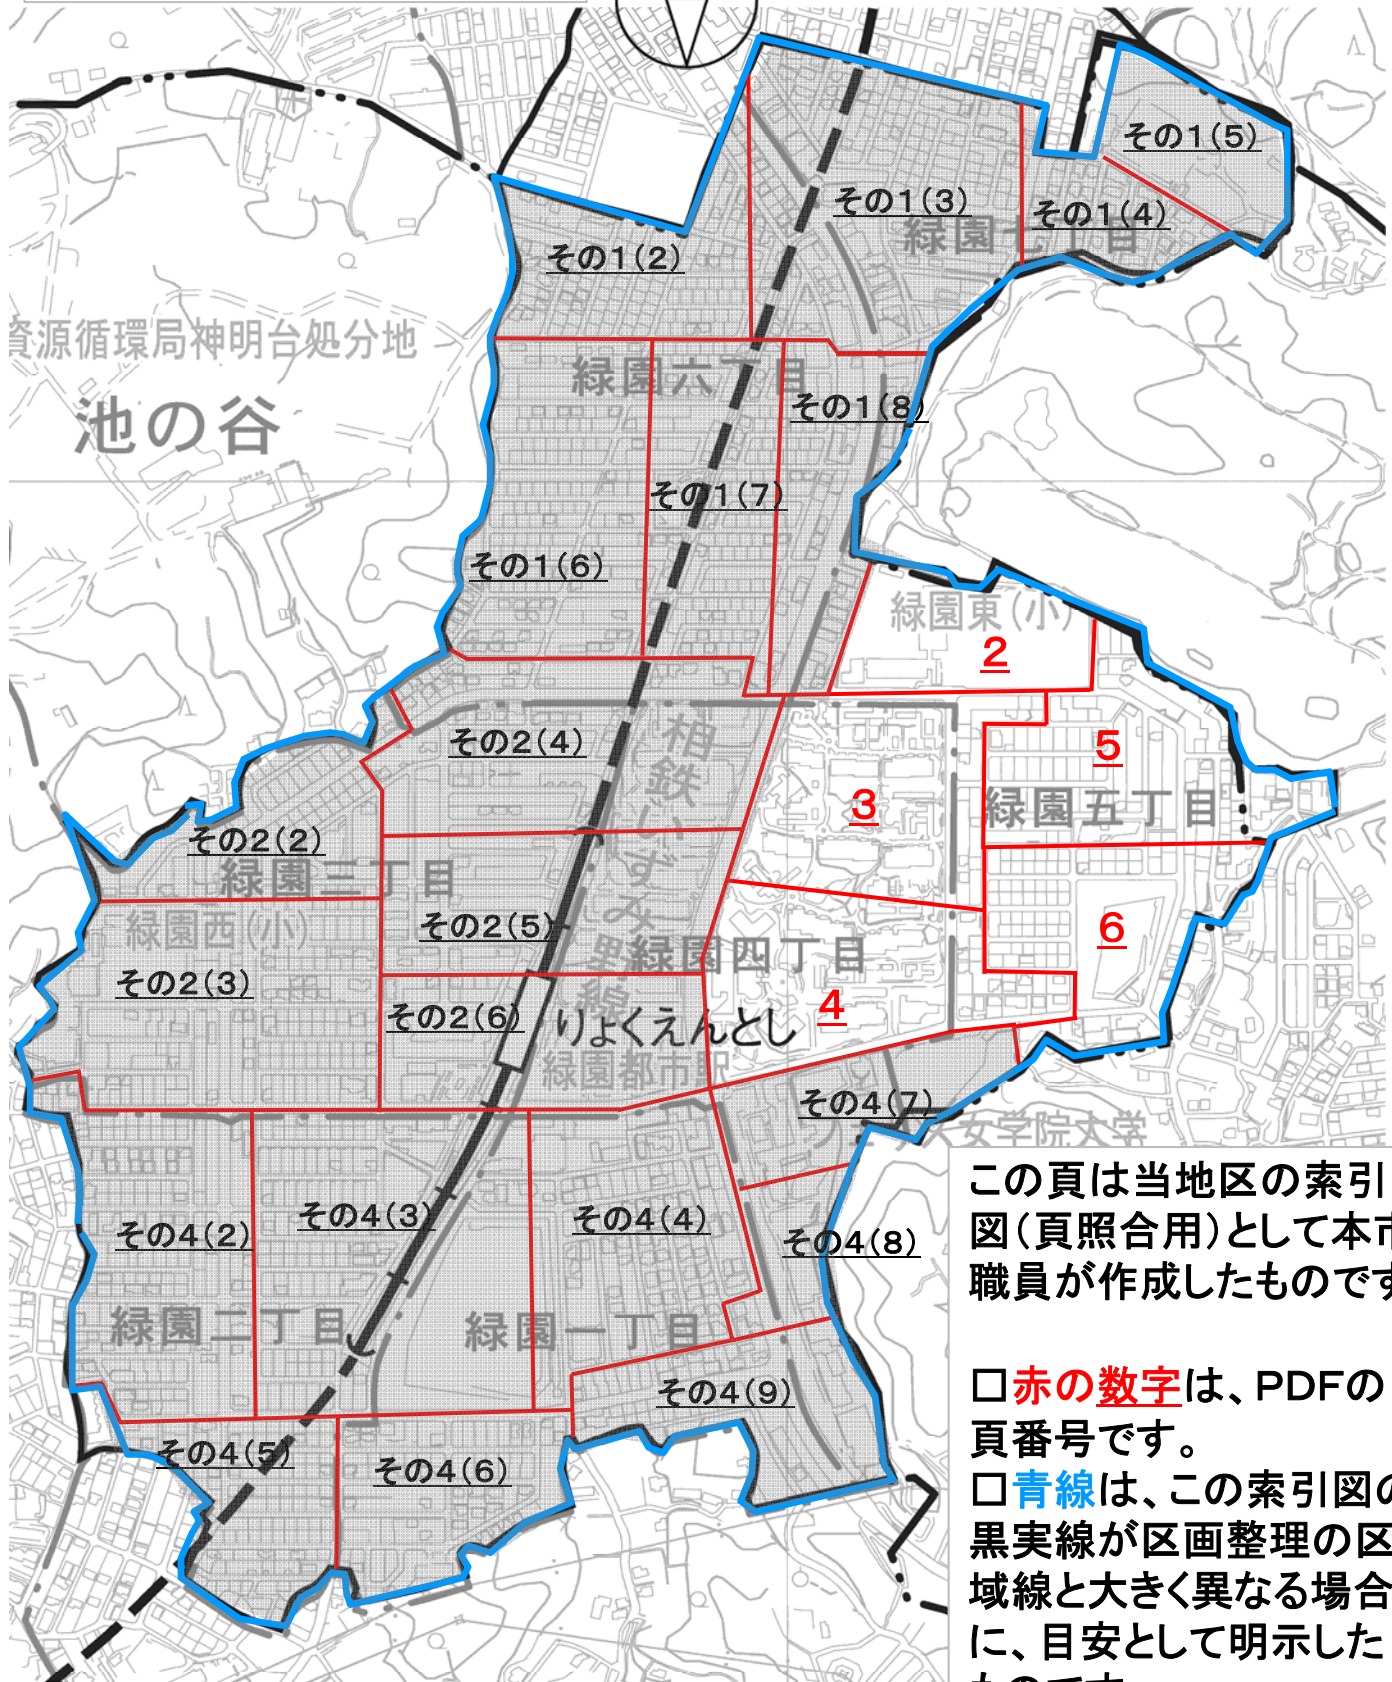

この頁は当地区の索引図(頁照合用)として本市職員が作成したものです。

- 赤の数字は、PDFの頁番号です。
- 青線は、この索引図の黒実線が区画整理の区域線と大きく異なる場合に、目安として明示したものです。

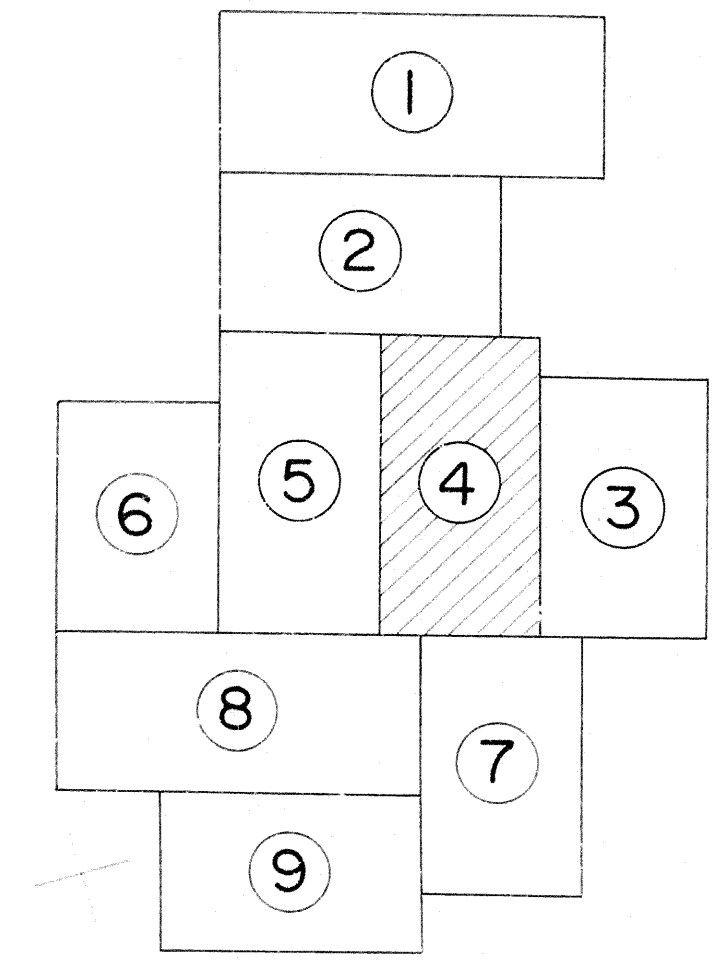

X-62100

X-62200

丁目



緑園四丁目

緑園五丁目

X=62400

X=62300

X=62200

100

90

80

70

60

50

40

30

20

10

0

10

20

30

40

50

60

70

80

90

100

110

120

130

140

150

160

170

180

190

200

210

緑園 四丁目



X=62400


X=62500

Y=27500

Y=27600

Y=27700




Y=27800

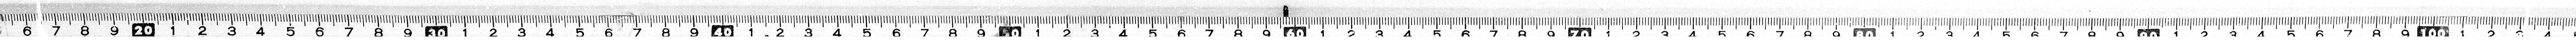

X=62000
























X=62100

X=62200

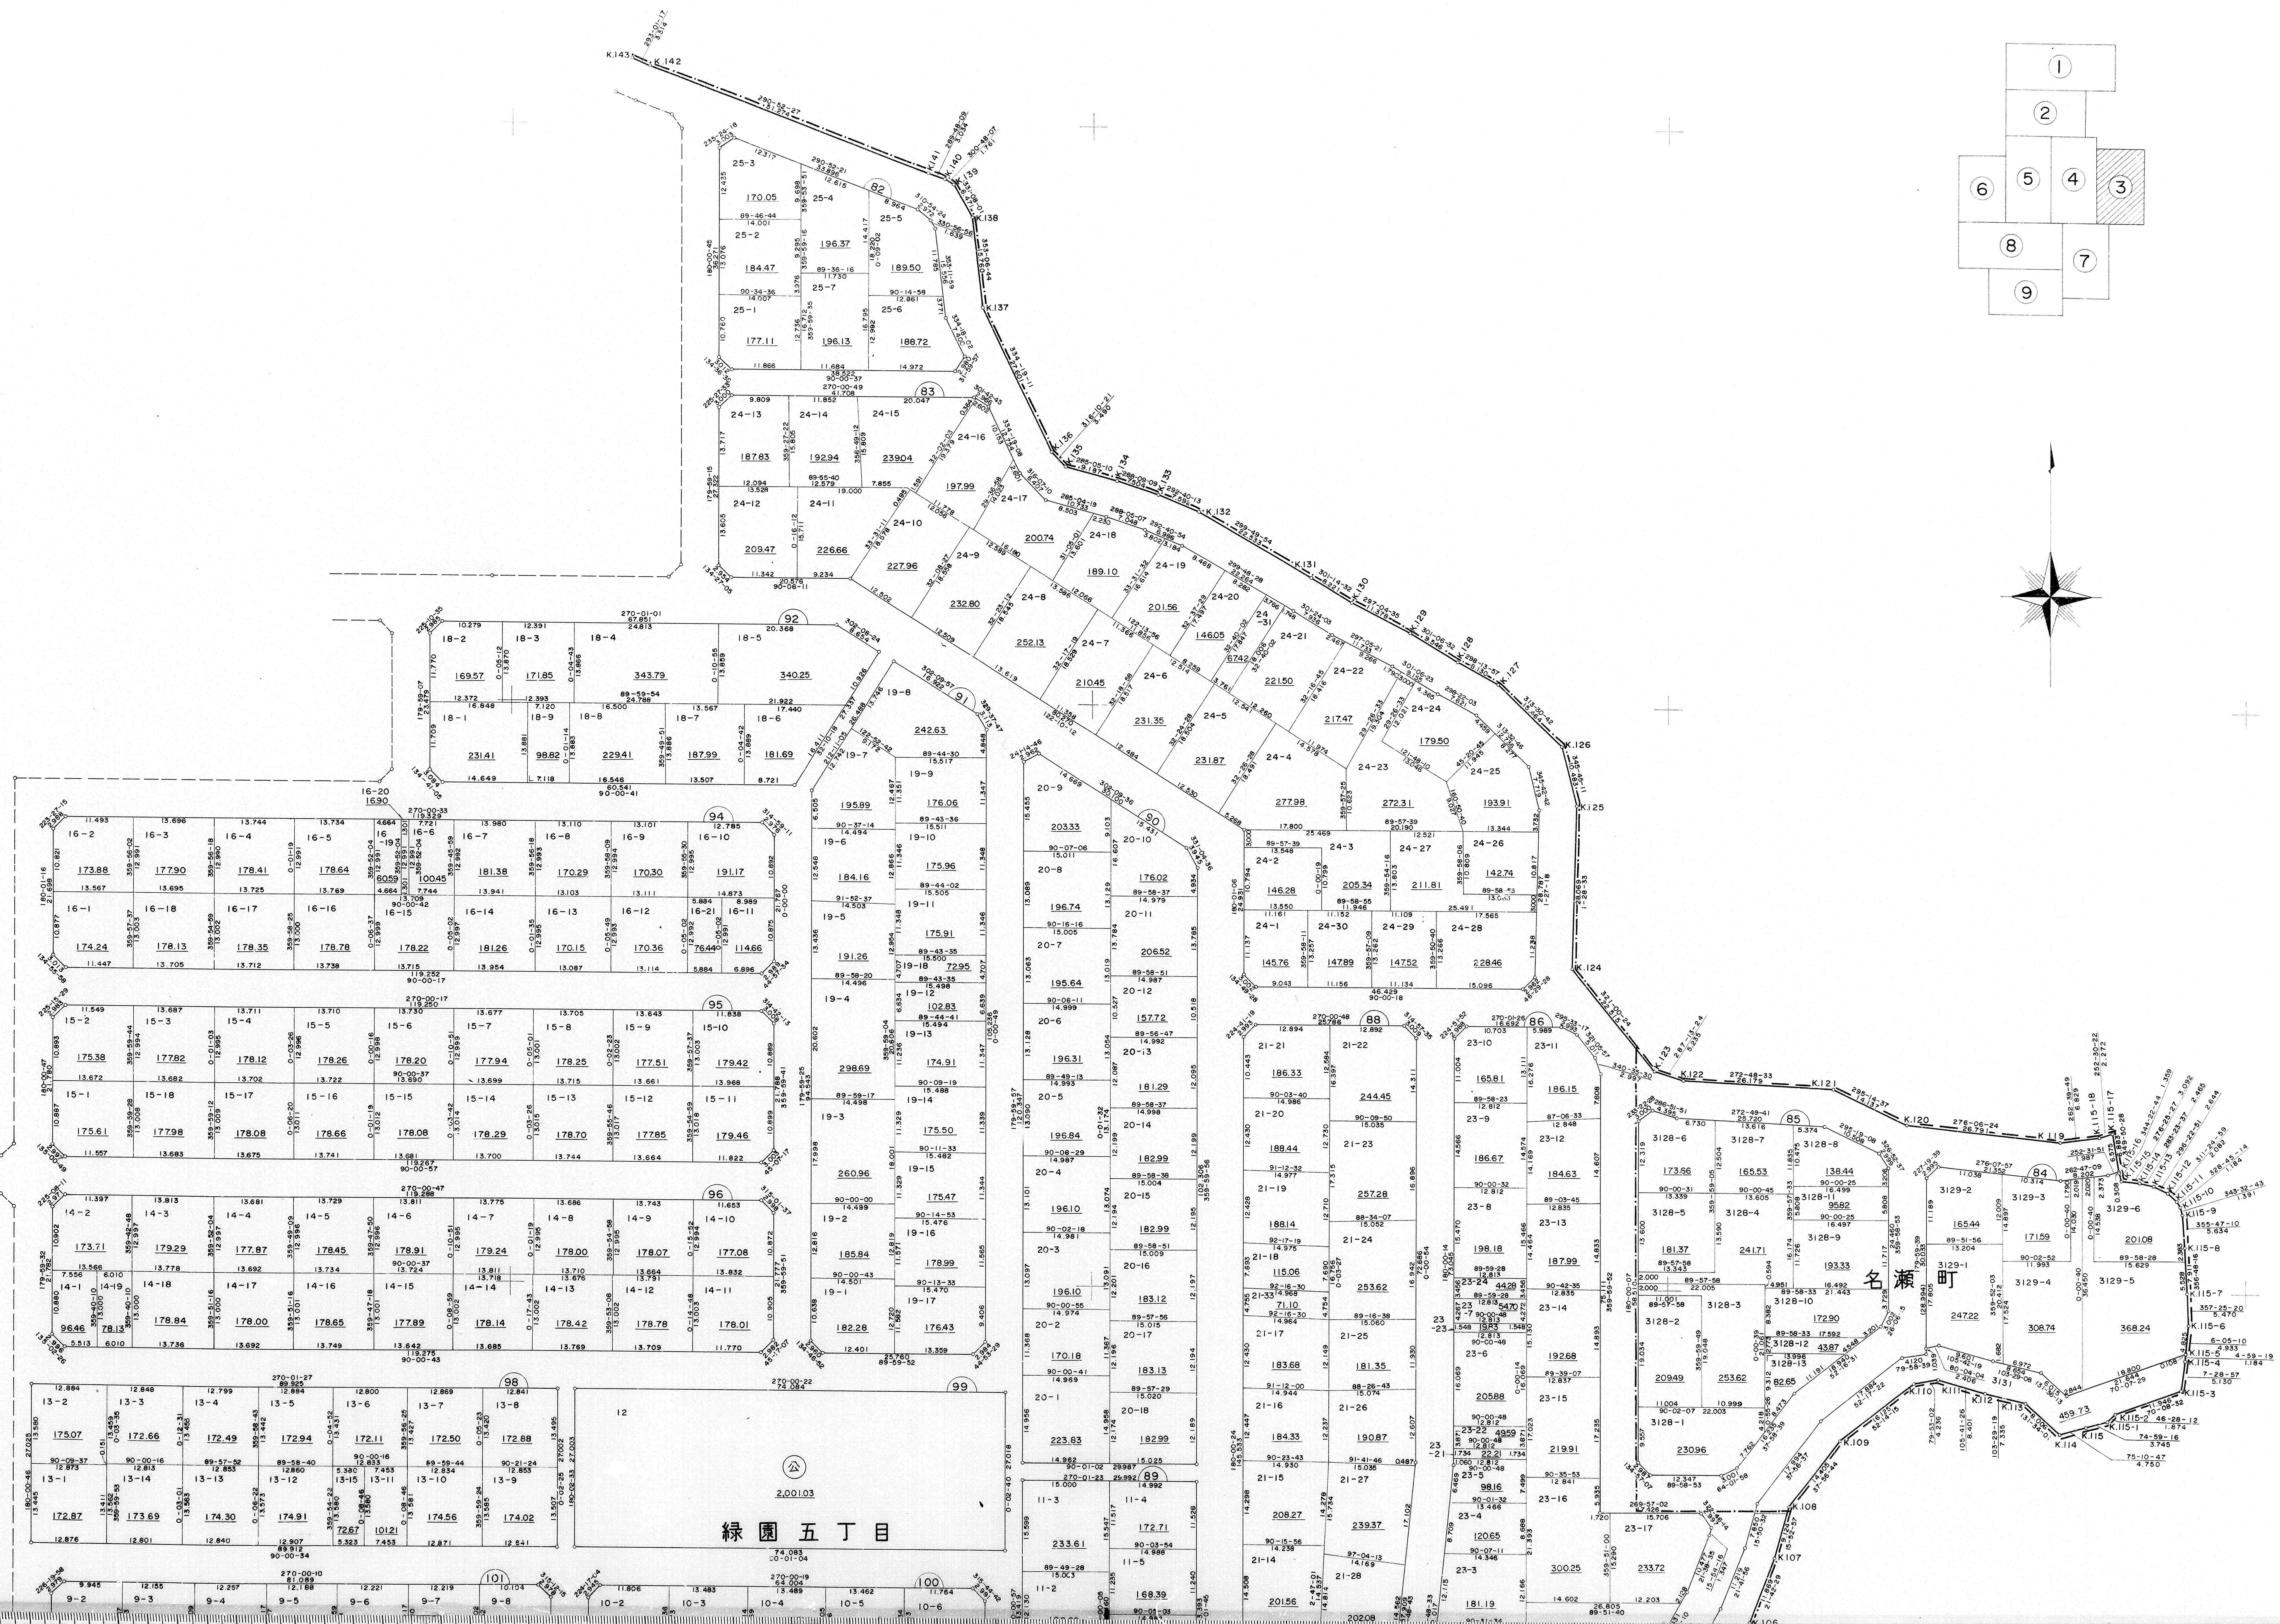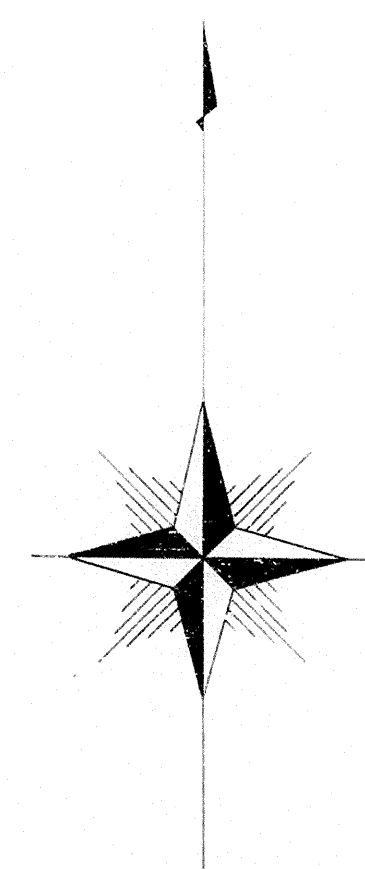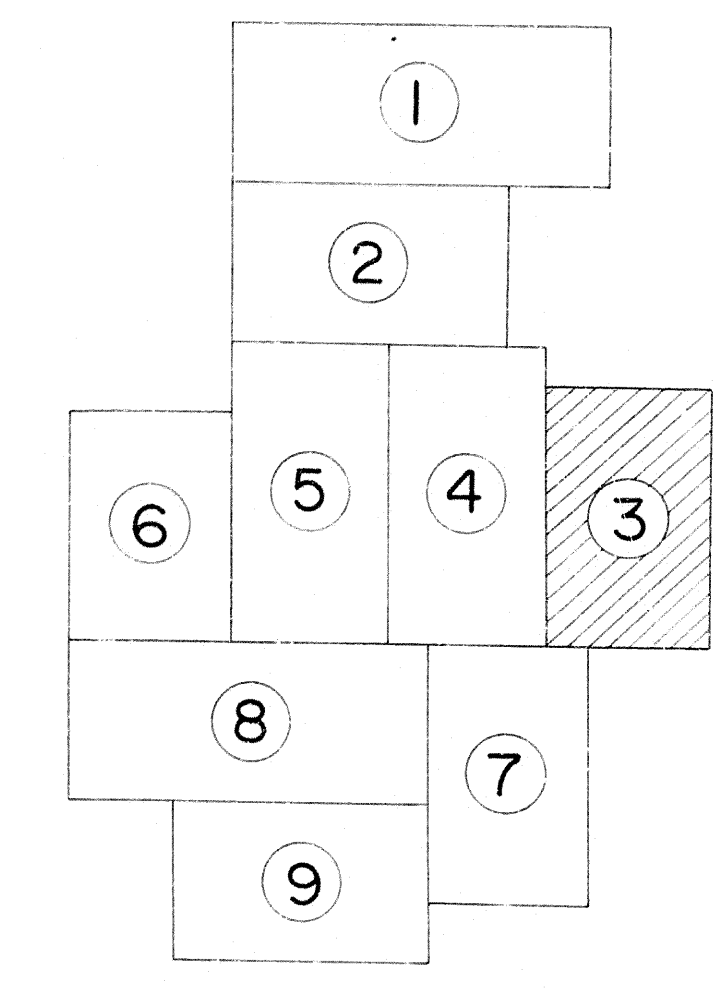

緑園五丁目

名瀬町

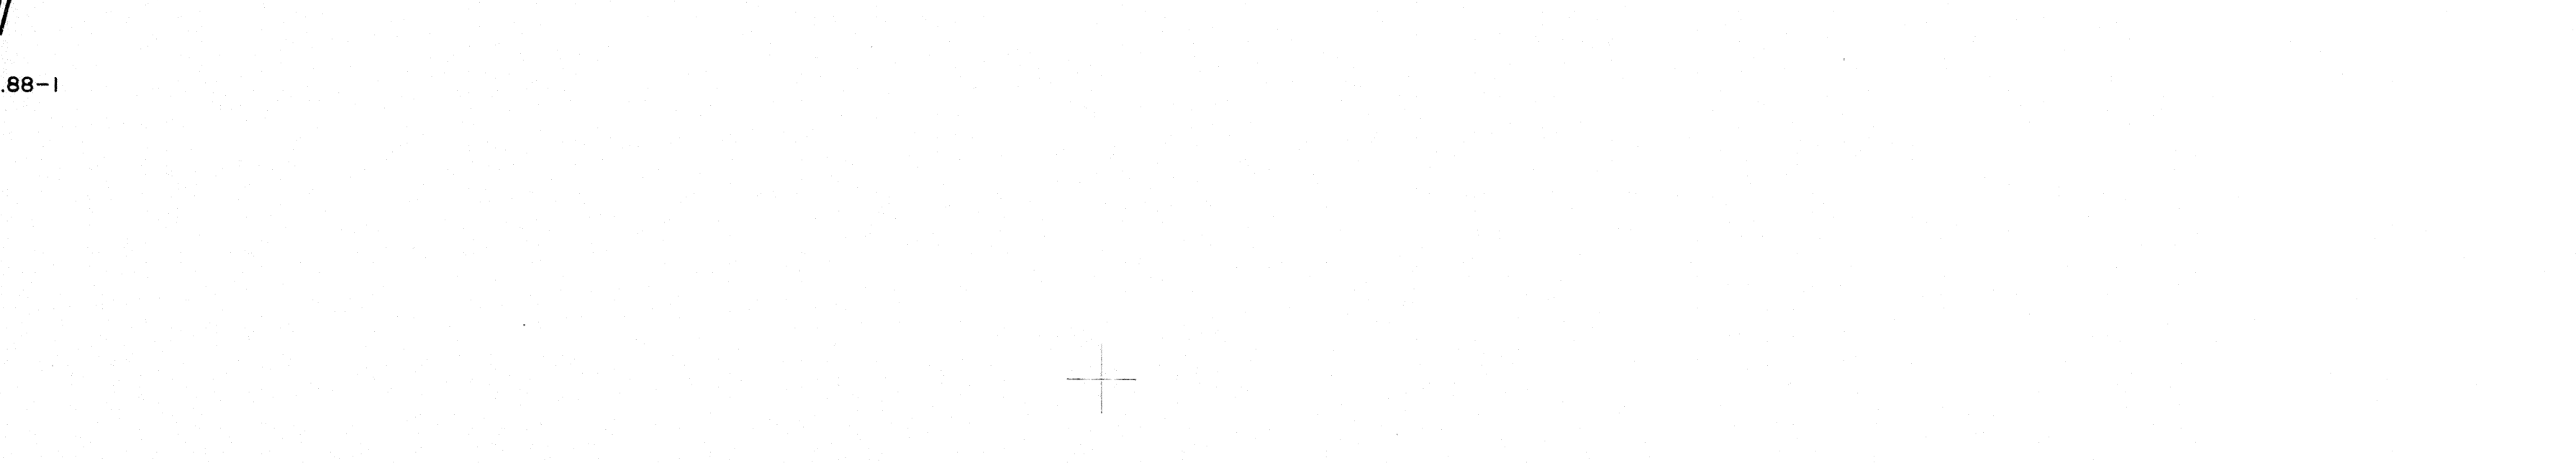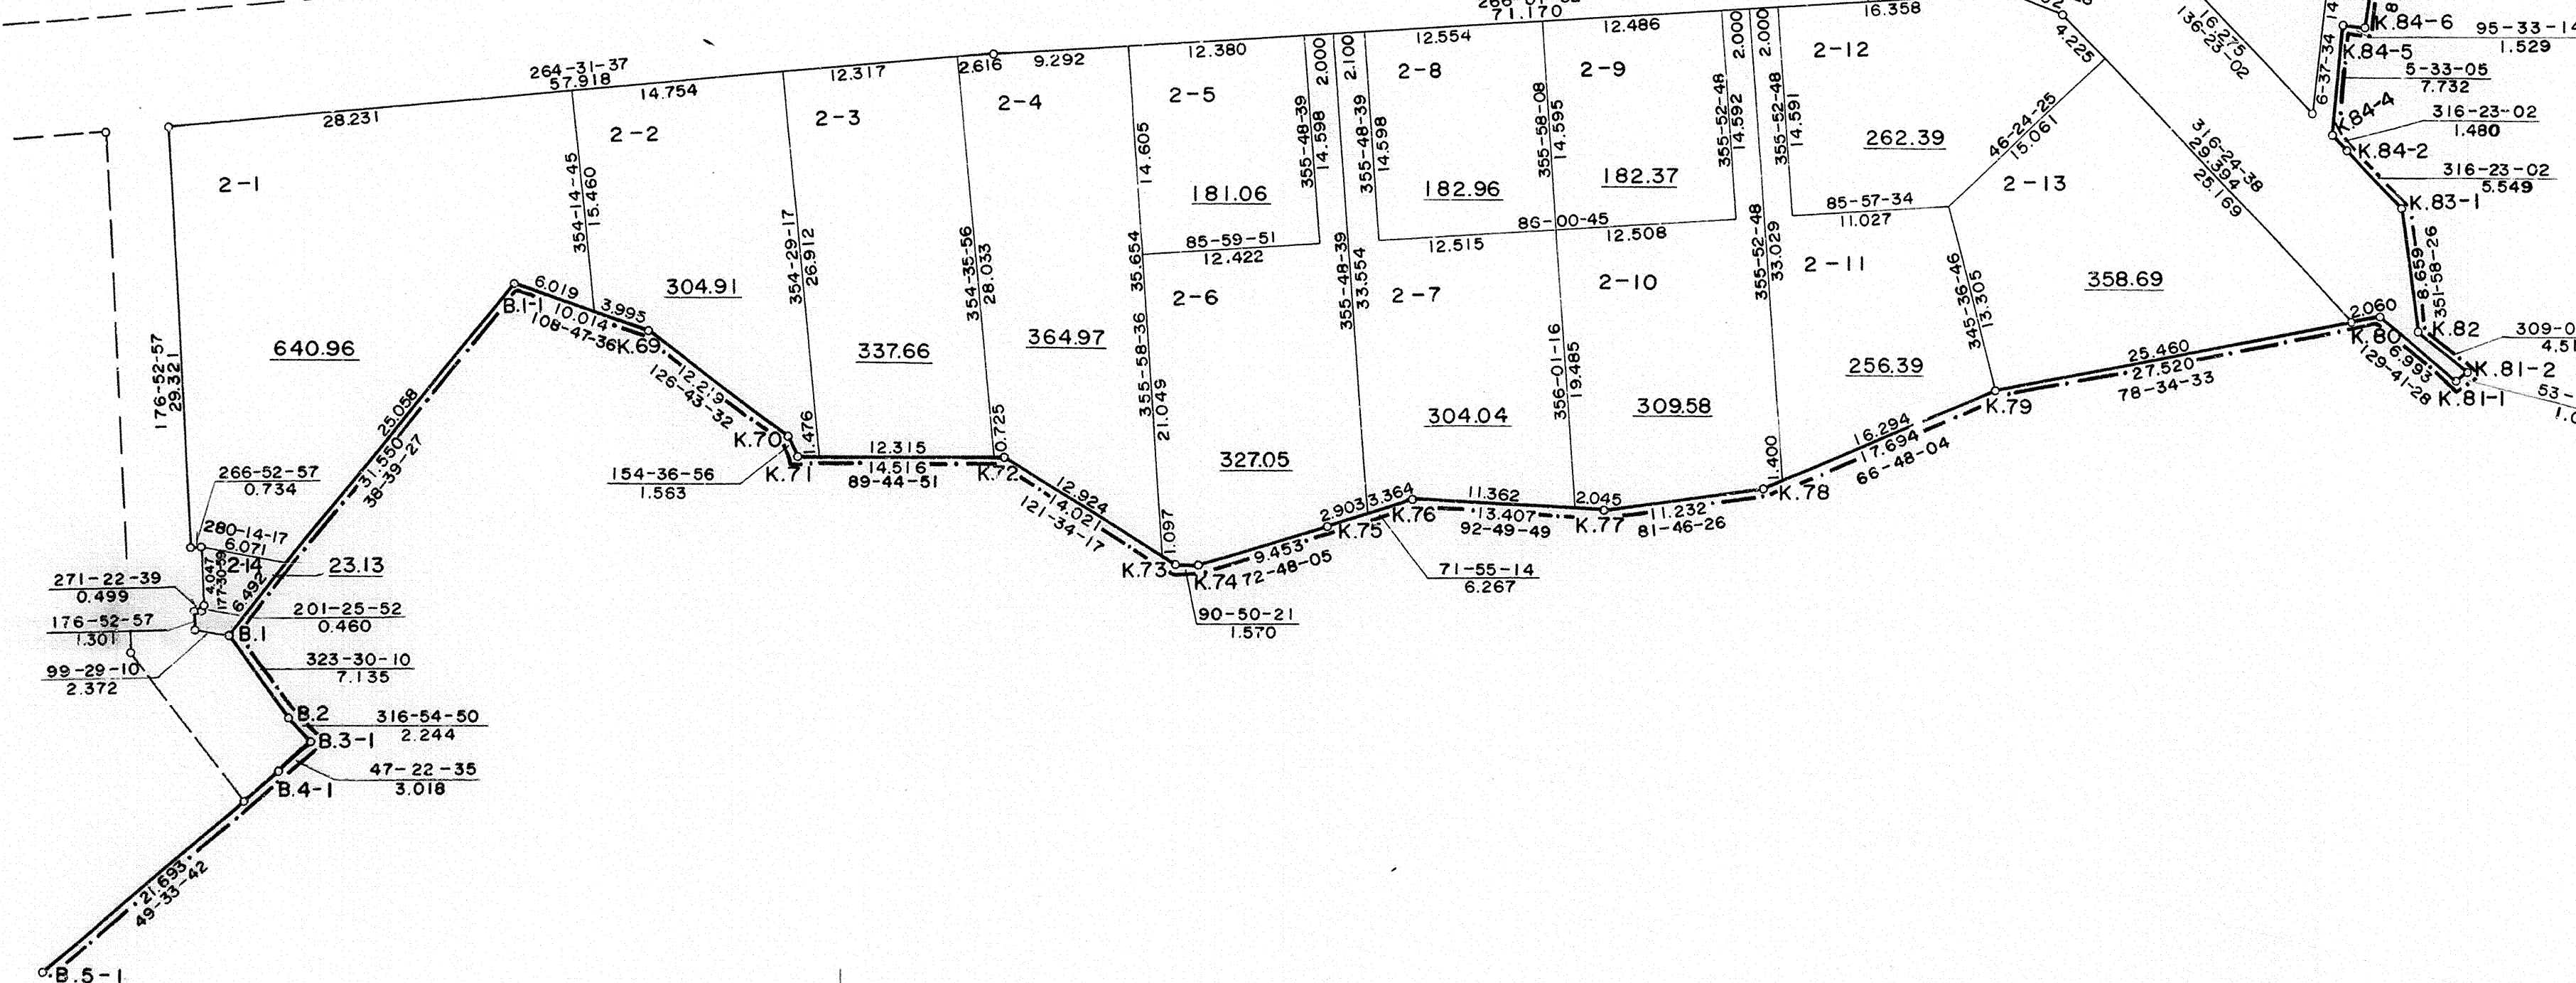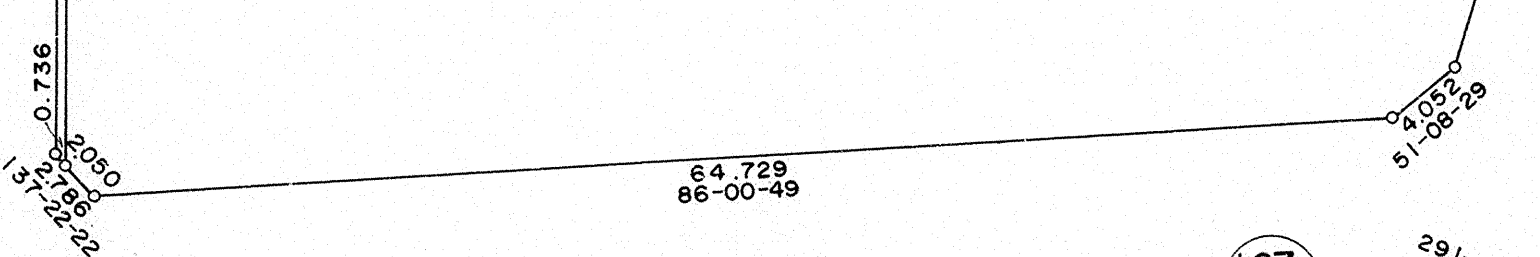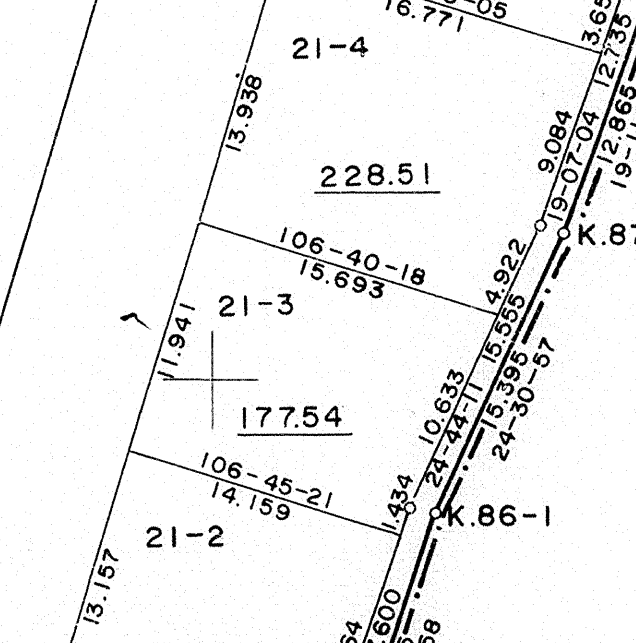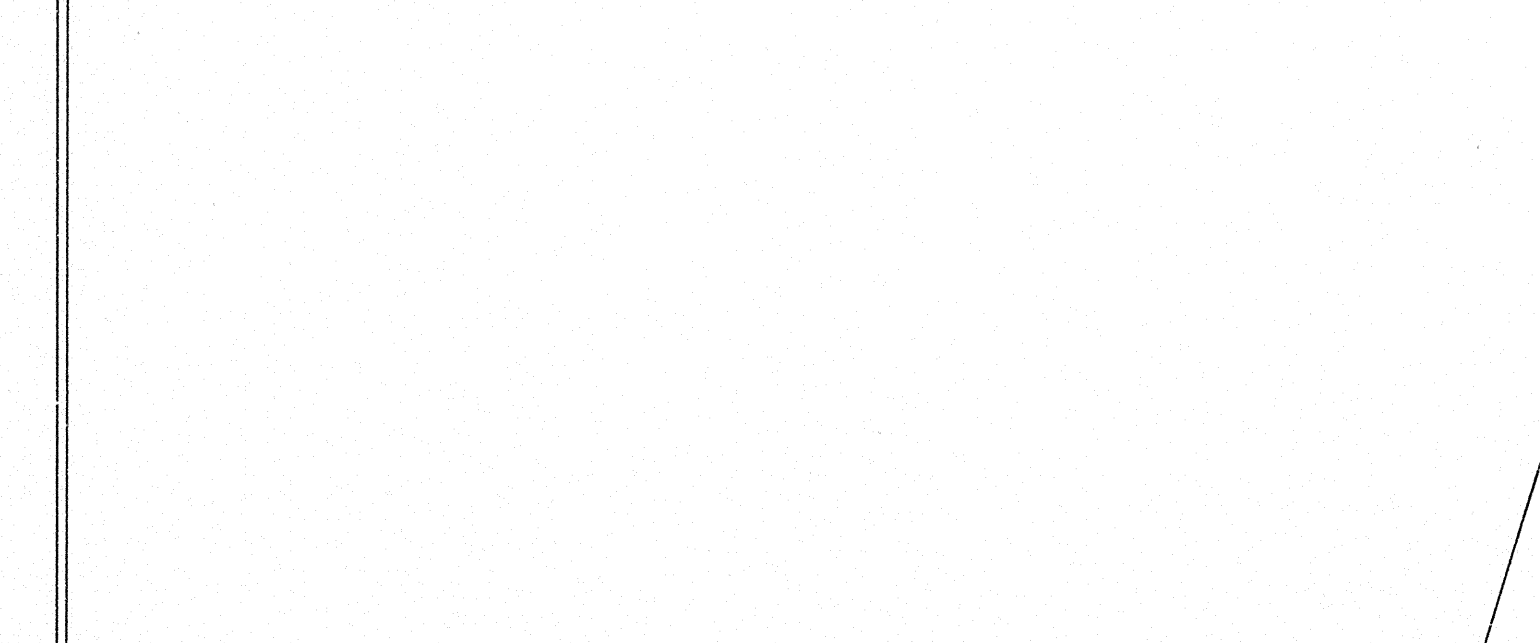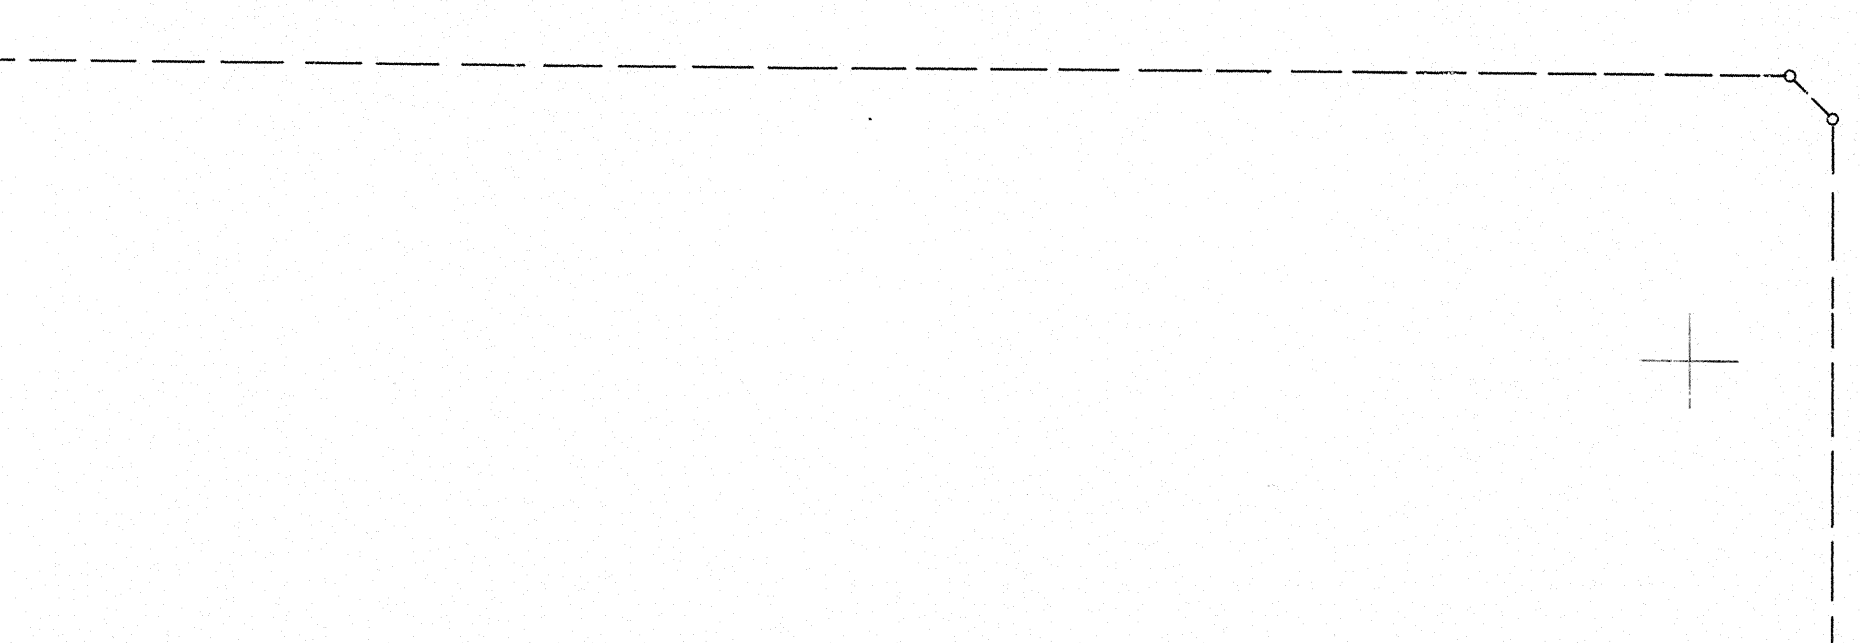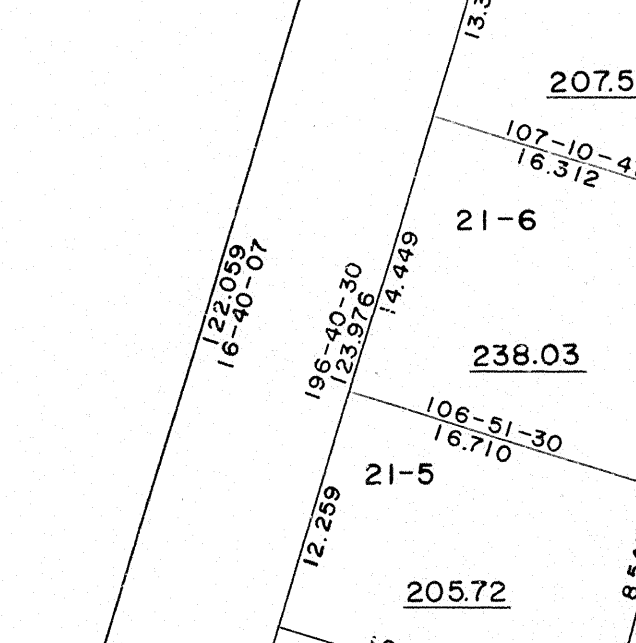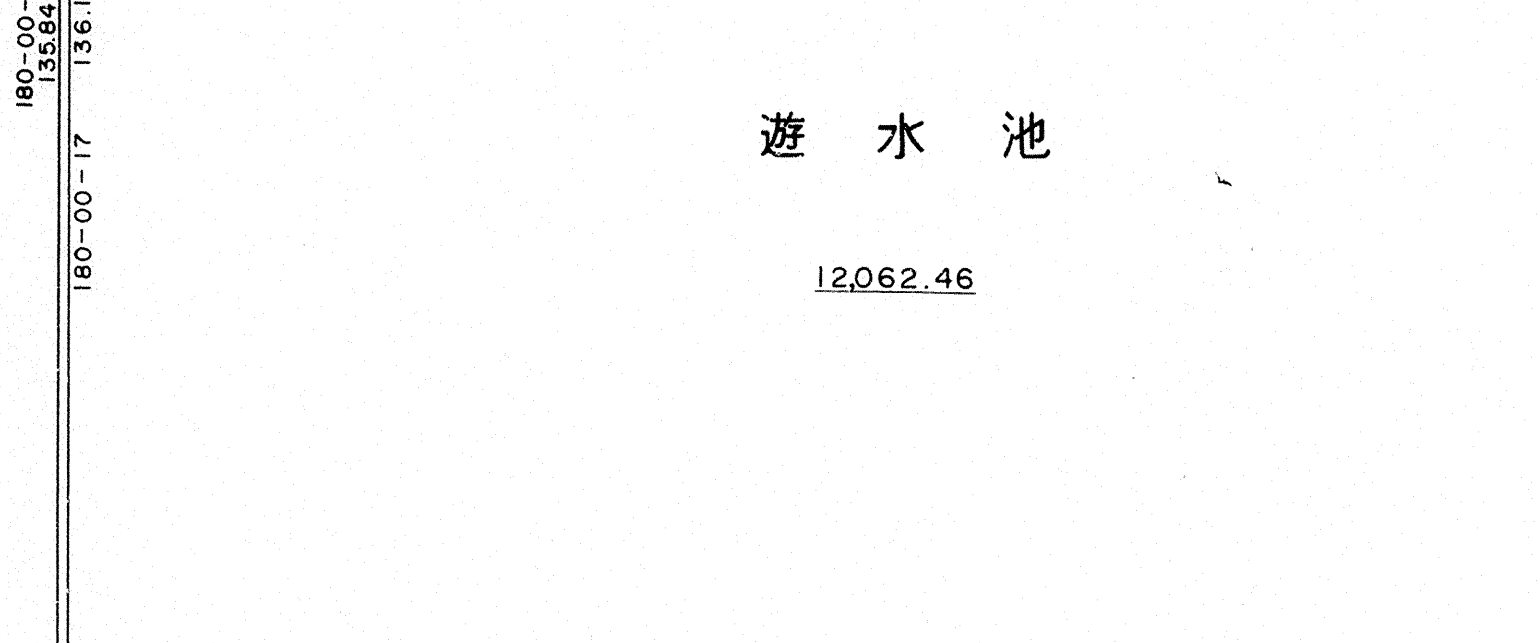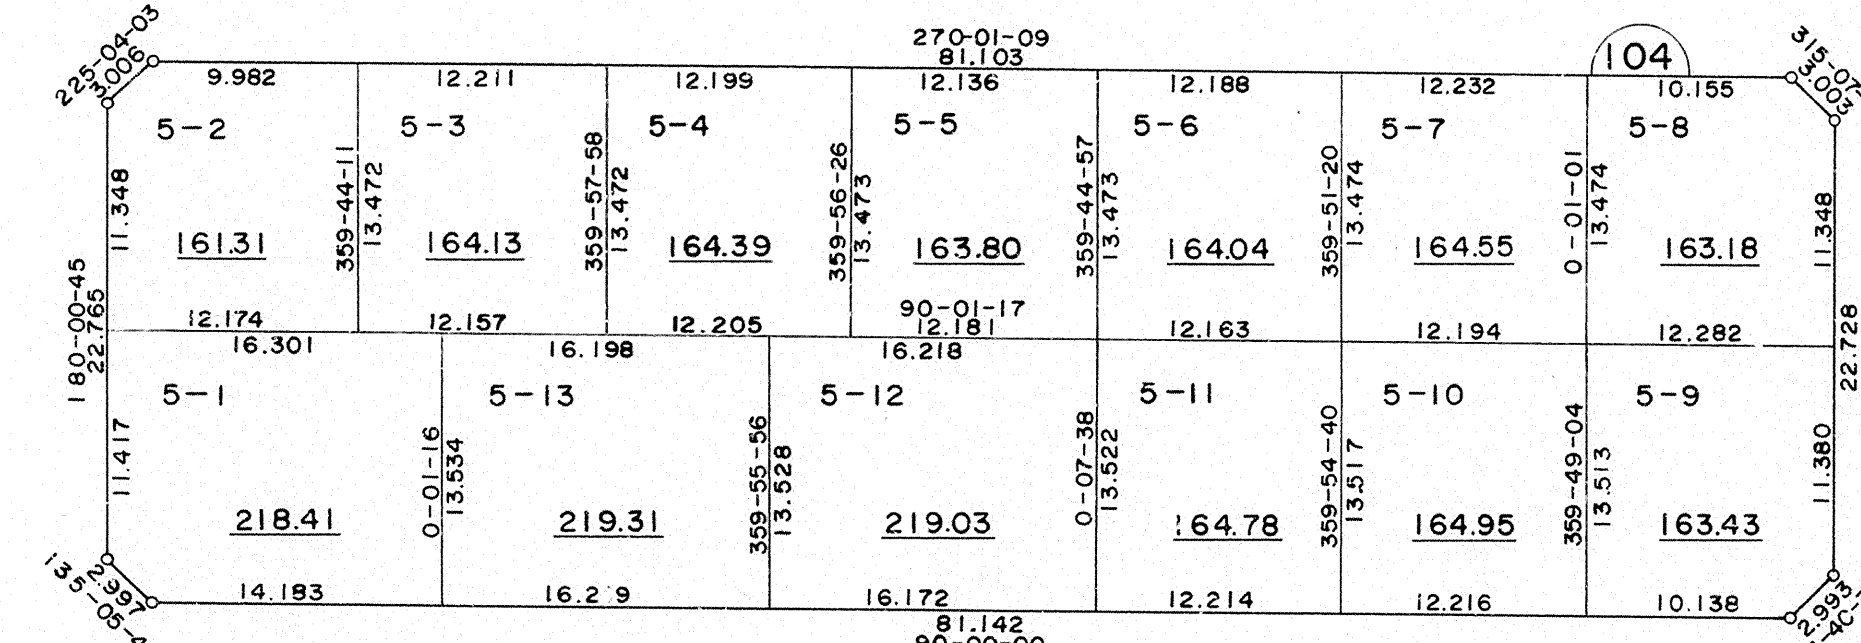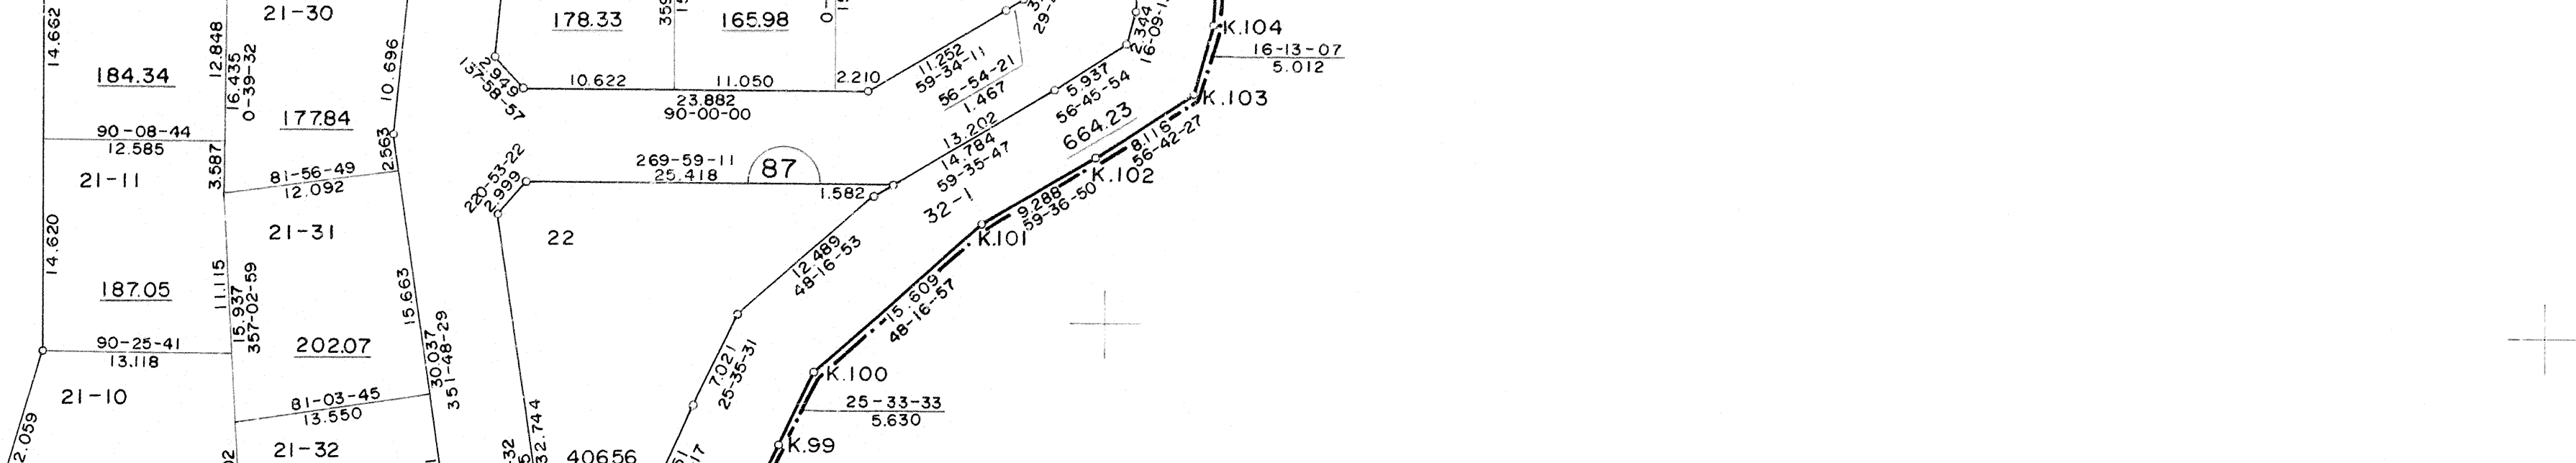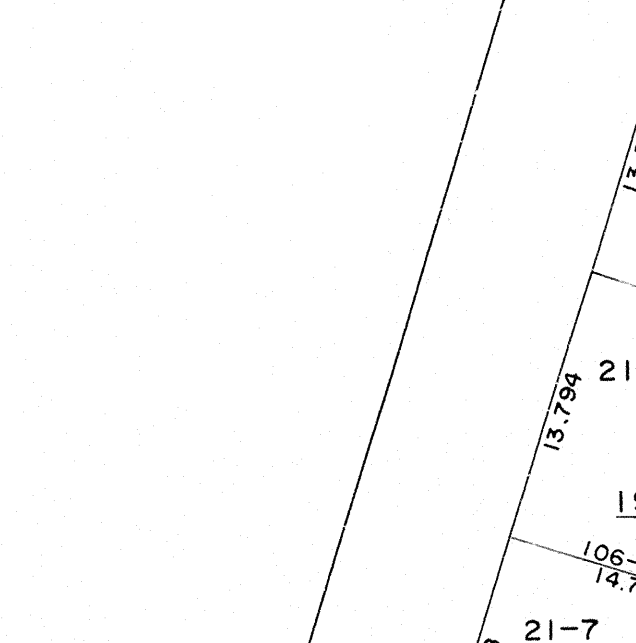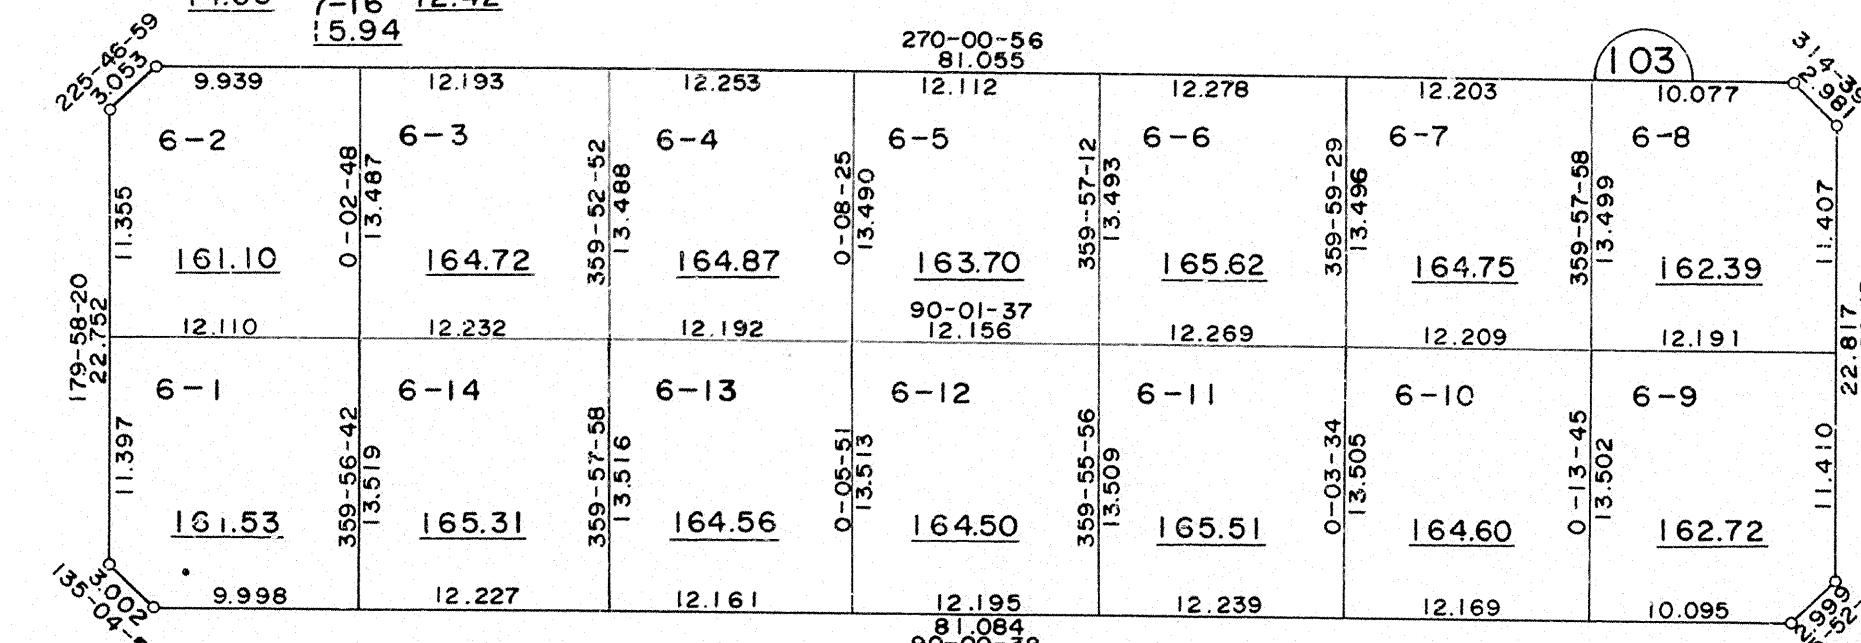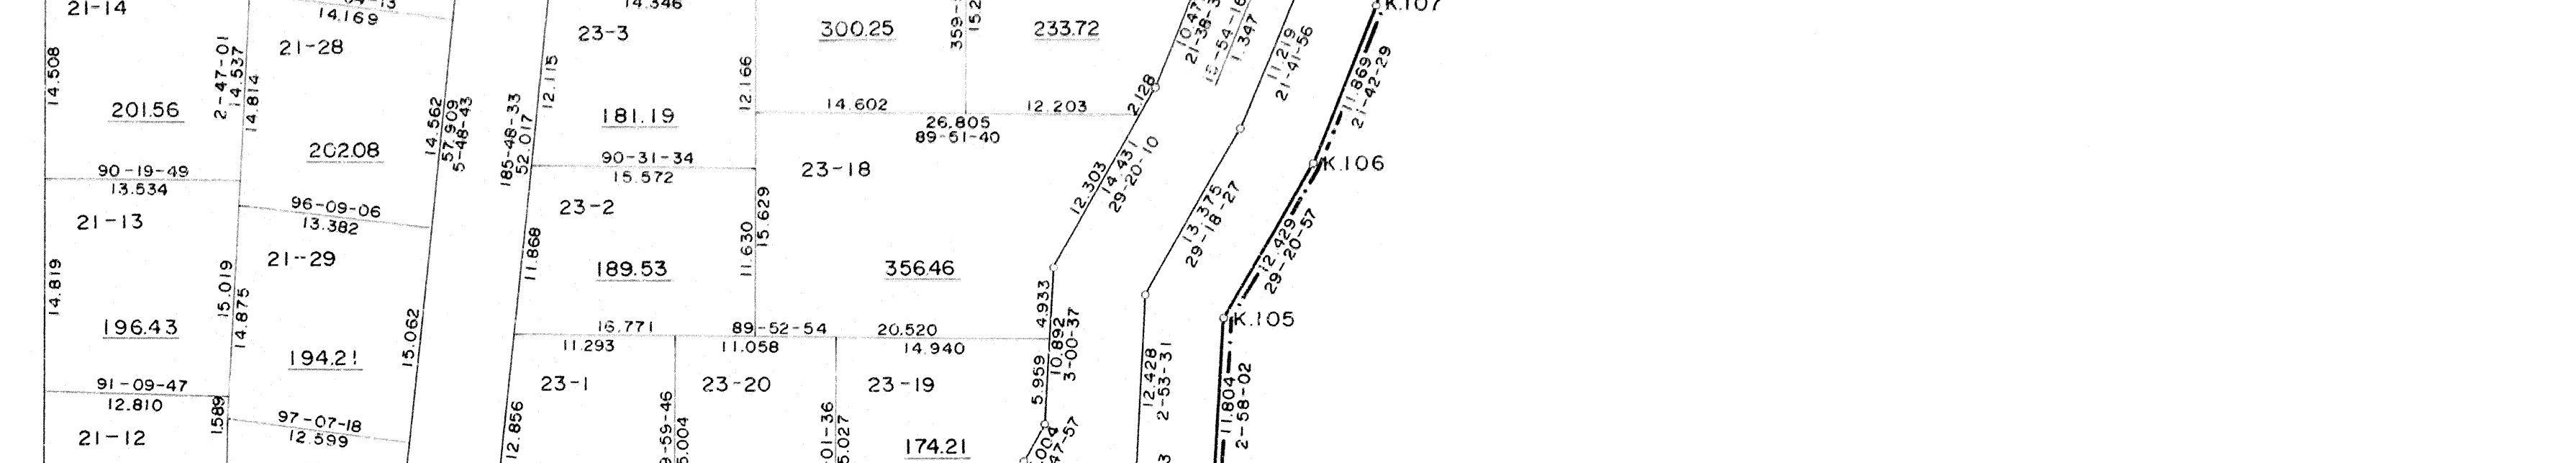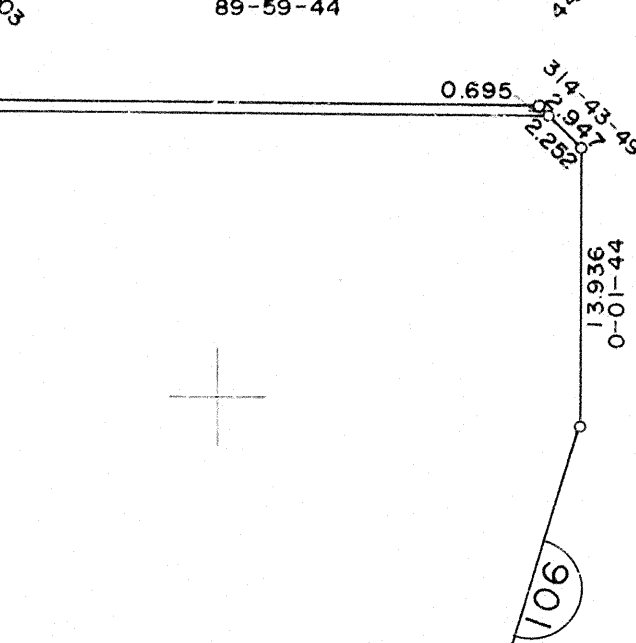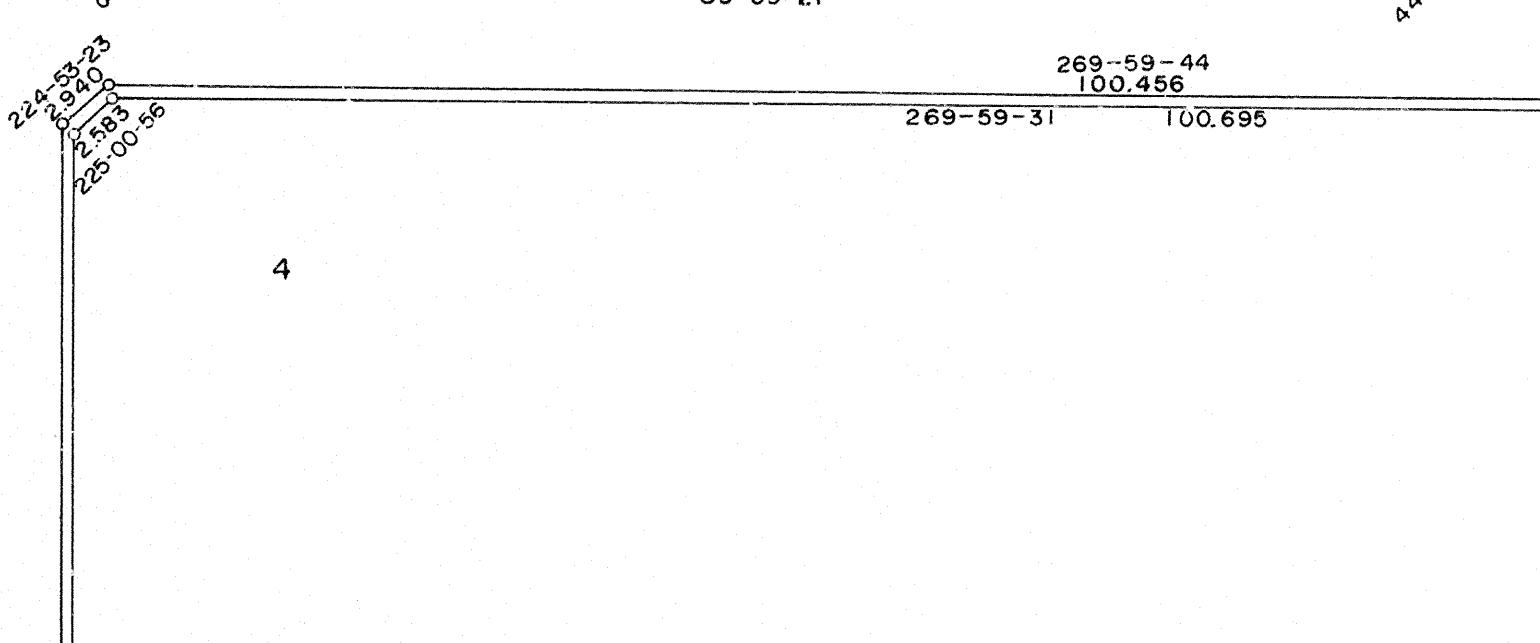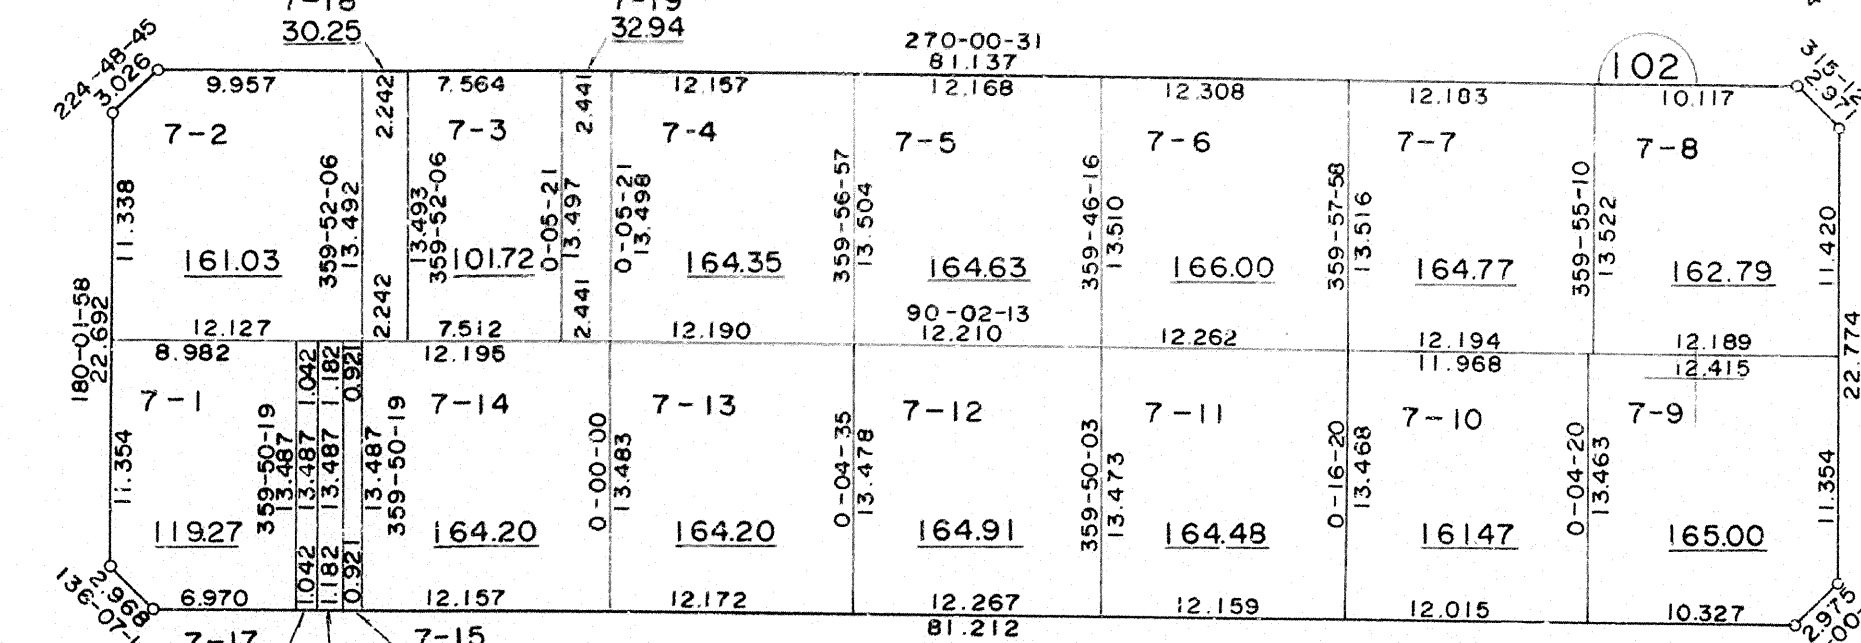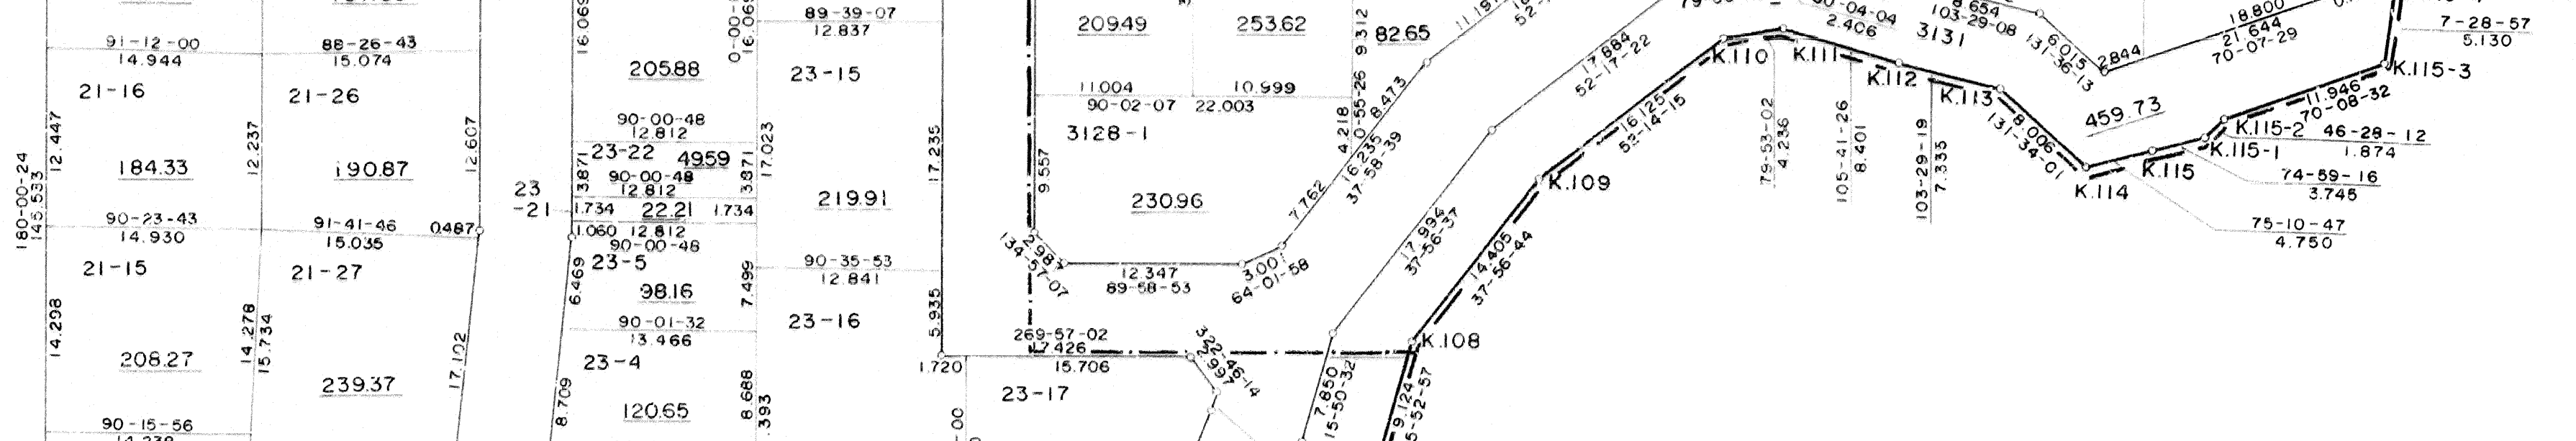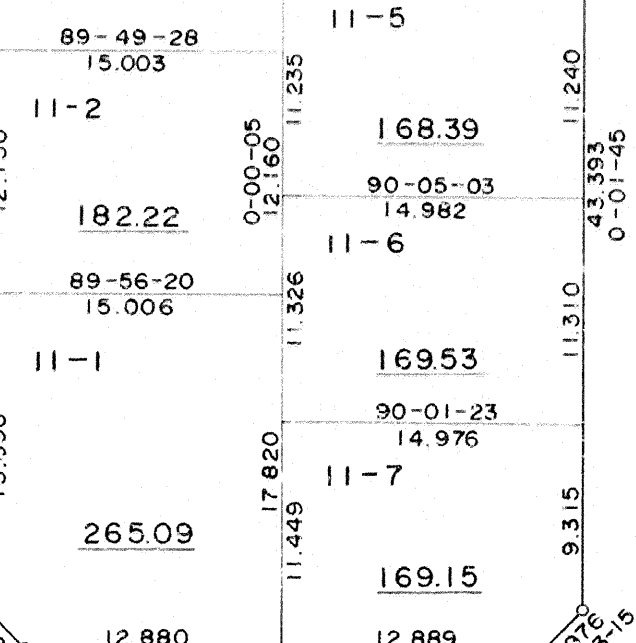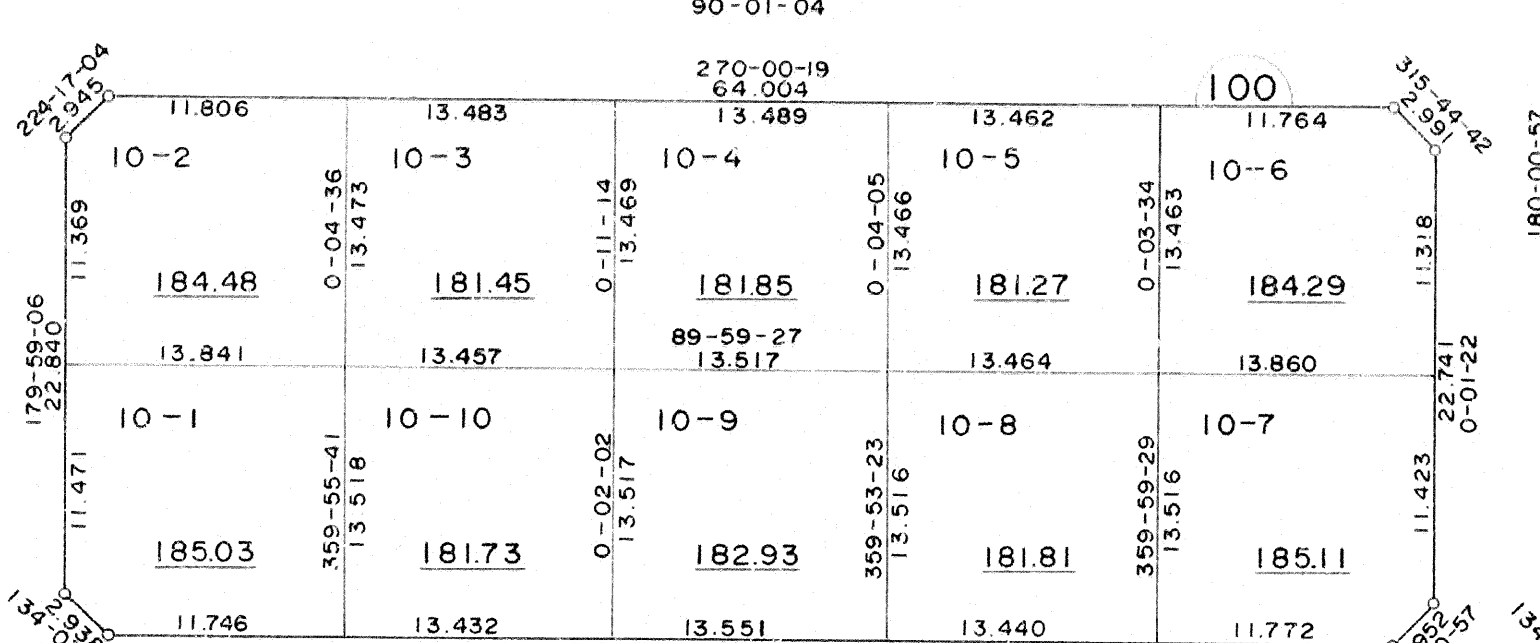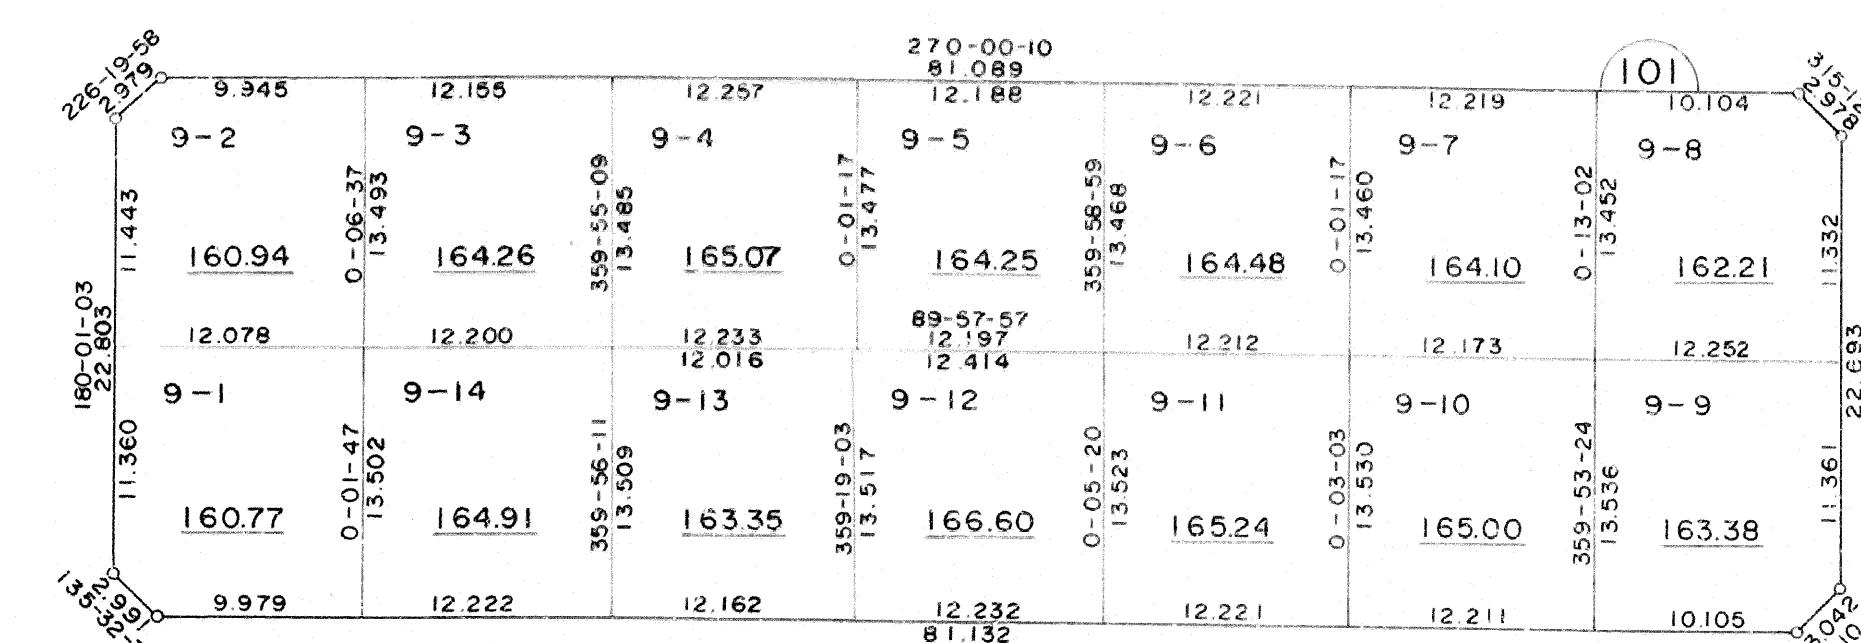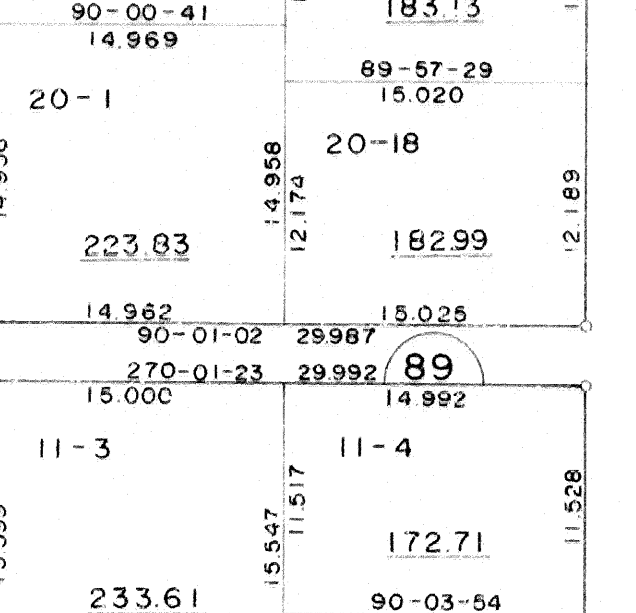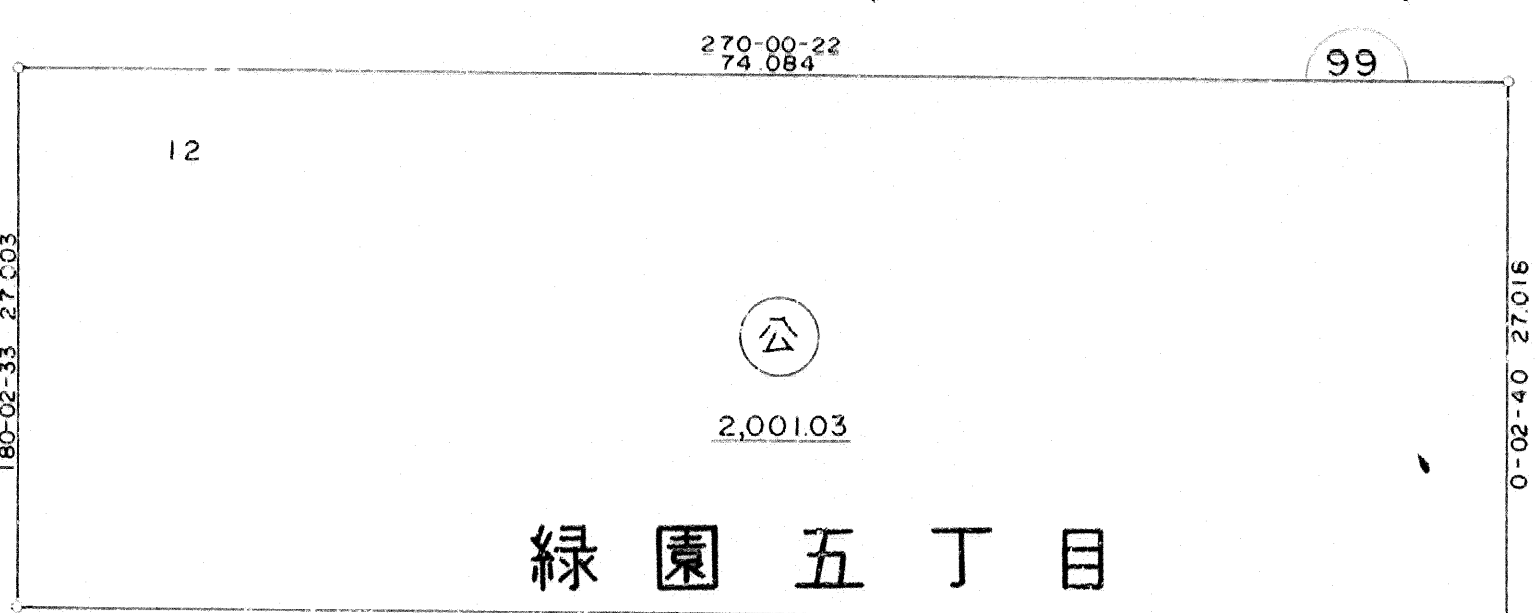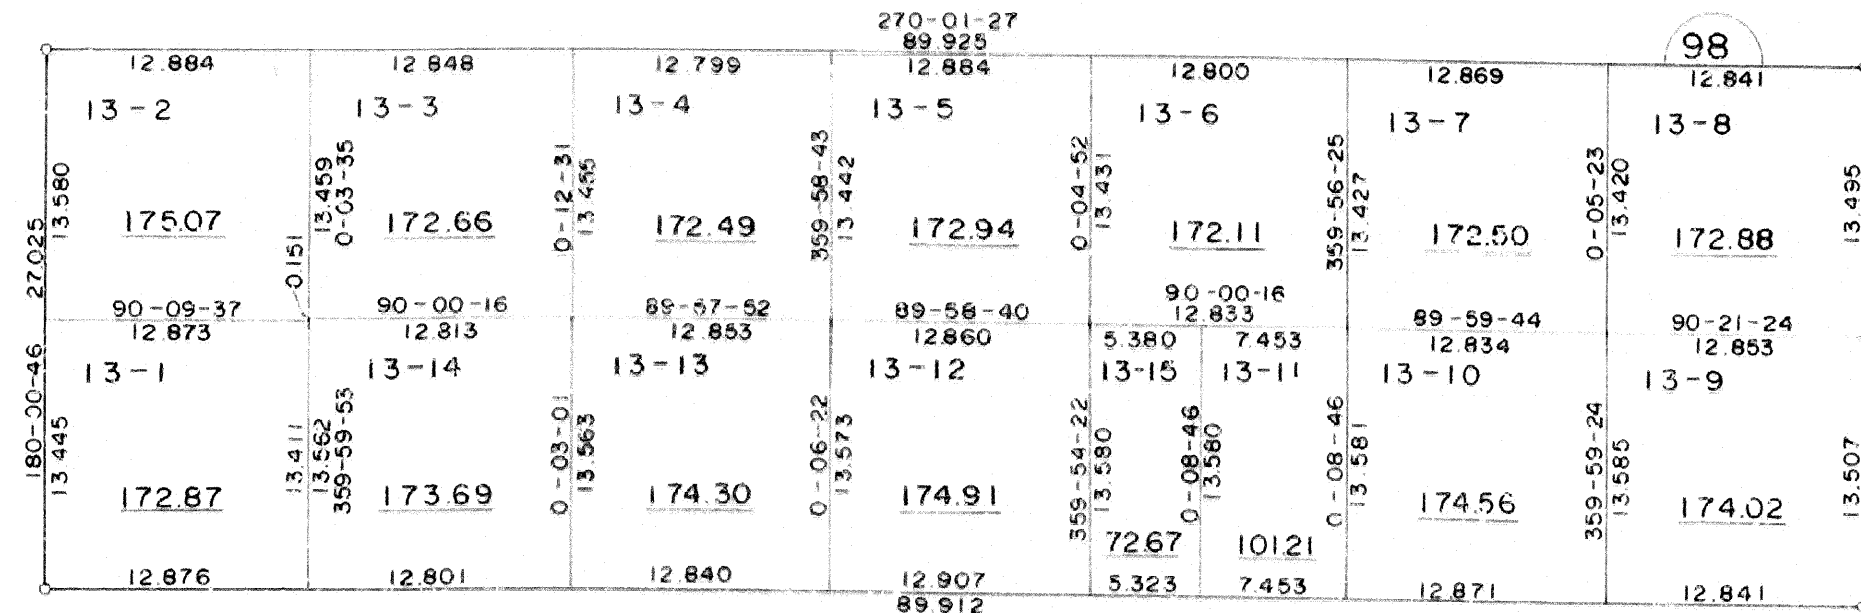

X=62300

X=62400

X=62500

Y=27500

Y=27400

Y=27300

Y=27200

